


2. "Main" Submarine Light No. 218.

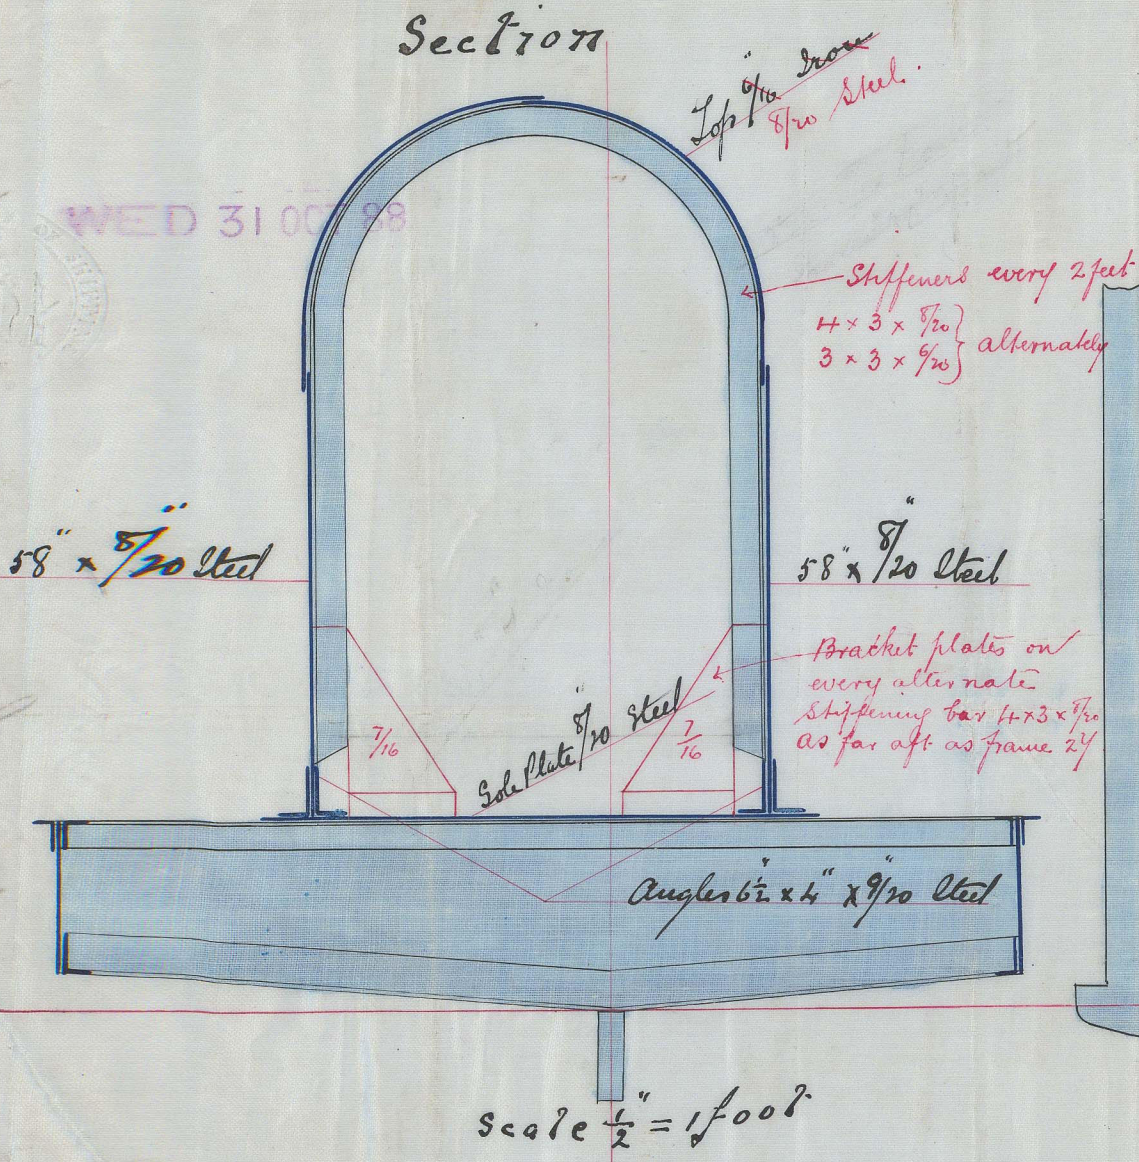


N^o 140

Sketch of Tunnel

showing Compensation of Sides and Bottom in lieu of Centre Keelson

Scale $\frac{1}{4}'' = 1'$

LONGITUDINAL ELEVATION

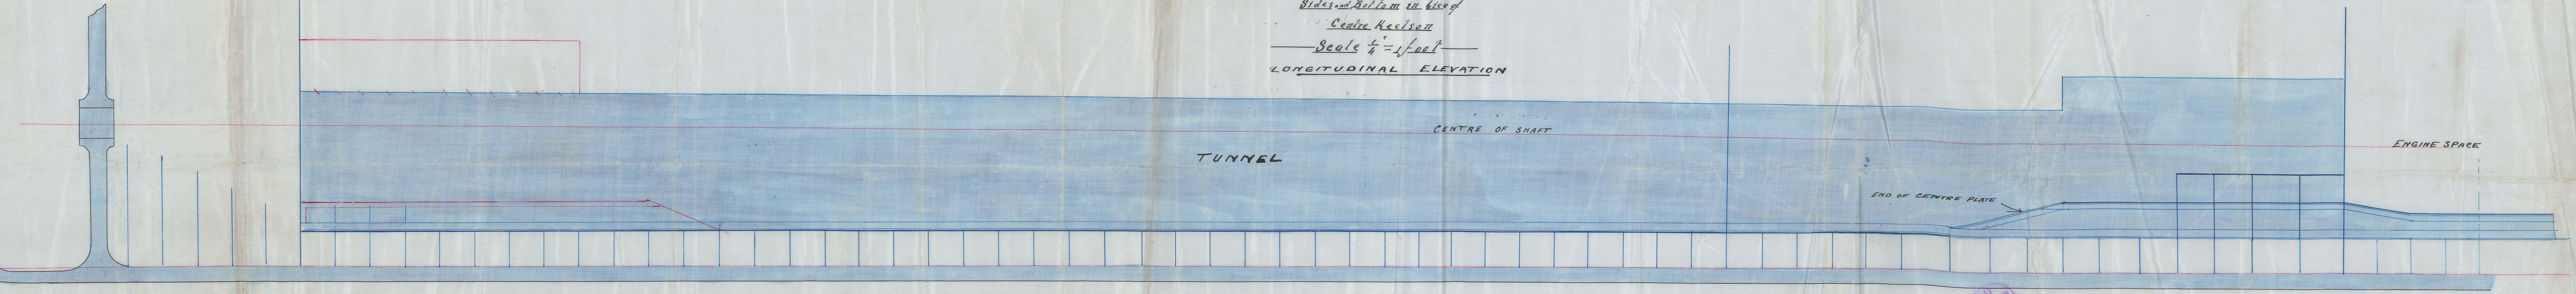

RECEIVED
25 OCT 88

ATTEN & MANSEL
SHIPBUILDERS
25 OCT 88
ENGINEERS
LLOYD'S REGISTER FOUNDATION

S. S. "Meira" Glasgow Report No 9518.

8800-912575

W. C. C. C.

Lloyd's Register
Foundation











Nº 146



© 2021
Lloyd's Register
Foundation