



Steel S.S. Mira

S.S. No 140

Main Deck Doubling  
in way of Extra Coal Hatches

Scale  $\frac{1}{4}" = 1 \text{ foot}$

Doubling Plates  $\frac{3}{16}$  Steel

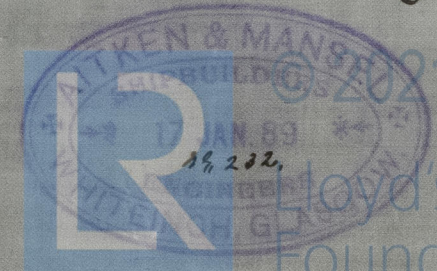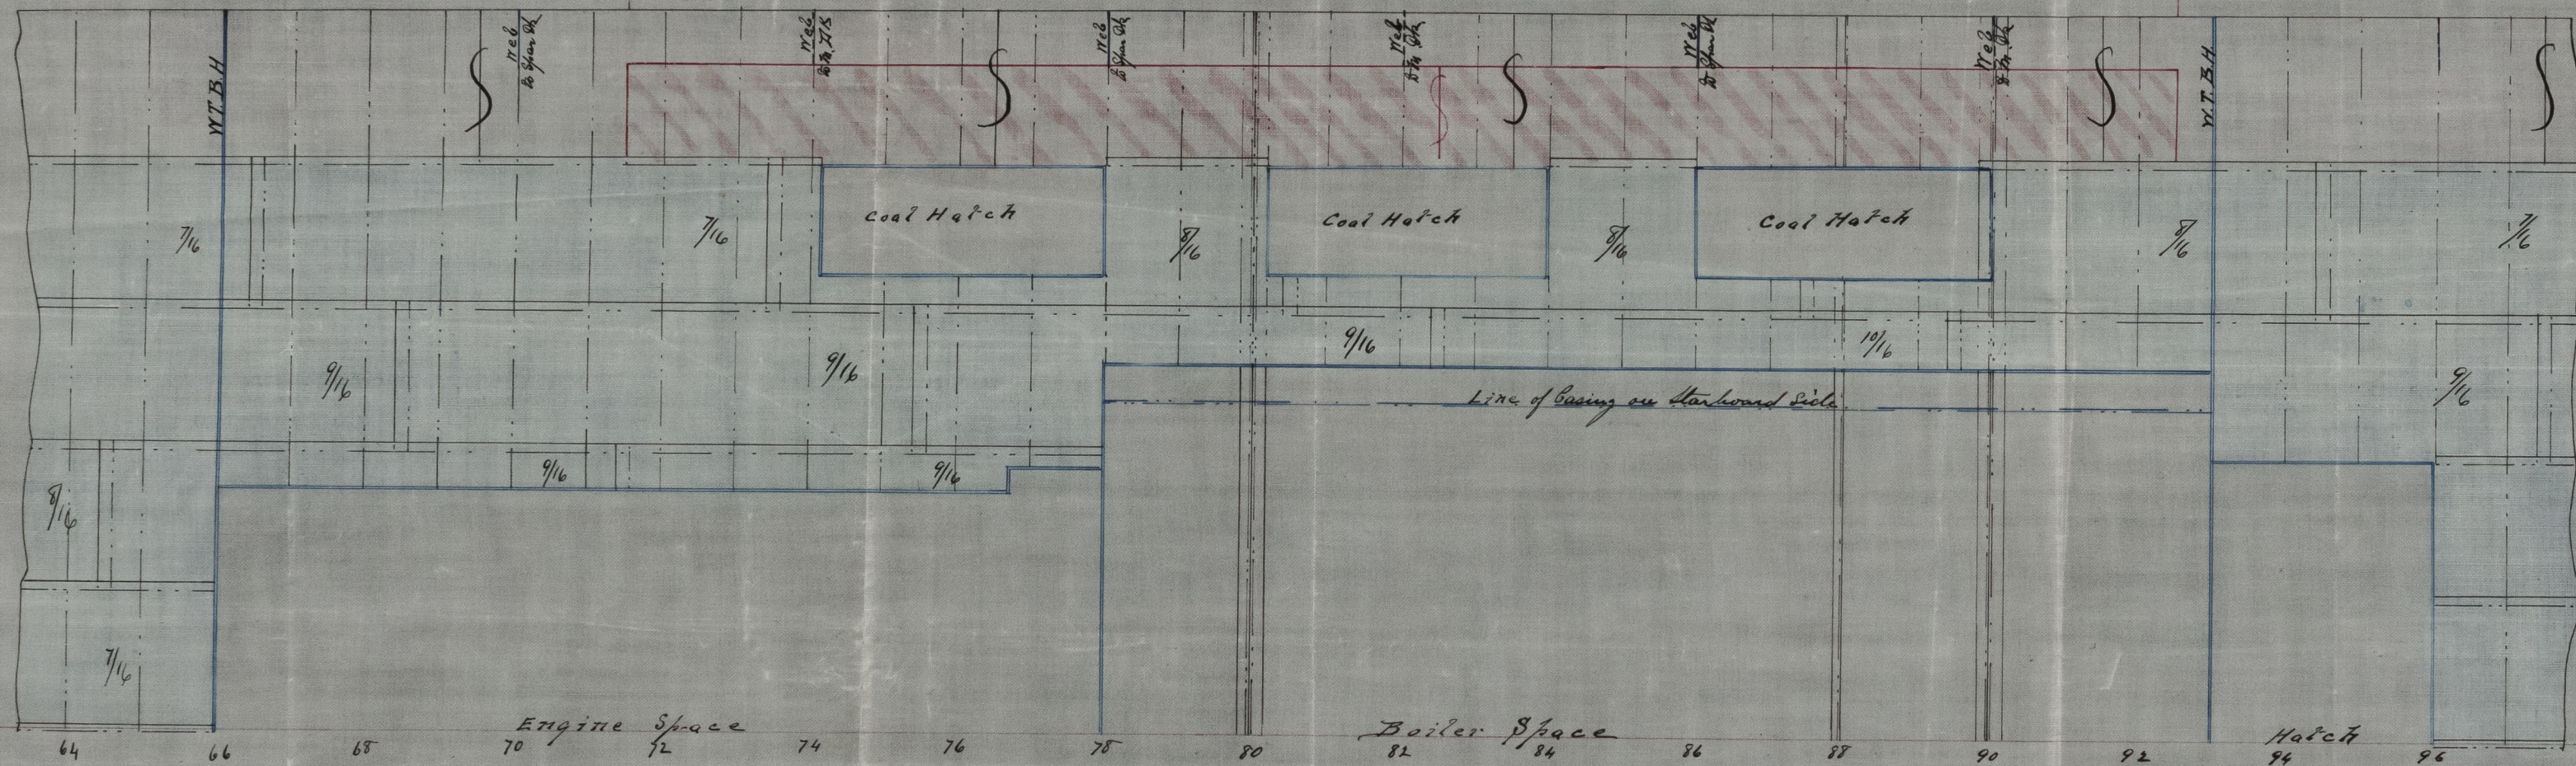

S.J. 29/4/89



Lloyd's Register  
Foundation

GLS216-0089



S. S. "Mira" Glasgow Report No 9578.-

2.2.71: 140  
Main Deck Doubling  
in way of Extra Cool Hatches  
Scale 1/4" = 1 foot  
Doubling Hatches for Steel

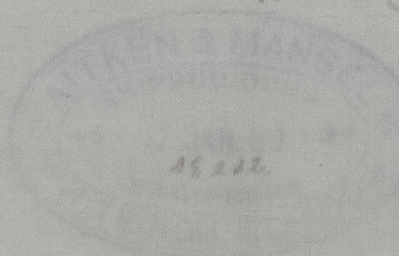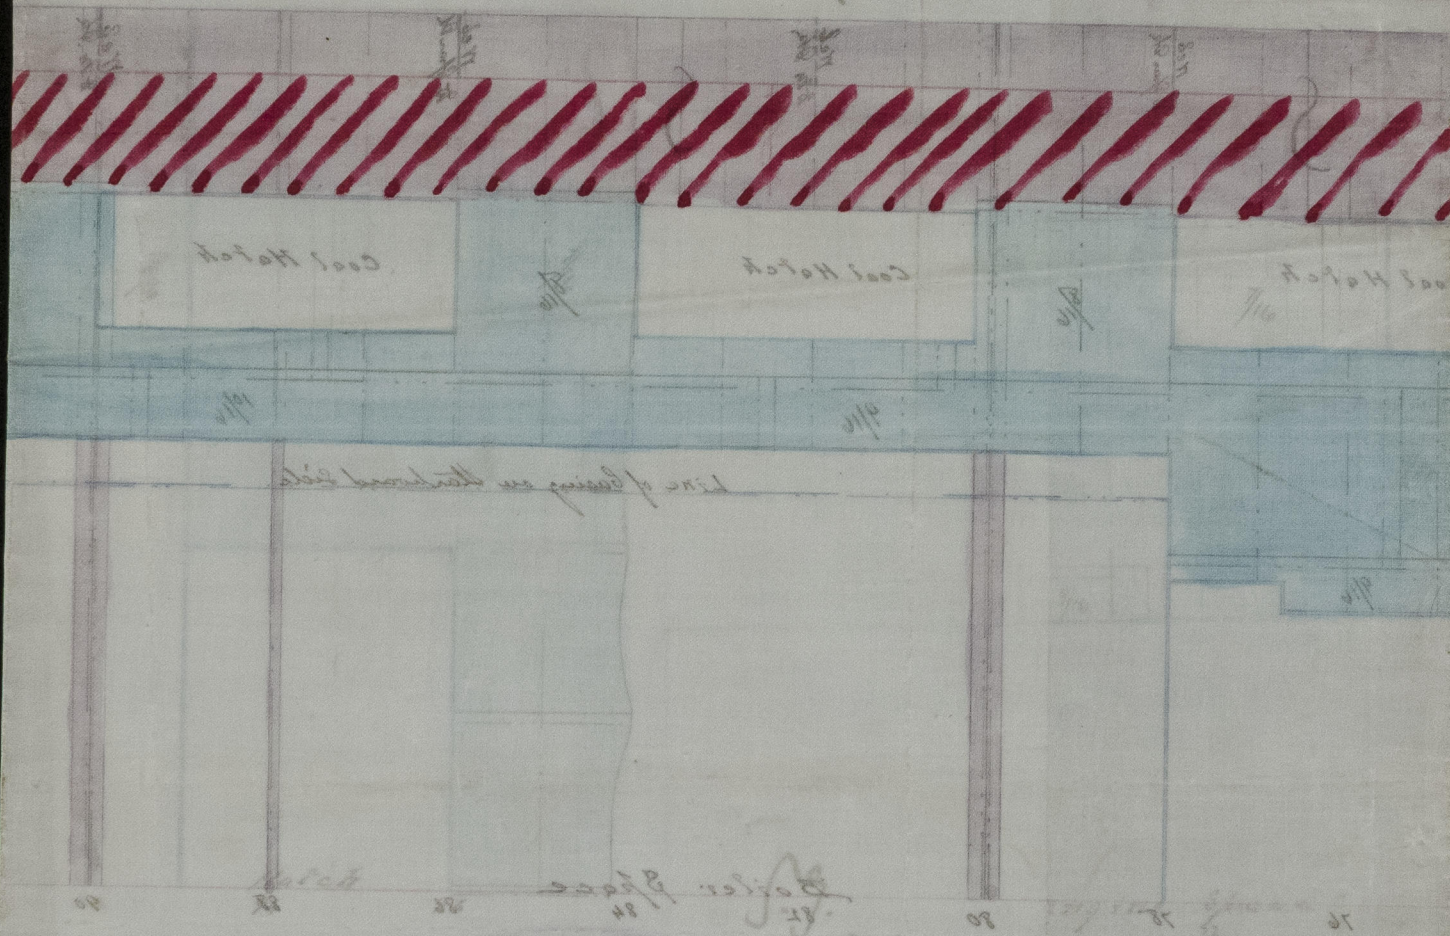

© 2021

Lloyd's Register  
Foundation

GLS216-0089