


Steel

S. S. No 140

DIMENSIONS 350 x 40 x 28 FLOORS

CLASS 100 A SPAR DECK.

SCALE 1/2 INCH = 1 FT.

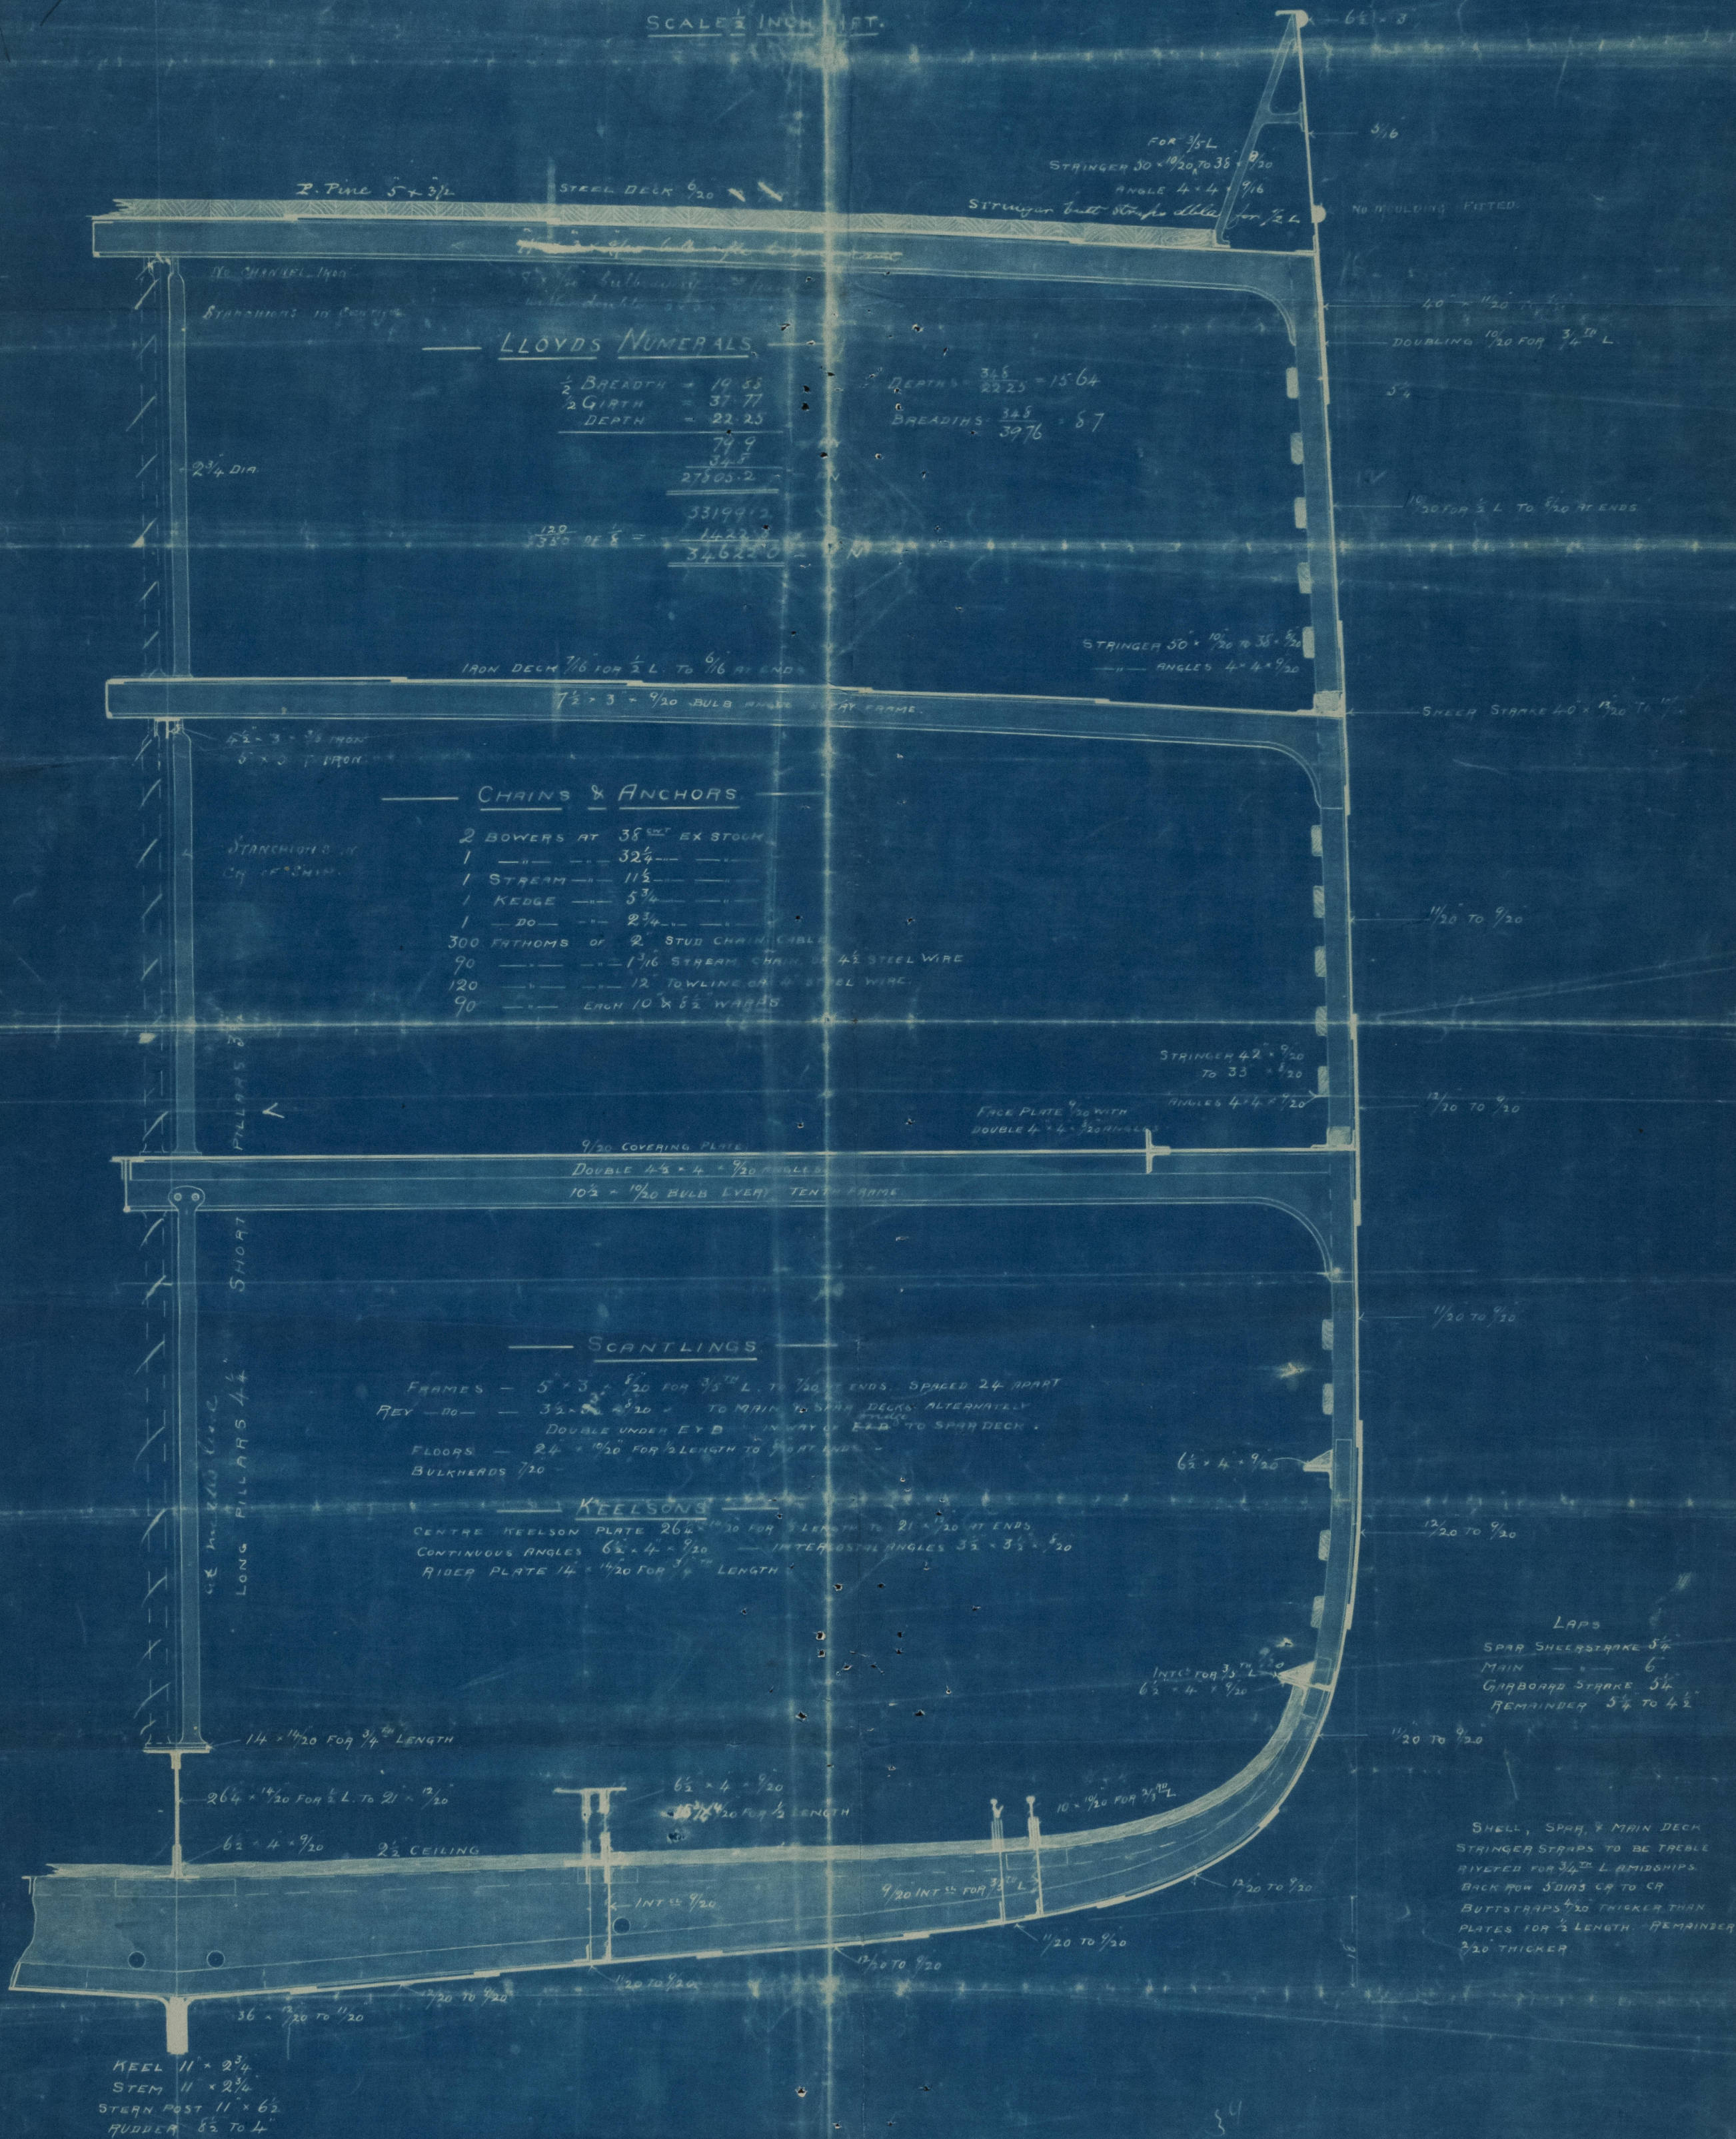

This plan to be returned to the
London Office when forwarding
the Survey Report



Lloyd's Register
of Shipping

PLS 216-0092

S. MIRA

~~GLS 9575~~

899078

GLS216-0092



© 2021

Lloyd's Reel
Foundation