
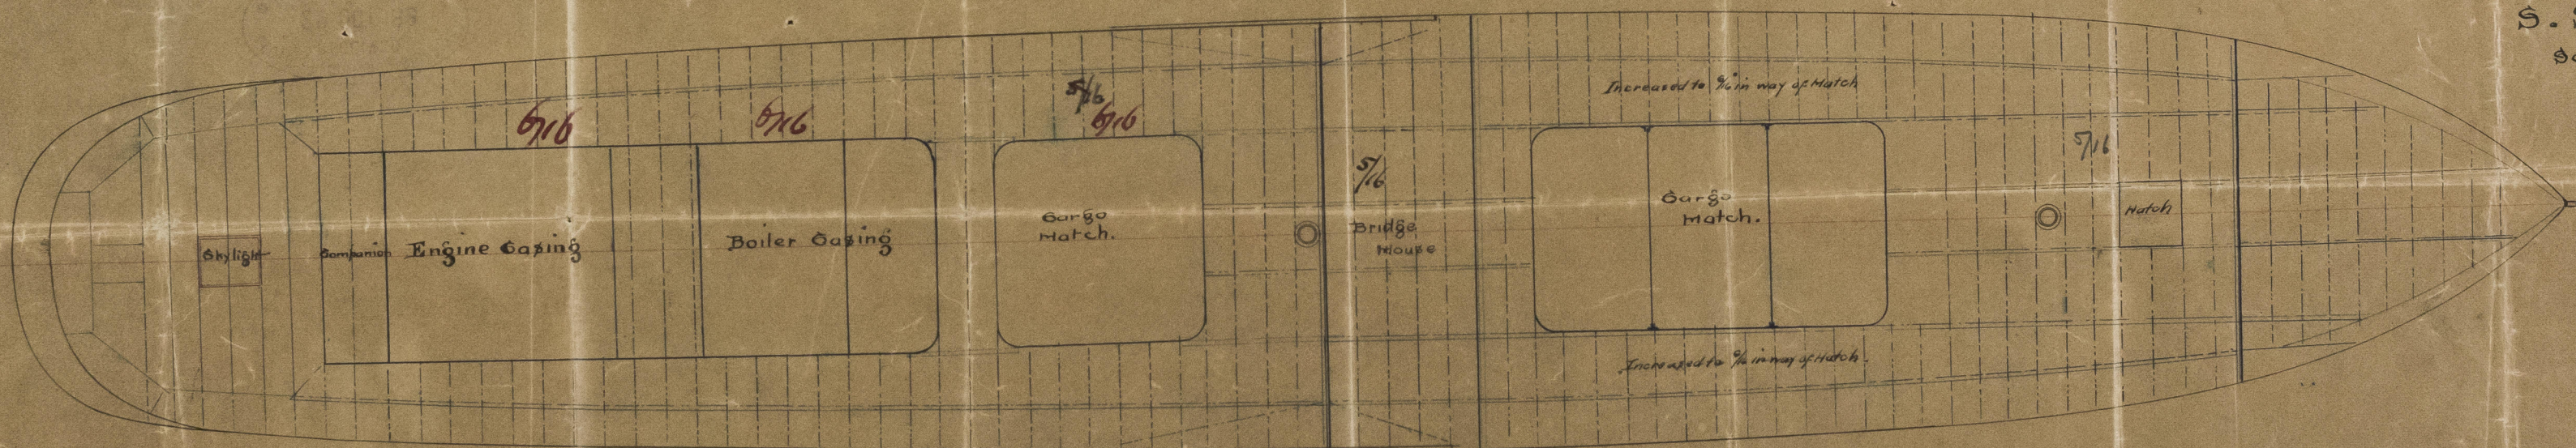


S.S. "Nugget" Glasgow Report No. 9239.

ERL 26 OCT 88

SCOTT & CO.
Shipbuilders

19/10/88.

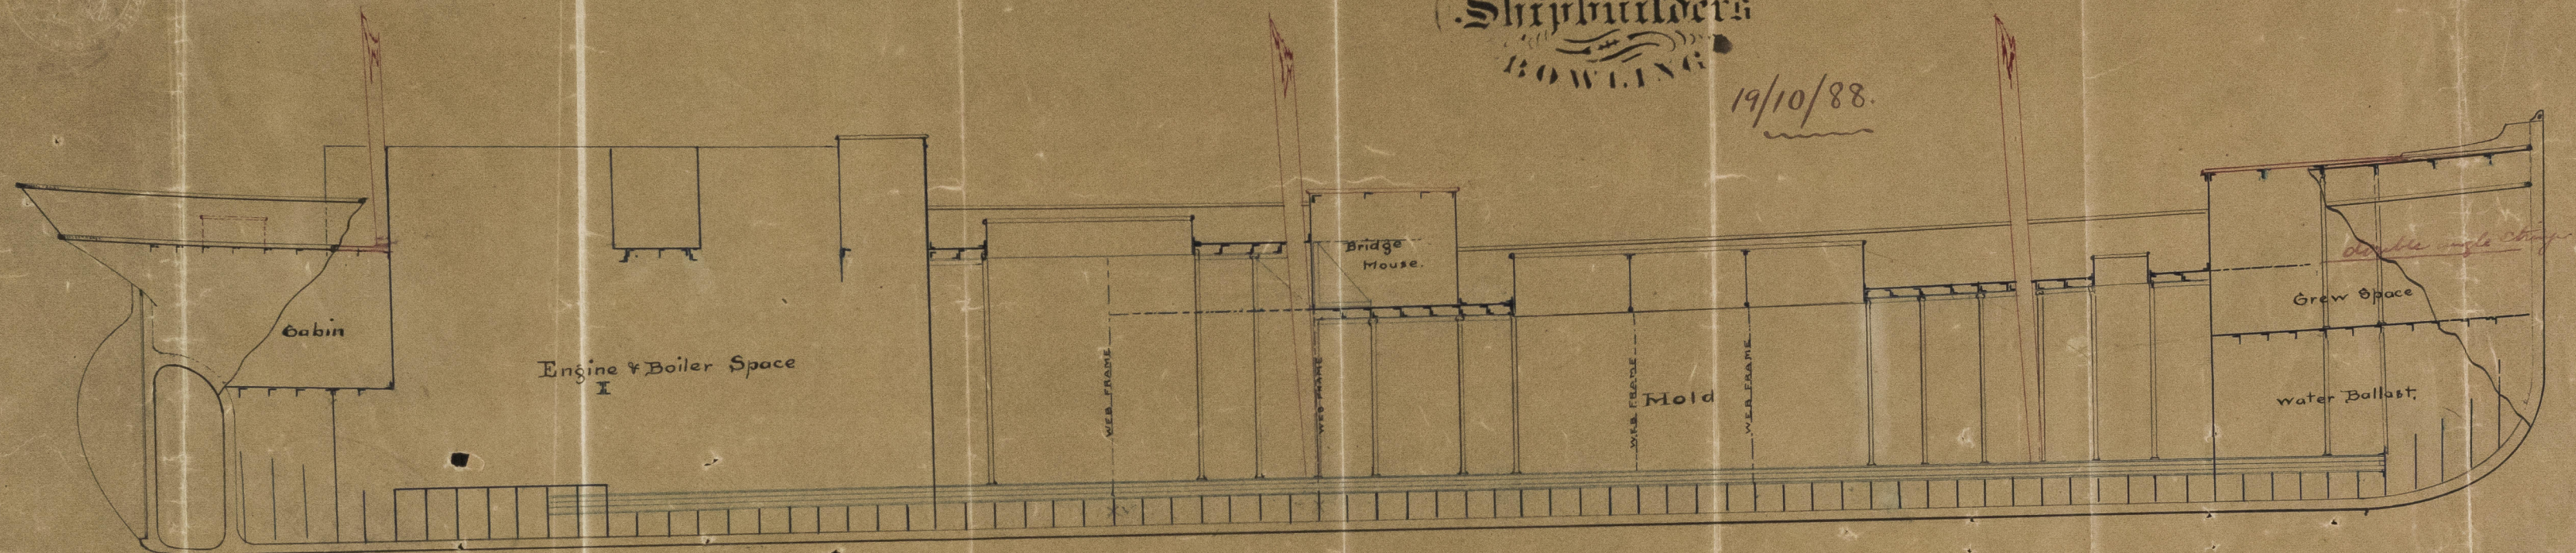

S.S. No 74+77
Scale 1/8" = One Foot.

Nugget No 74






© 2021

Lloyd's Register
Foundation

S/S Muggat-
No. 9239

S.S. "Carneliano"
C Glasgow Report
No. 9449

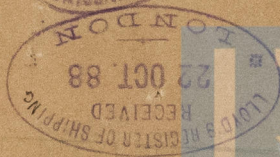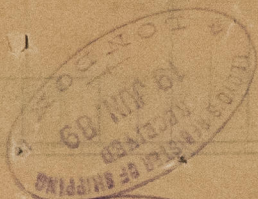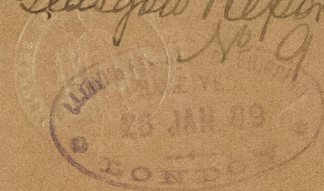

© 2021

Lloyd's Register
Foundation

GLS217-0176