

Lloyd's Register of British and Foreign Shipping.

(Report on Vessel No. 9449 Port Glasgow)

S. S. "Carnelian"

No. 2161

SHIP FORGINGS ~~OR CASTINGS~~.

The words FORGINGS or CASTINGS, IRON or STEEL, should be struck out as may be required.

I have to report that the undermentioned Iron ~~or Steel~~ Forgings ~~or Castings~~, manufactured by The Portland Forge Co of Kilmarnock for the Vessel No. 77, being built by Messrs Scott & Co of Bowling have been inspected by me as set forth below, and found to be, so far as can be seen, Sound & efficient

Mark on Forgings.


Lloyd's
No. 2161

William Hamilton

Glasgow
29/1/90

| | STERN FRAME. | RUDDER FRAME. | STEM. |
|--------------------------|--------------|-------------------------------|-------|
| Material* - - - - | / | <i>Scrap iron</i> | / |
| How made - - - - | | <i>Forged</i> | |
| Dimensions - - - - | | <i>4 1/2" dia</i> | |
| Progress on Inspection - | | <i>Forging & smithing</i> | |
| Dates when Inspected | | <i>16/12/89. 28/1/90</i> | |

SKETCHES OF FRAMES SHEWING POSITION AND DESCRIPTION OF WELDS OF FORGINGS, OR PARTICULARS OF TESTS APPLIED TO CASTINGS.

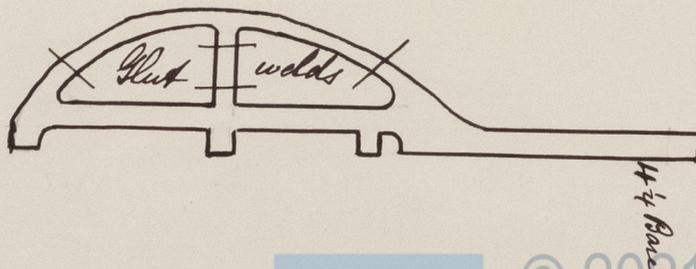

© 2021

Lloyd's Register
Foundation