


View of After end of Nos 2 & 4 Hatches on Upper Deck

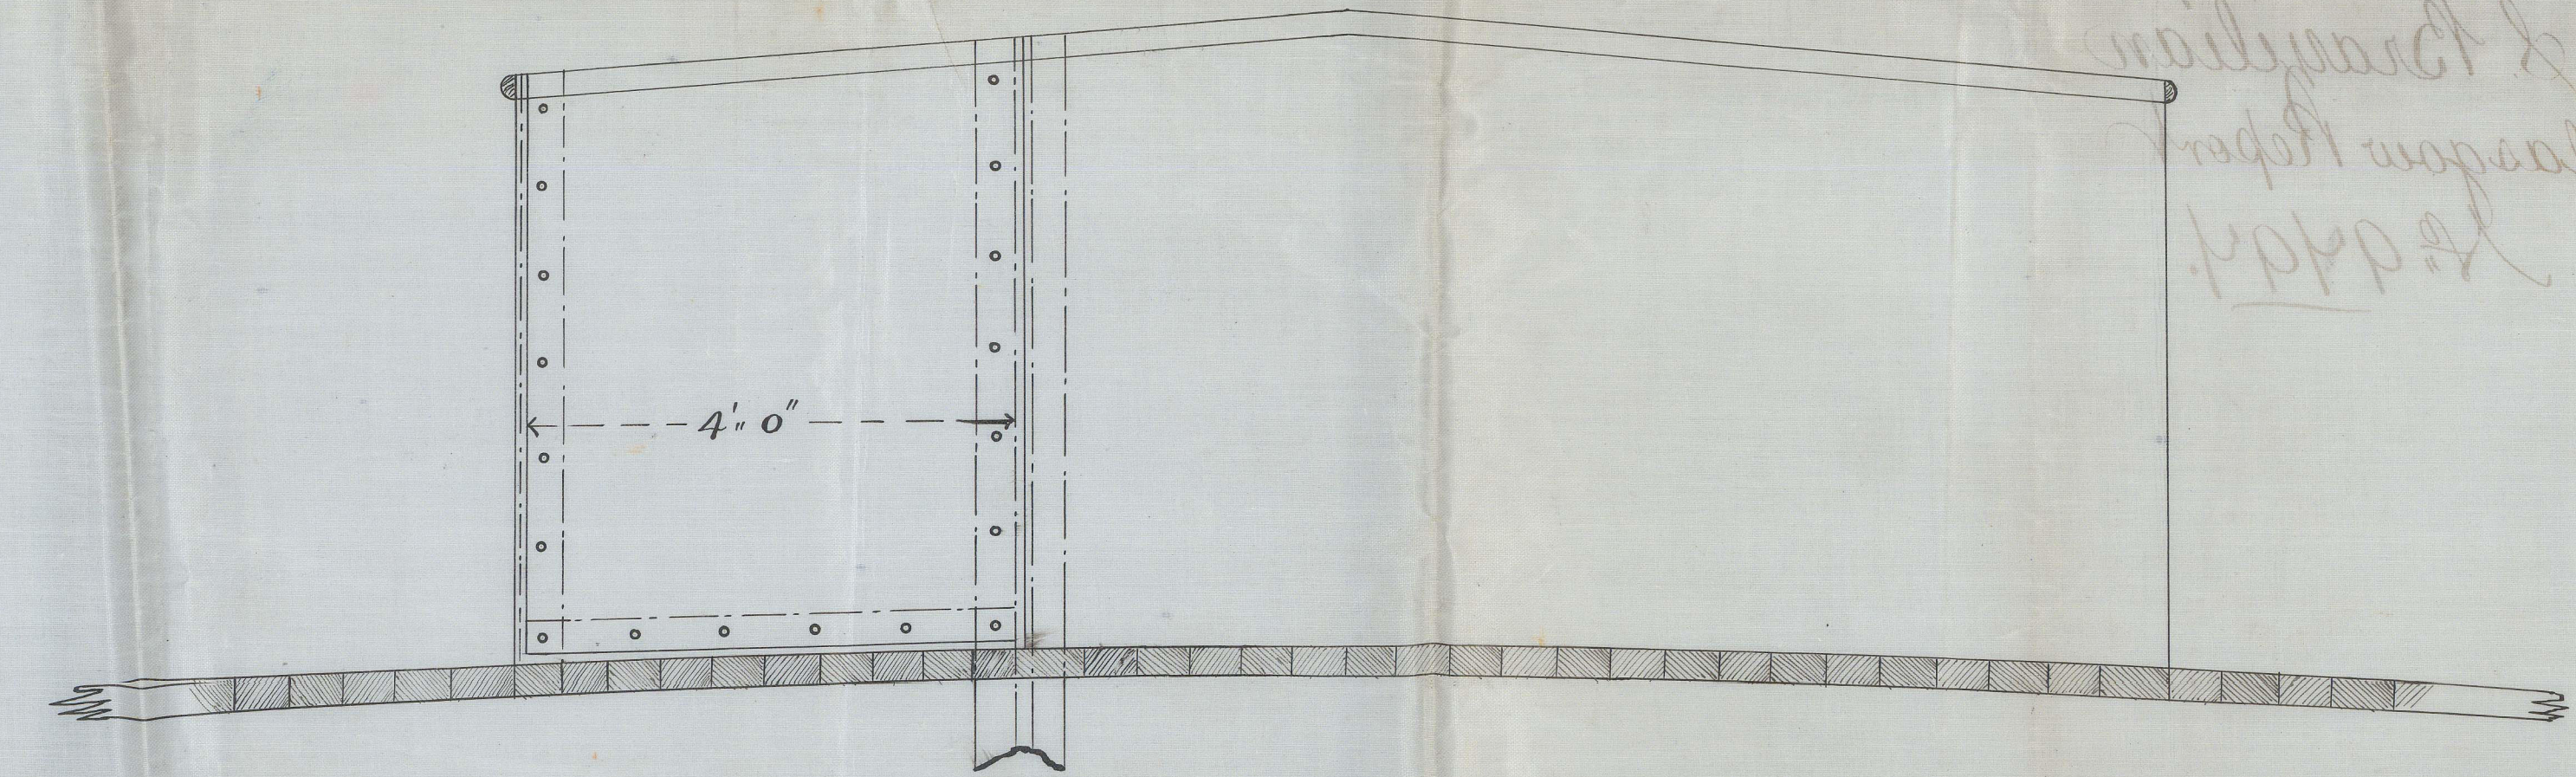


mailing & report reported  
10000


Plan of Hatches  
S.S. 346  
 $\frac{3}{4}'' = 1 \text{ foot.}$

13  
1 S.S.


Aftership view of Nos 2 & 4 Hatches on Upper Deck

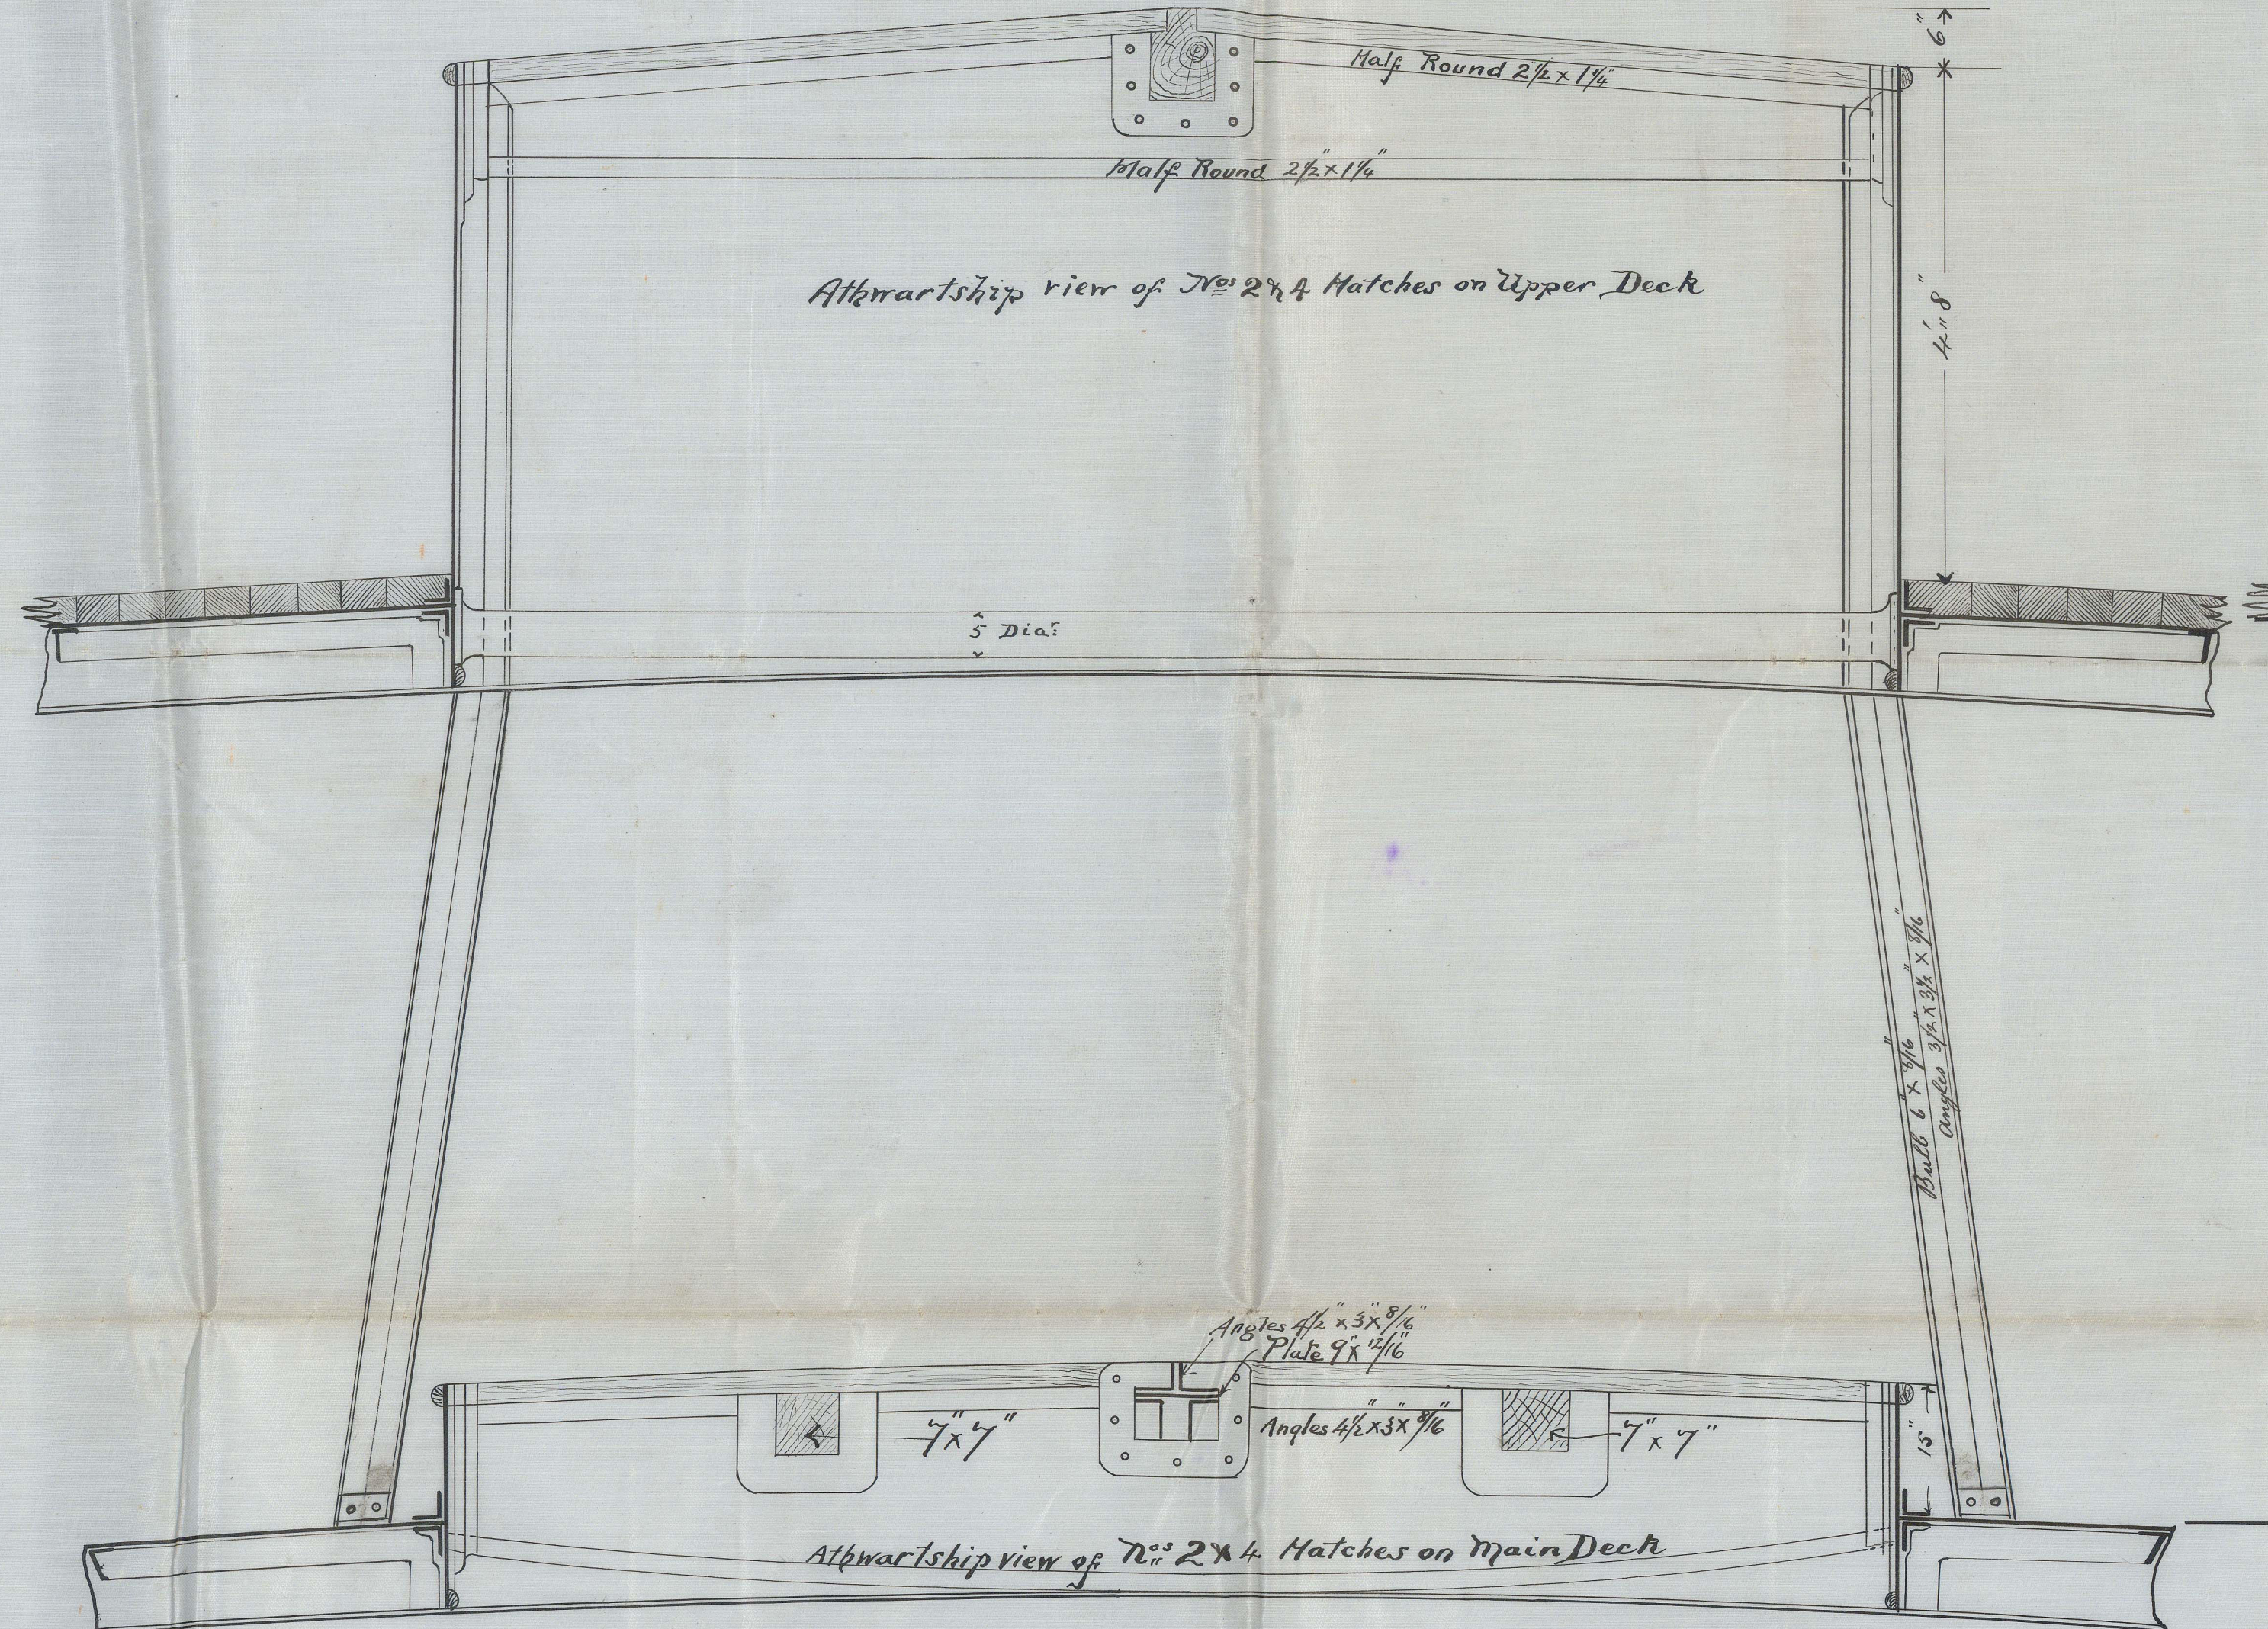


Elevation of Side of Hatches Nos 2 & 4 on Upper Deck

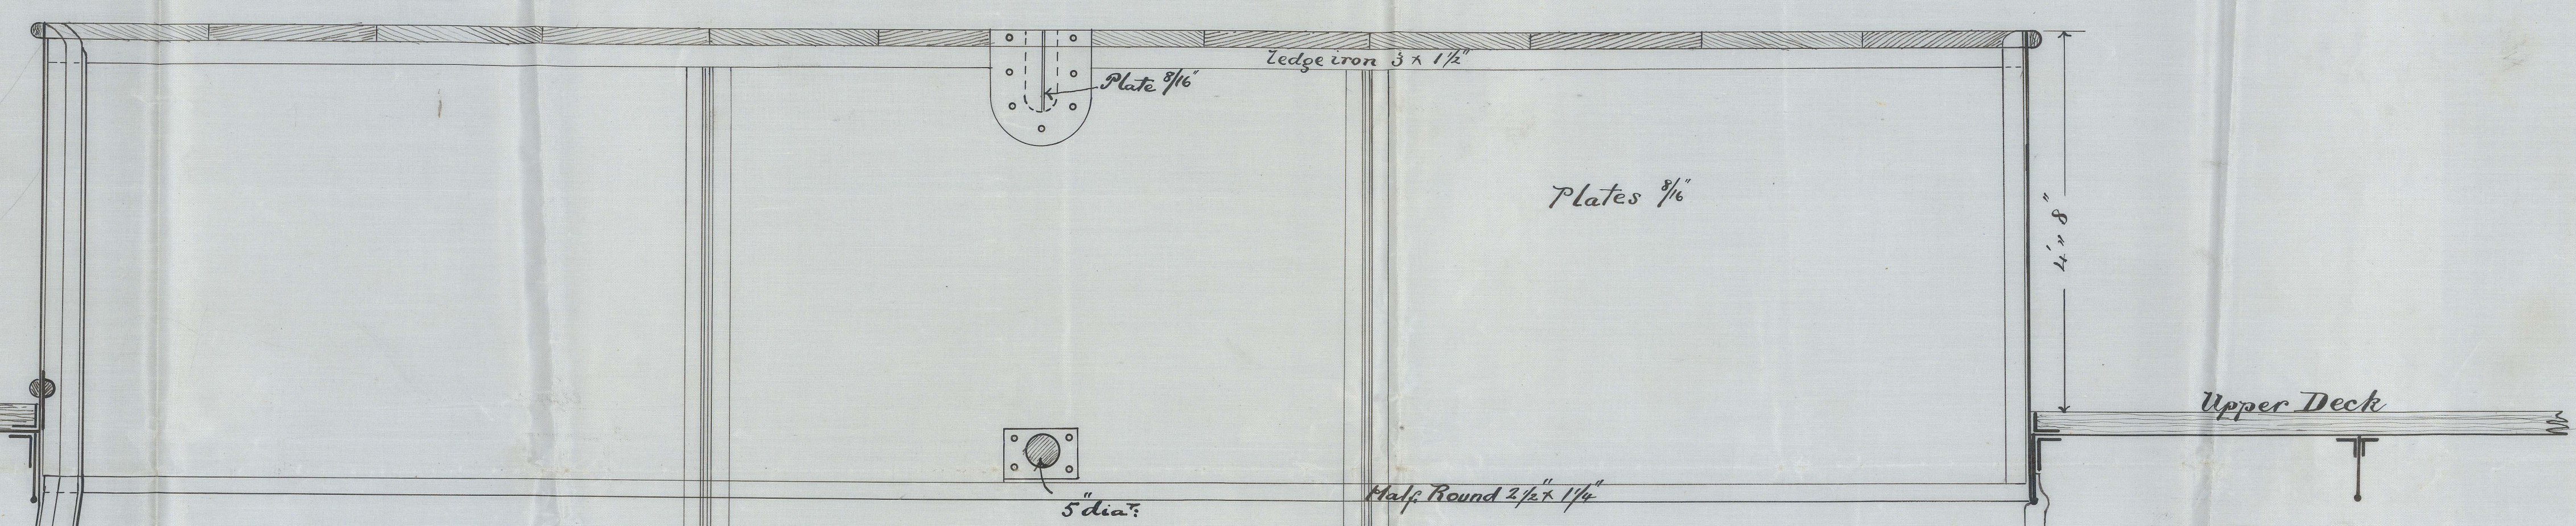

Elevation of Side of Hatches Nos 2 & 4 on Main Deck

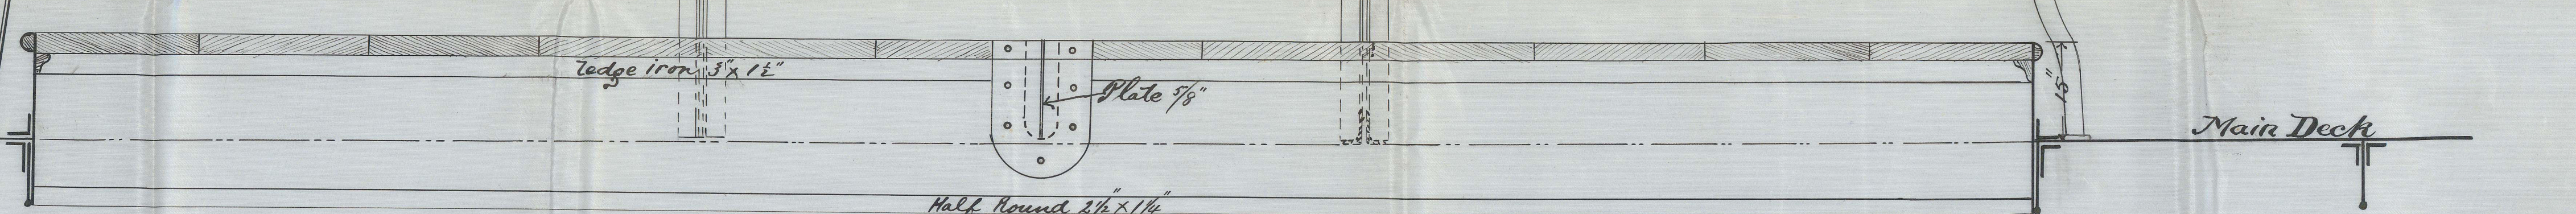


Aftership view of Nos 2 & 4 Hatches on Main Deck

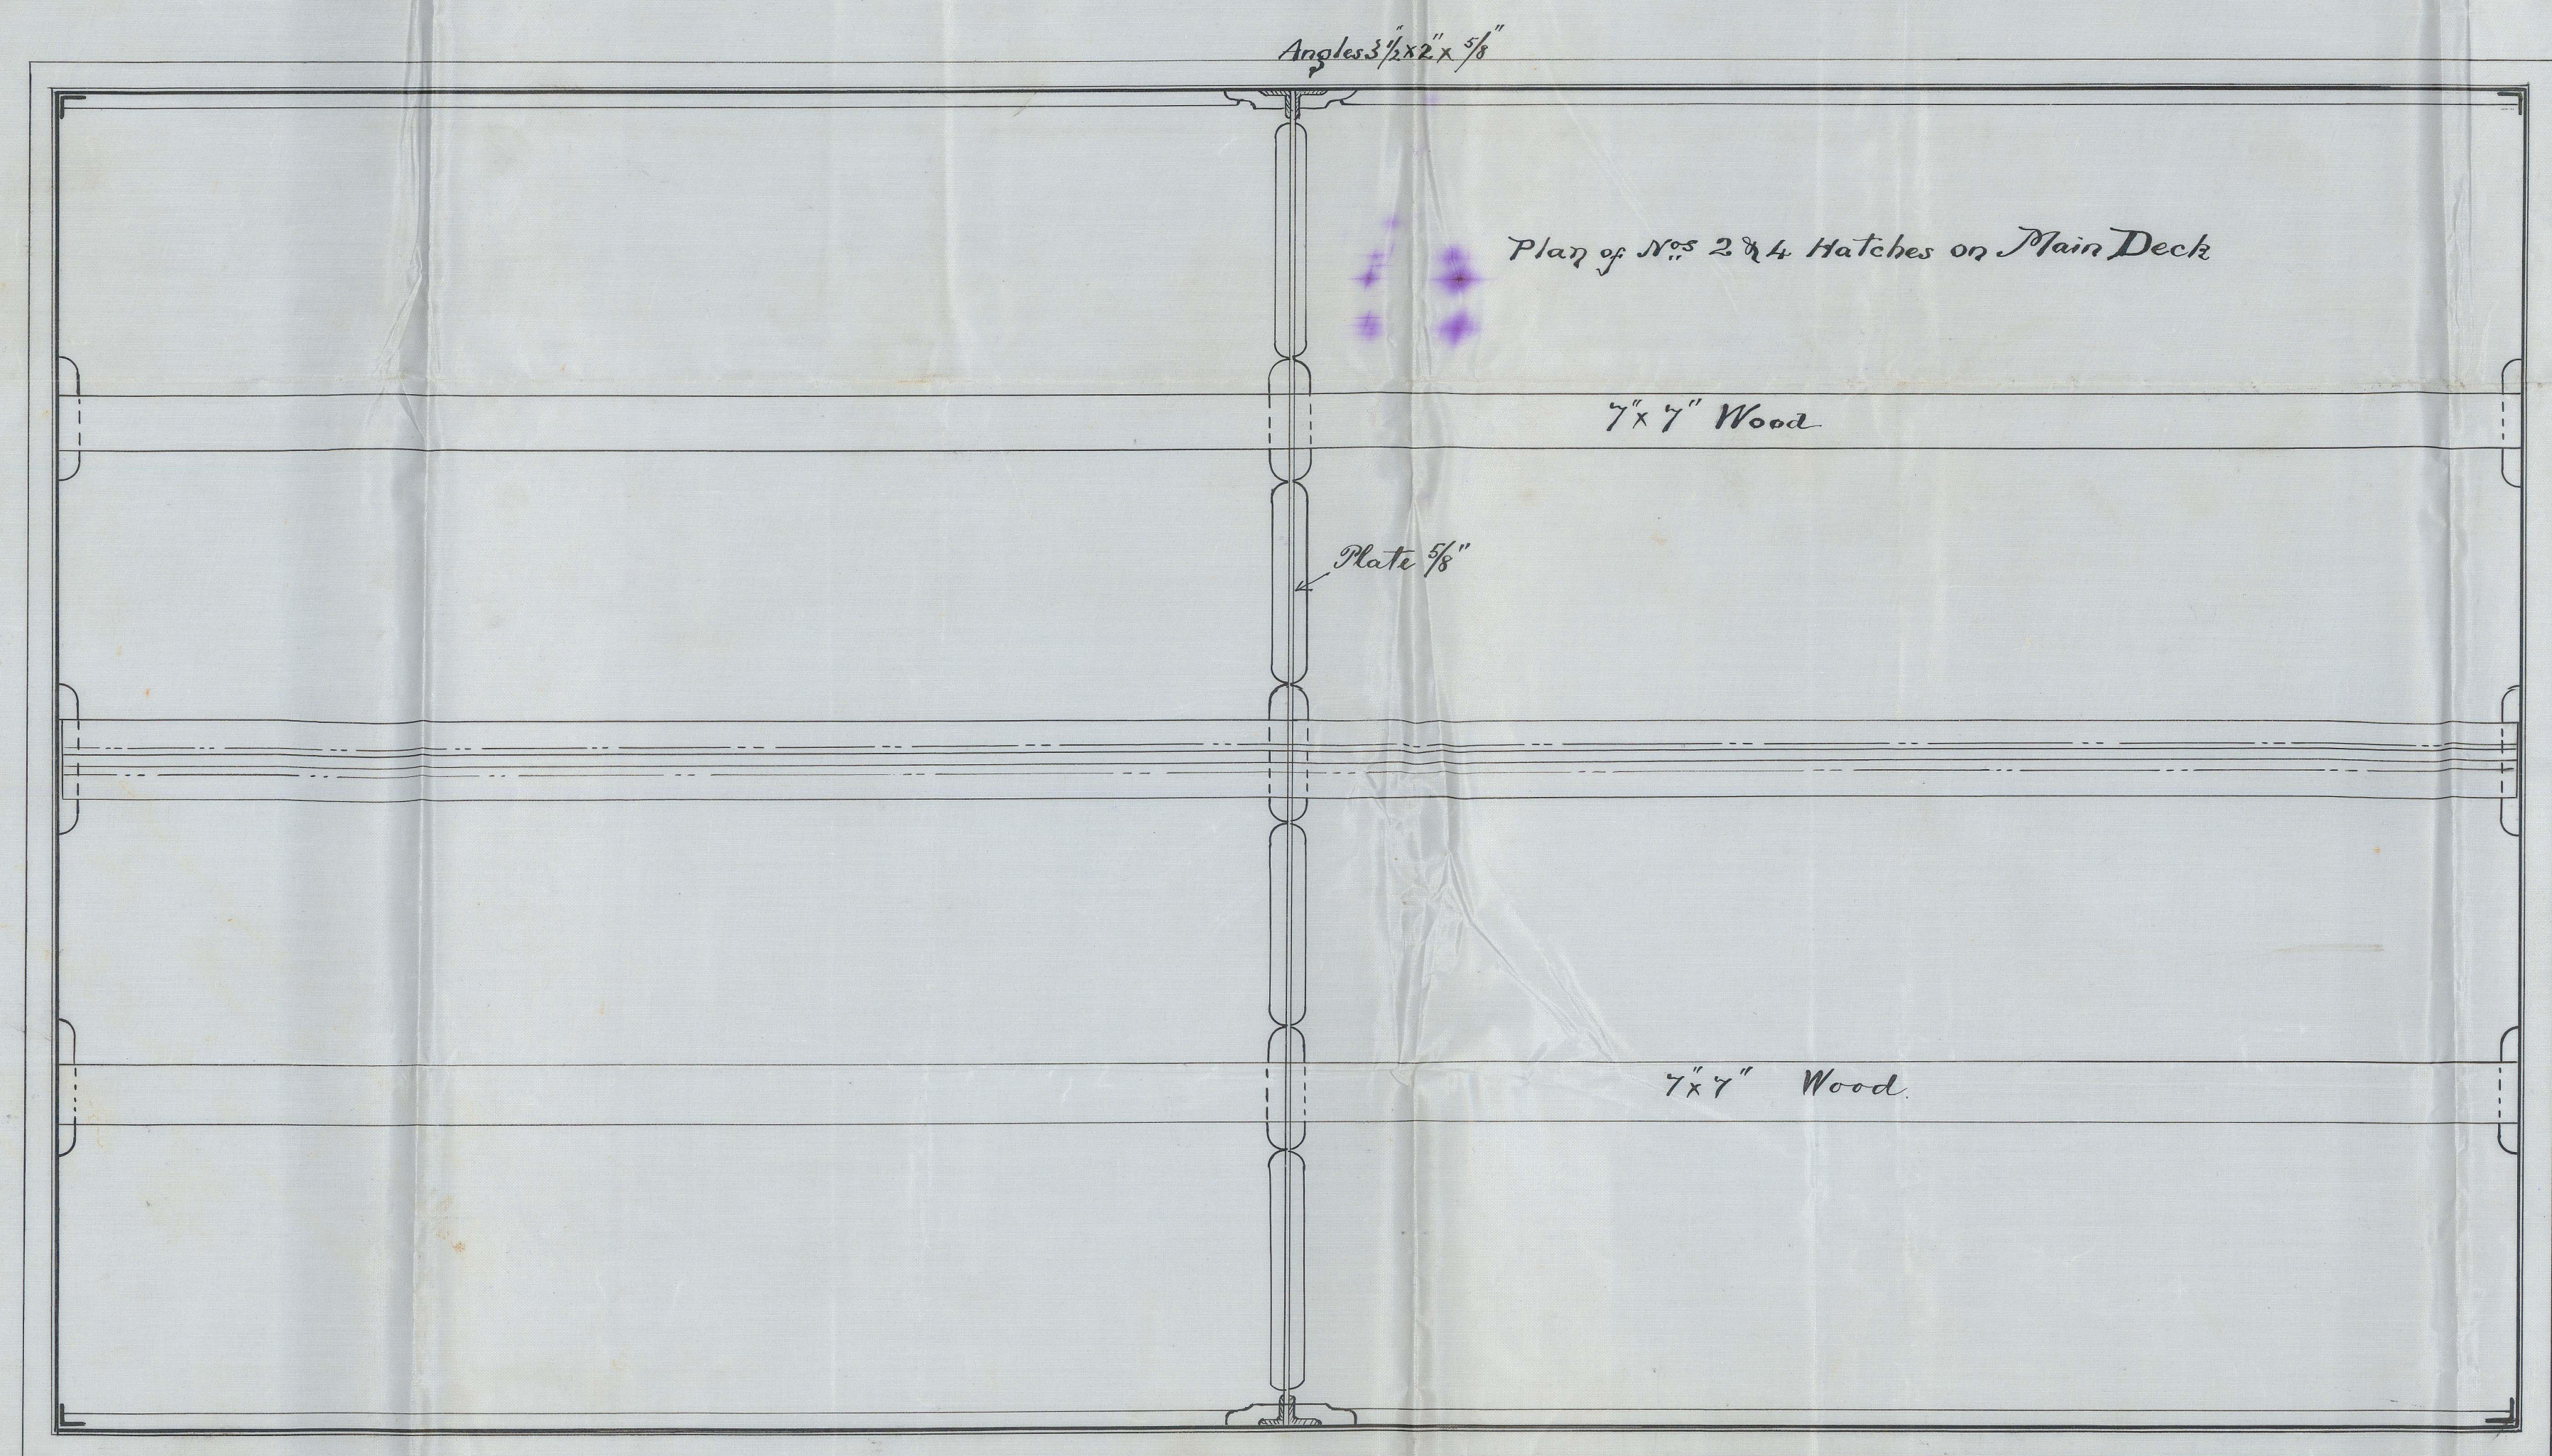

Plan of Nos 2 & 4 Hatches on Main Deck

Plan of Nos 2 & 4 Hatches on Upper Deck

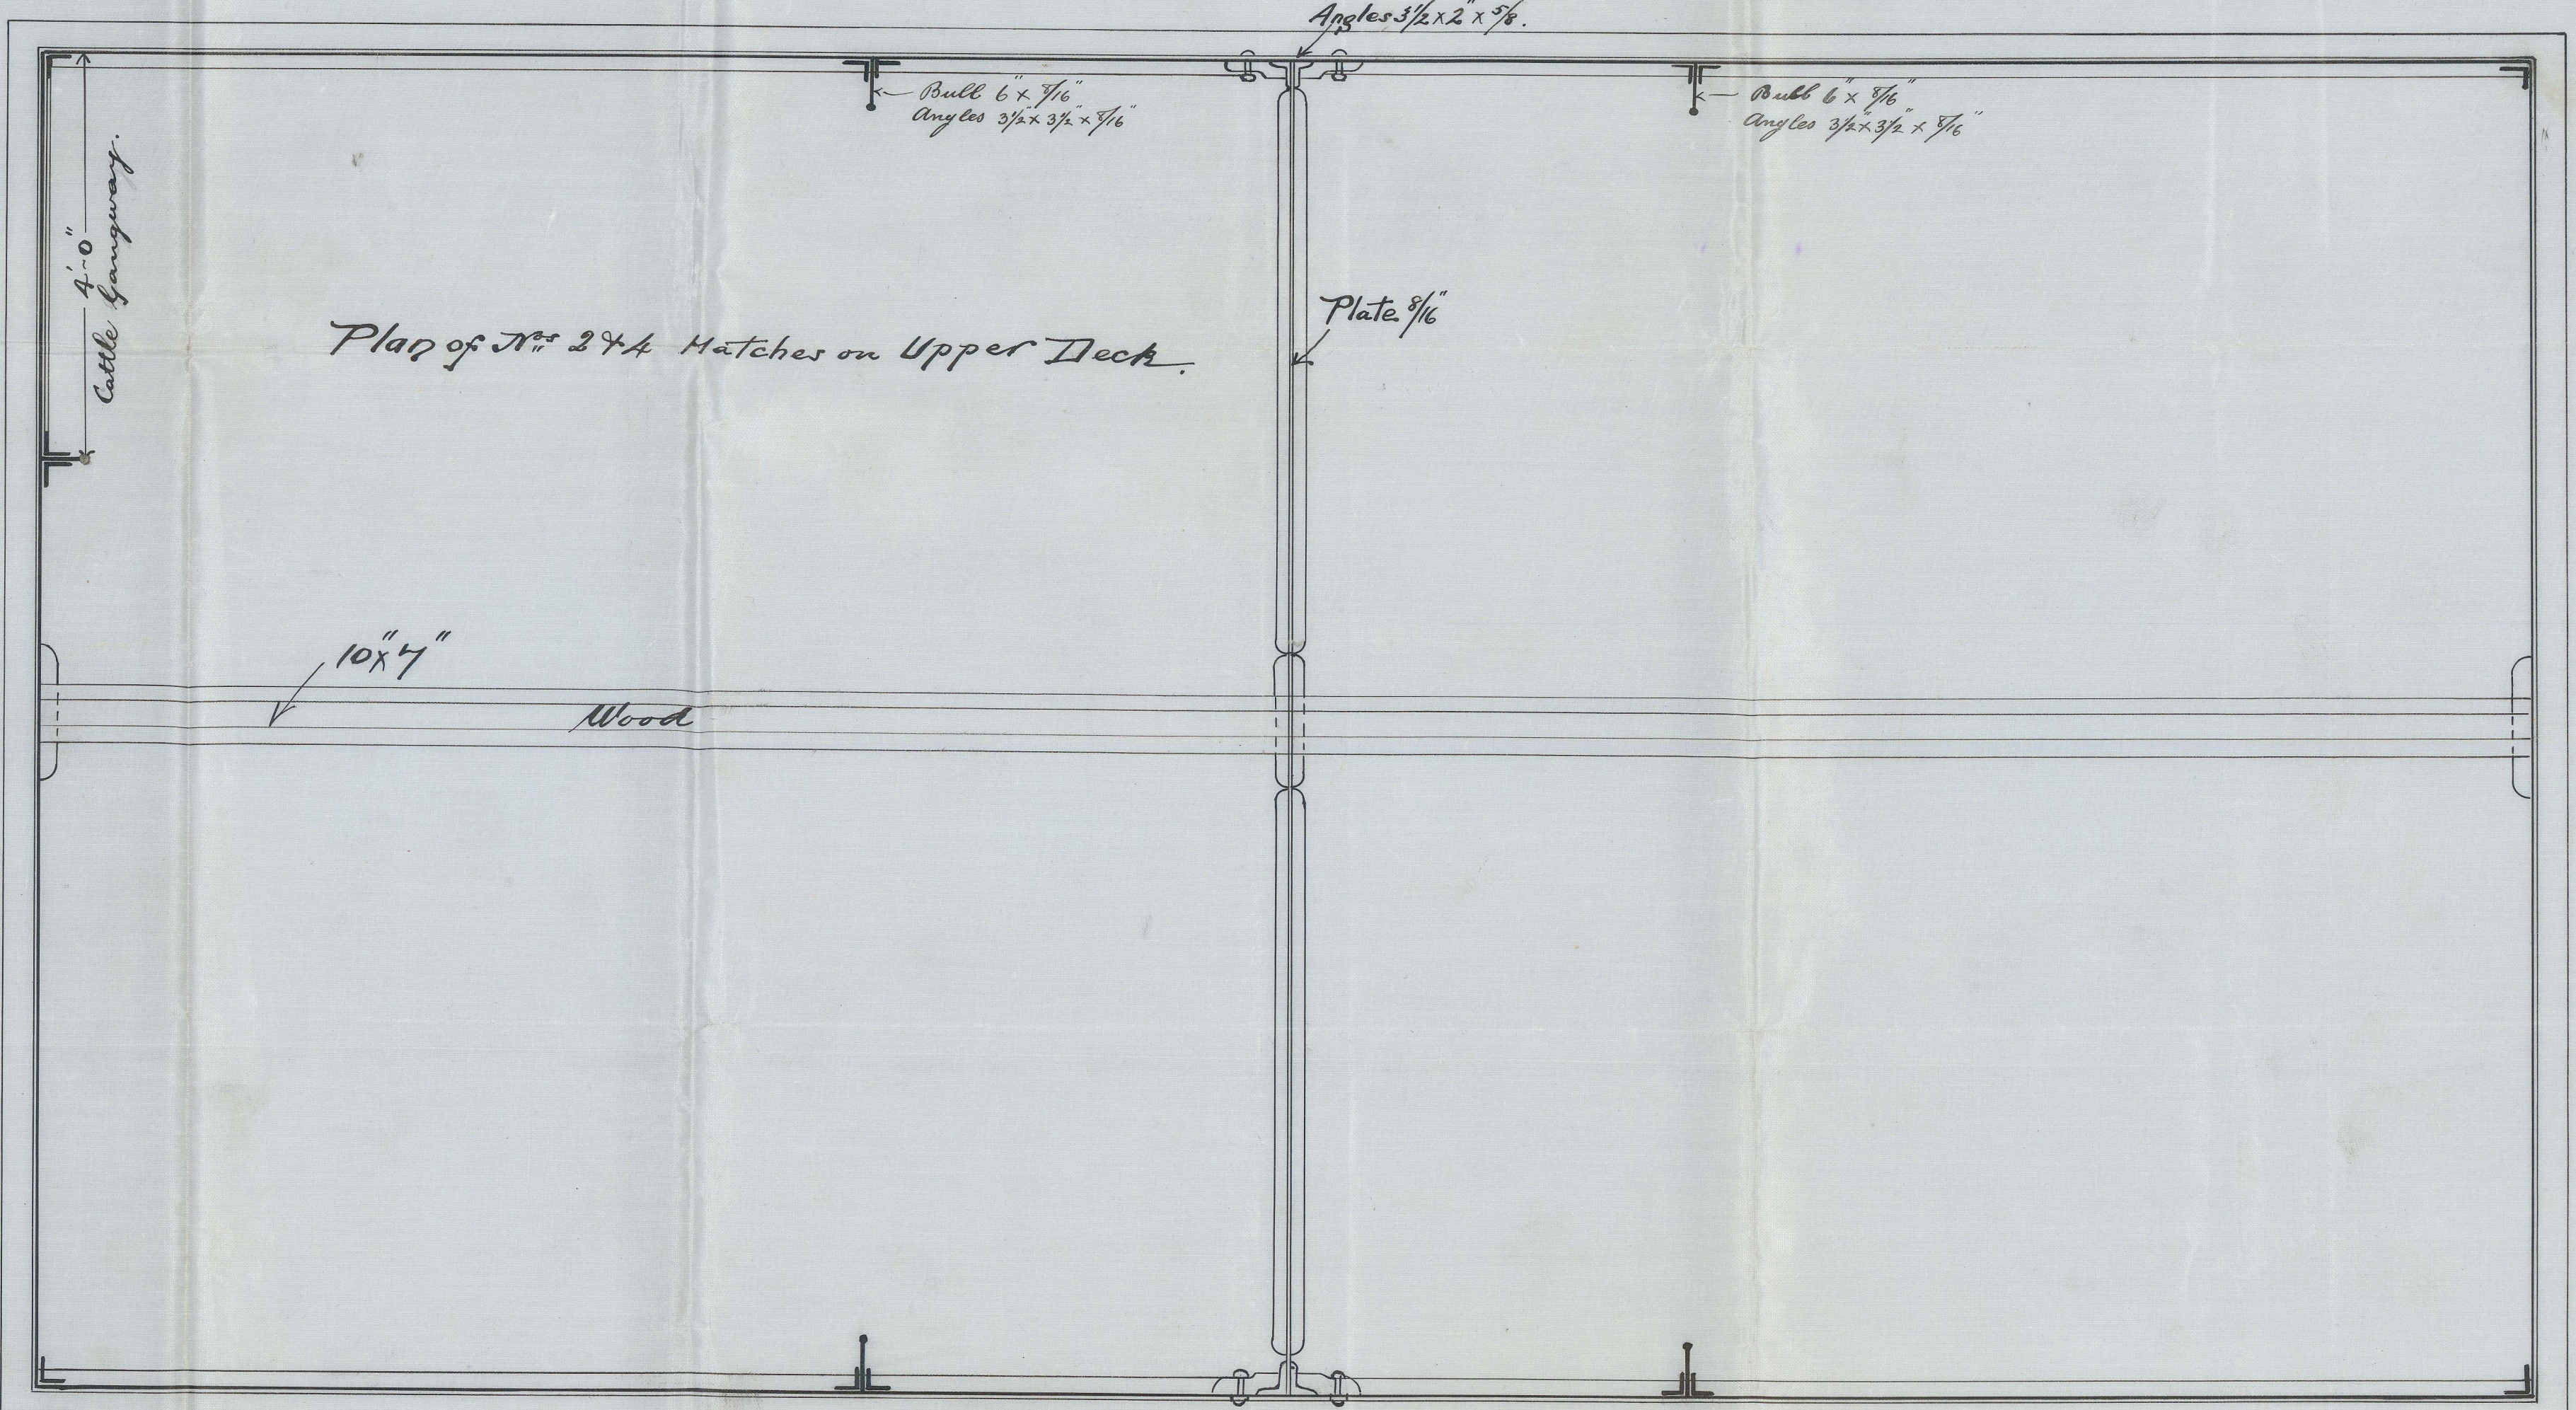


Similar to arrangement  
approved by Committee for  
S.S. Russian & Monte Video  
J.H. 11-11-89



S. S. Brazilian  
 Glasgow Report  
 No 9494.

View of After end of the 2nd Hatch on Upper Deck

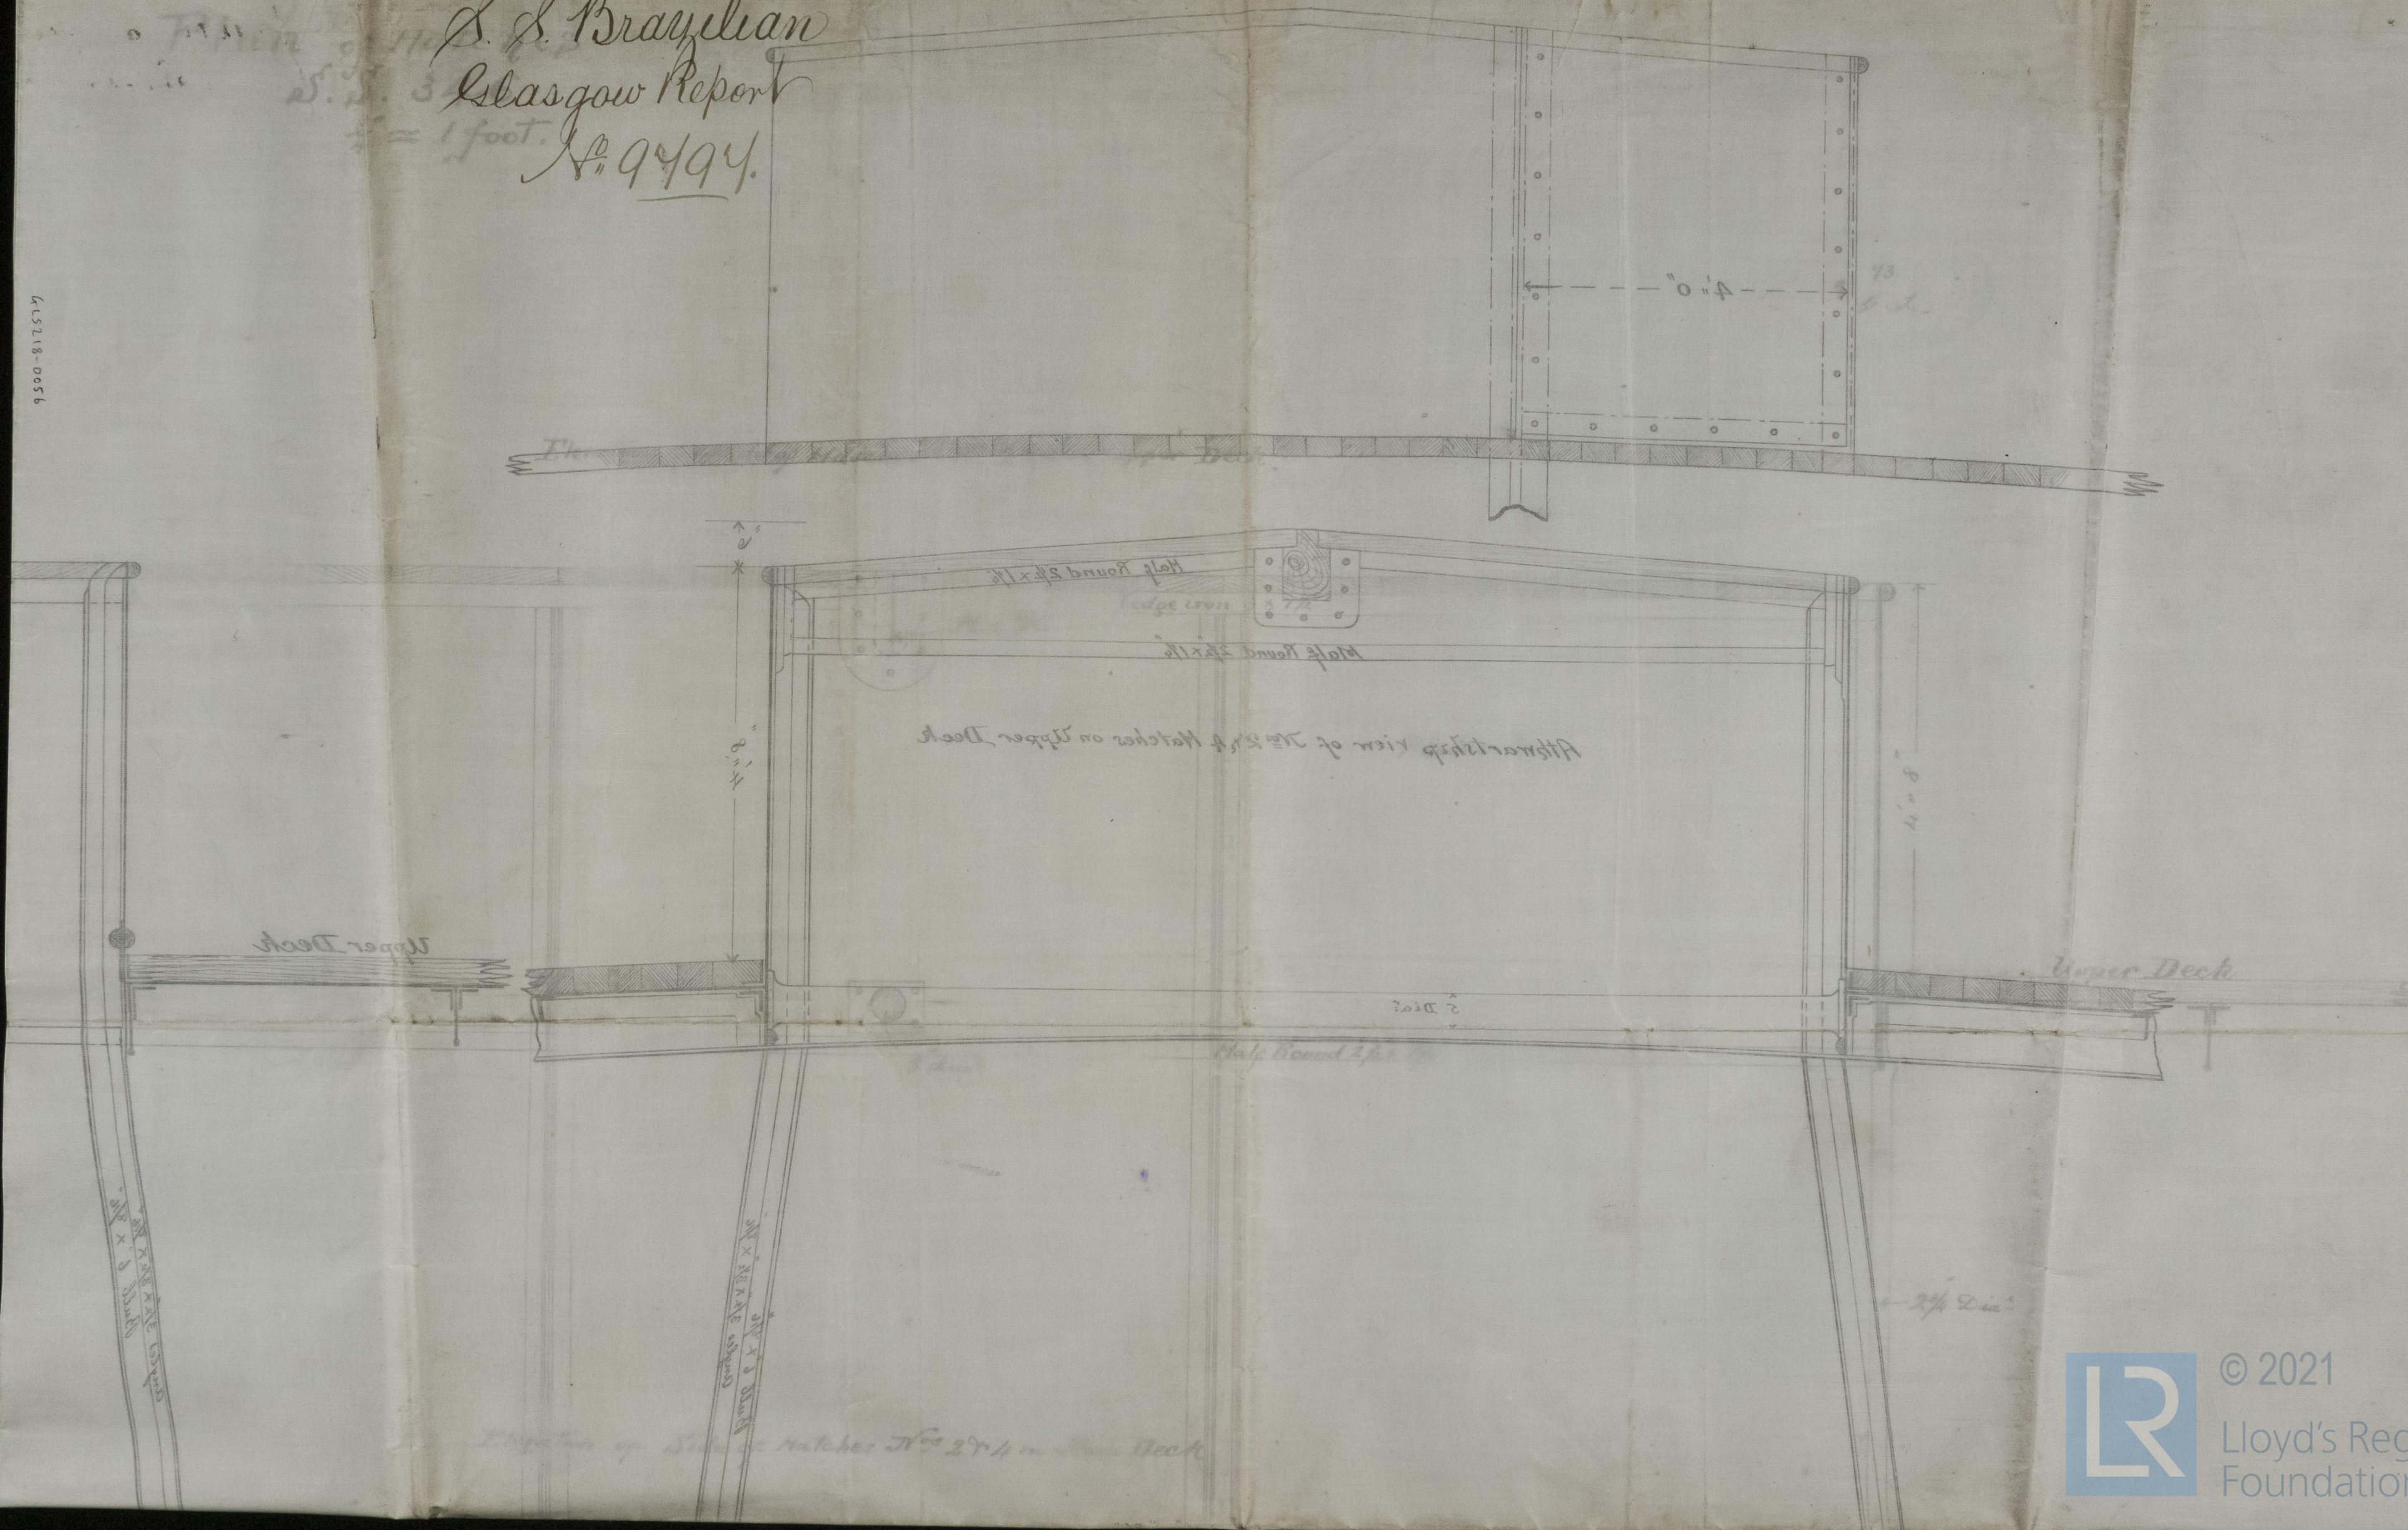

© 2021  
 Lloyd's Register  
 Foundation

65218-0056