
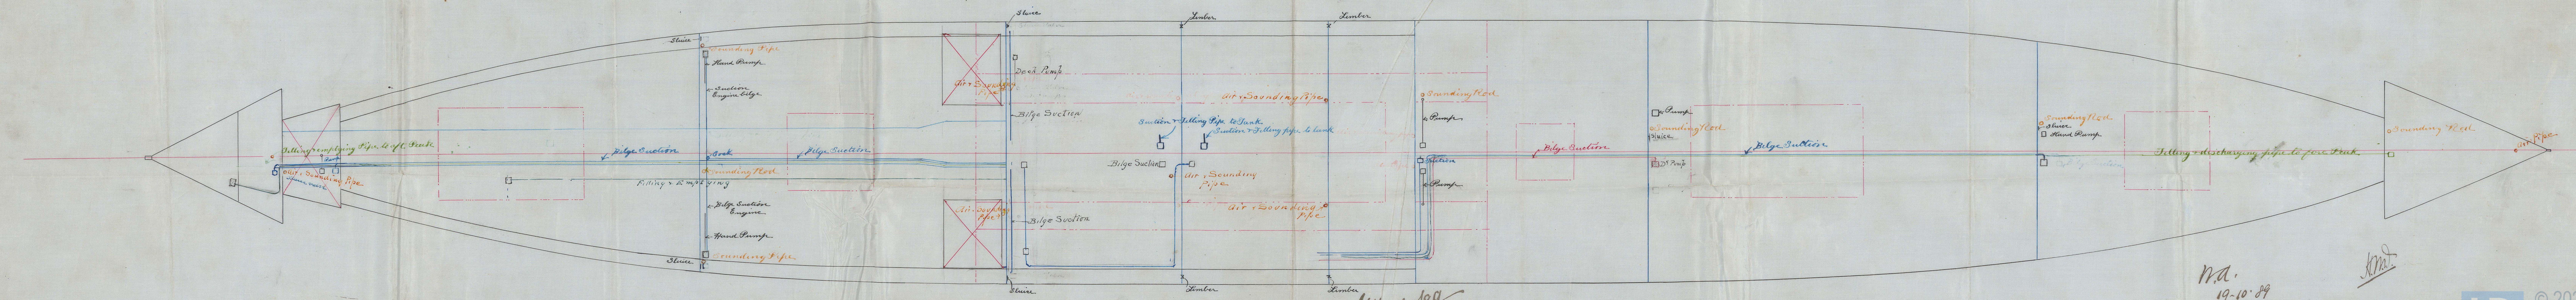


1889
 21
 1889
 1889

— Pumping Arrangement —
 — S.S. J^r 346 —
 — Scale 1/4" = 1 Foot —

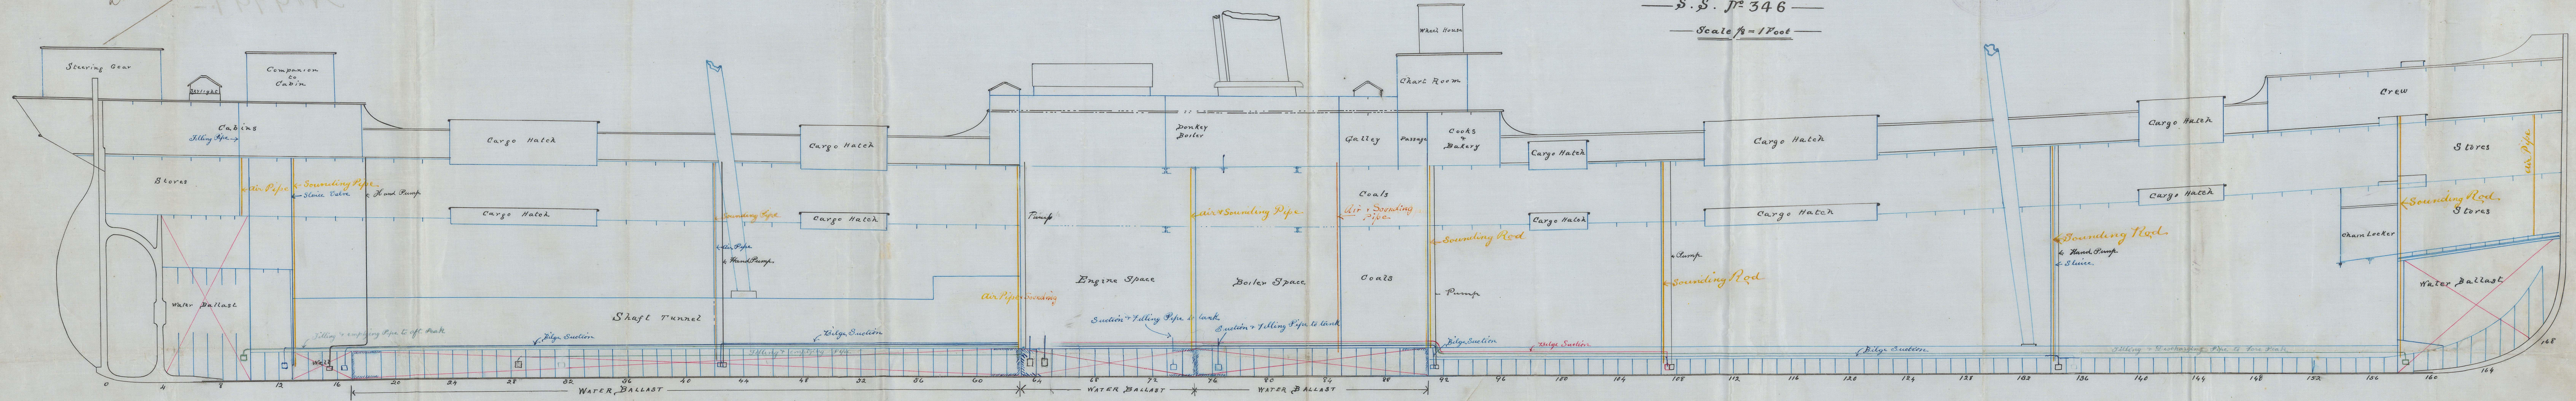


18/10/89

M.A.
 19-10-89

M.A.

S. S. "Brazilian"
 Glasgow Report
 No 9494.

18. 10. 1886

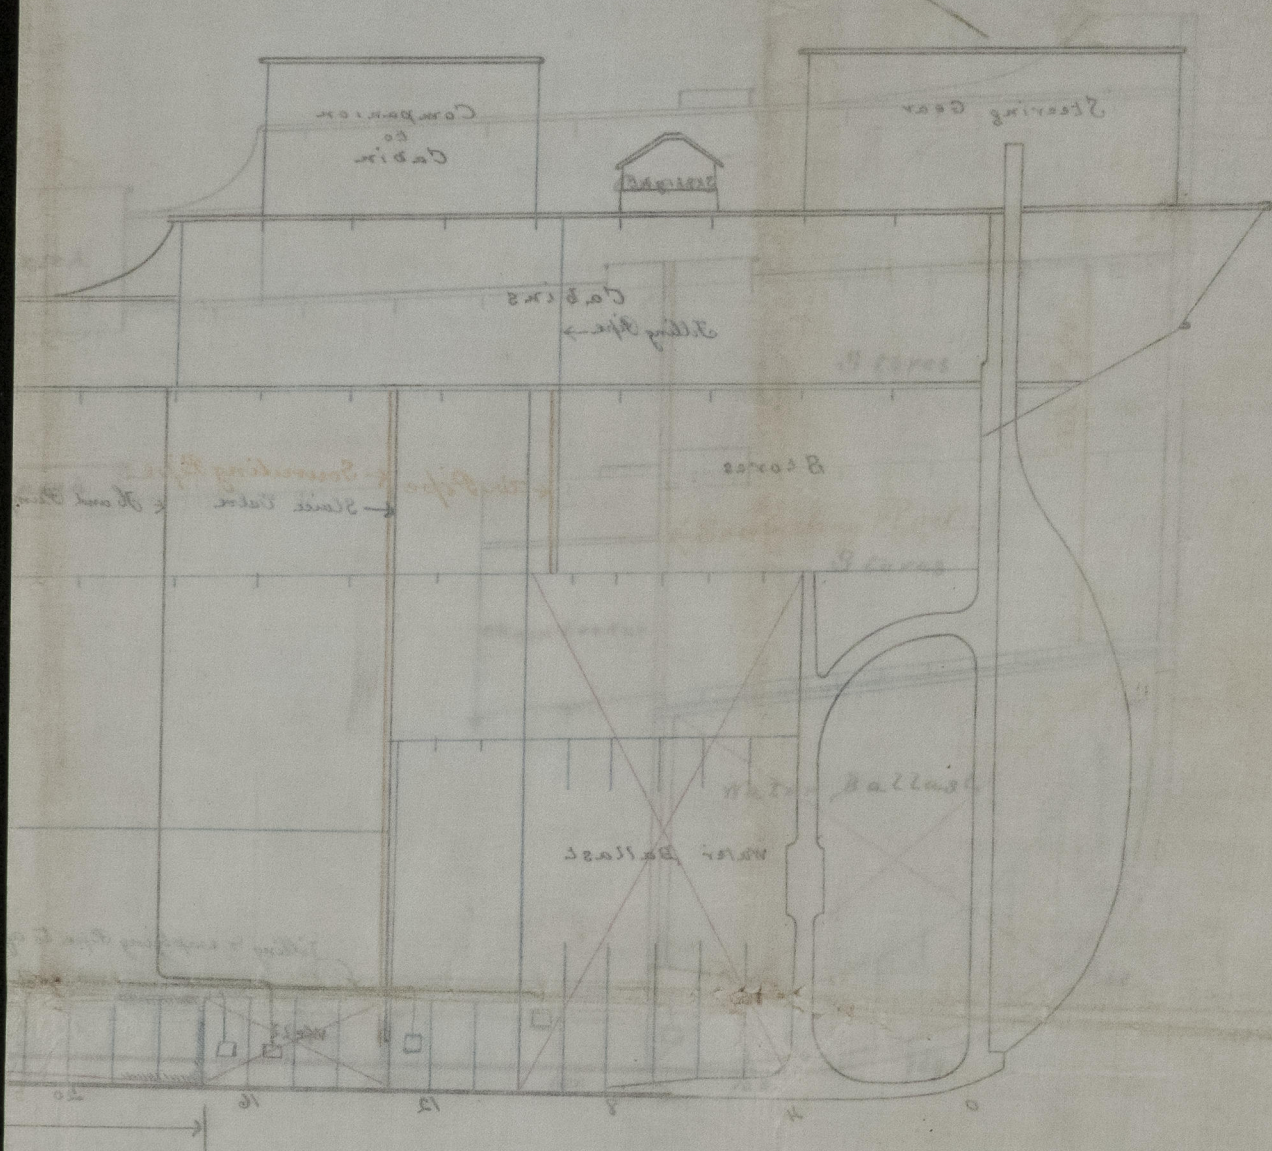

L500-812517



© 2021

Lloyd's Register
 Foundation