



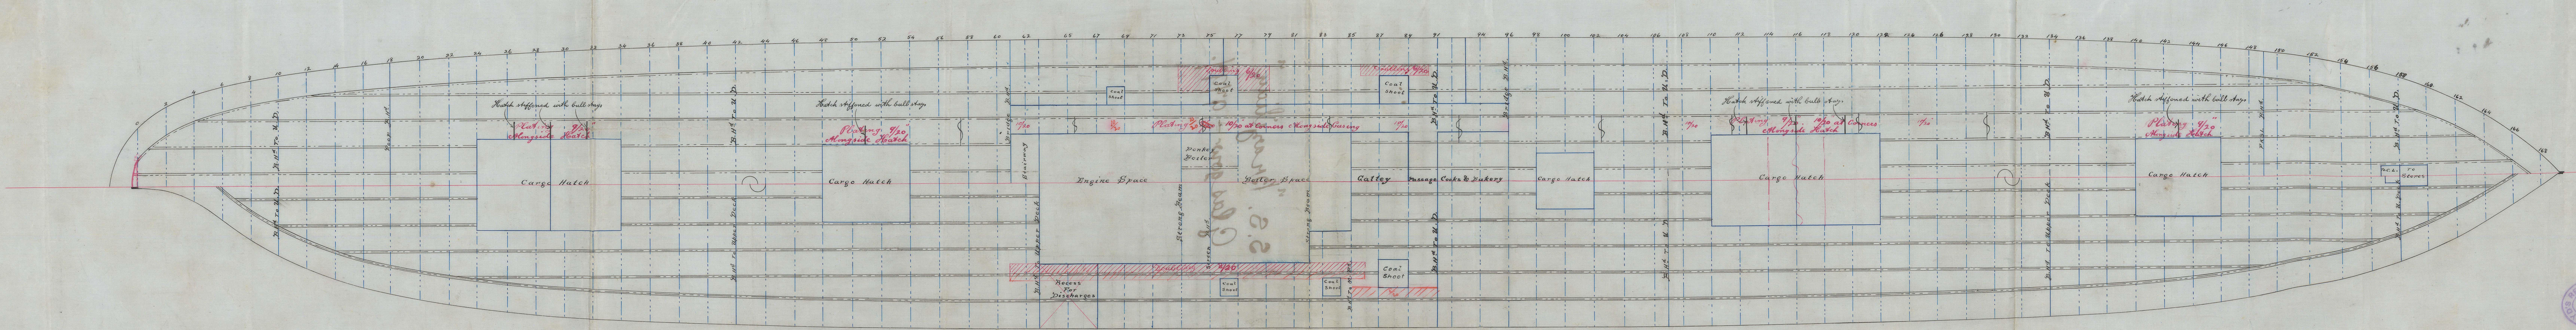


17 JUN 89

*mailing 1888
modest unpaired
- 10000*


— Longitudinal Section —
— S.S. No 346 —
— Scale 1/4" = 1 Foot —

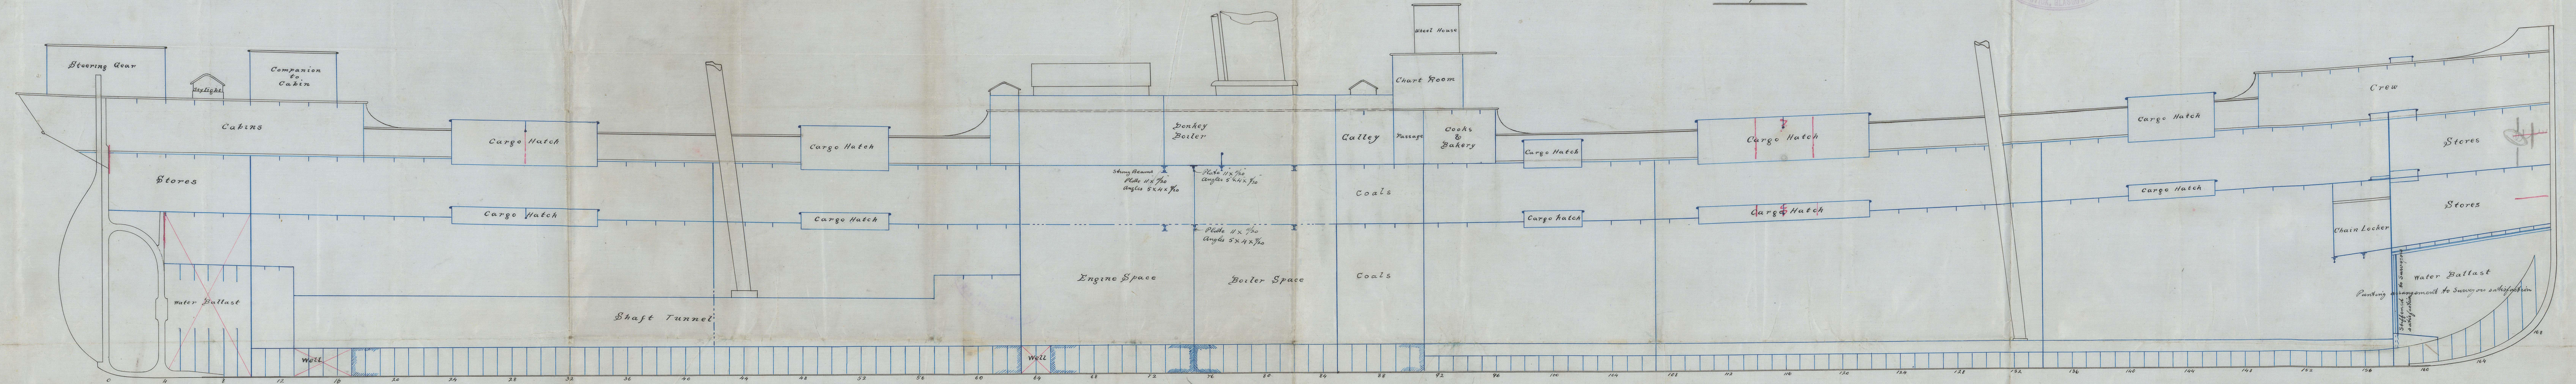

S.S. "Brazilian"
Glasgow Report
No 9494.

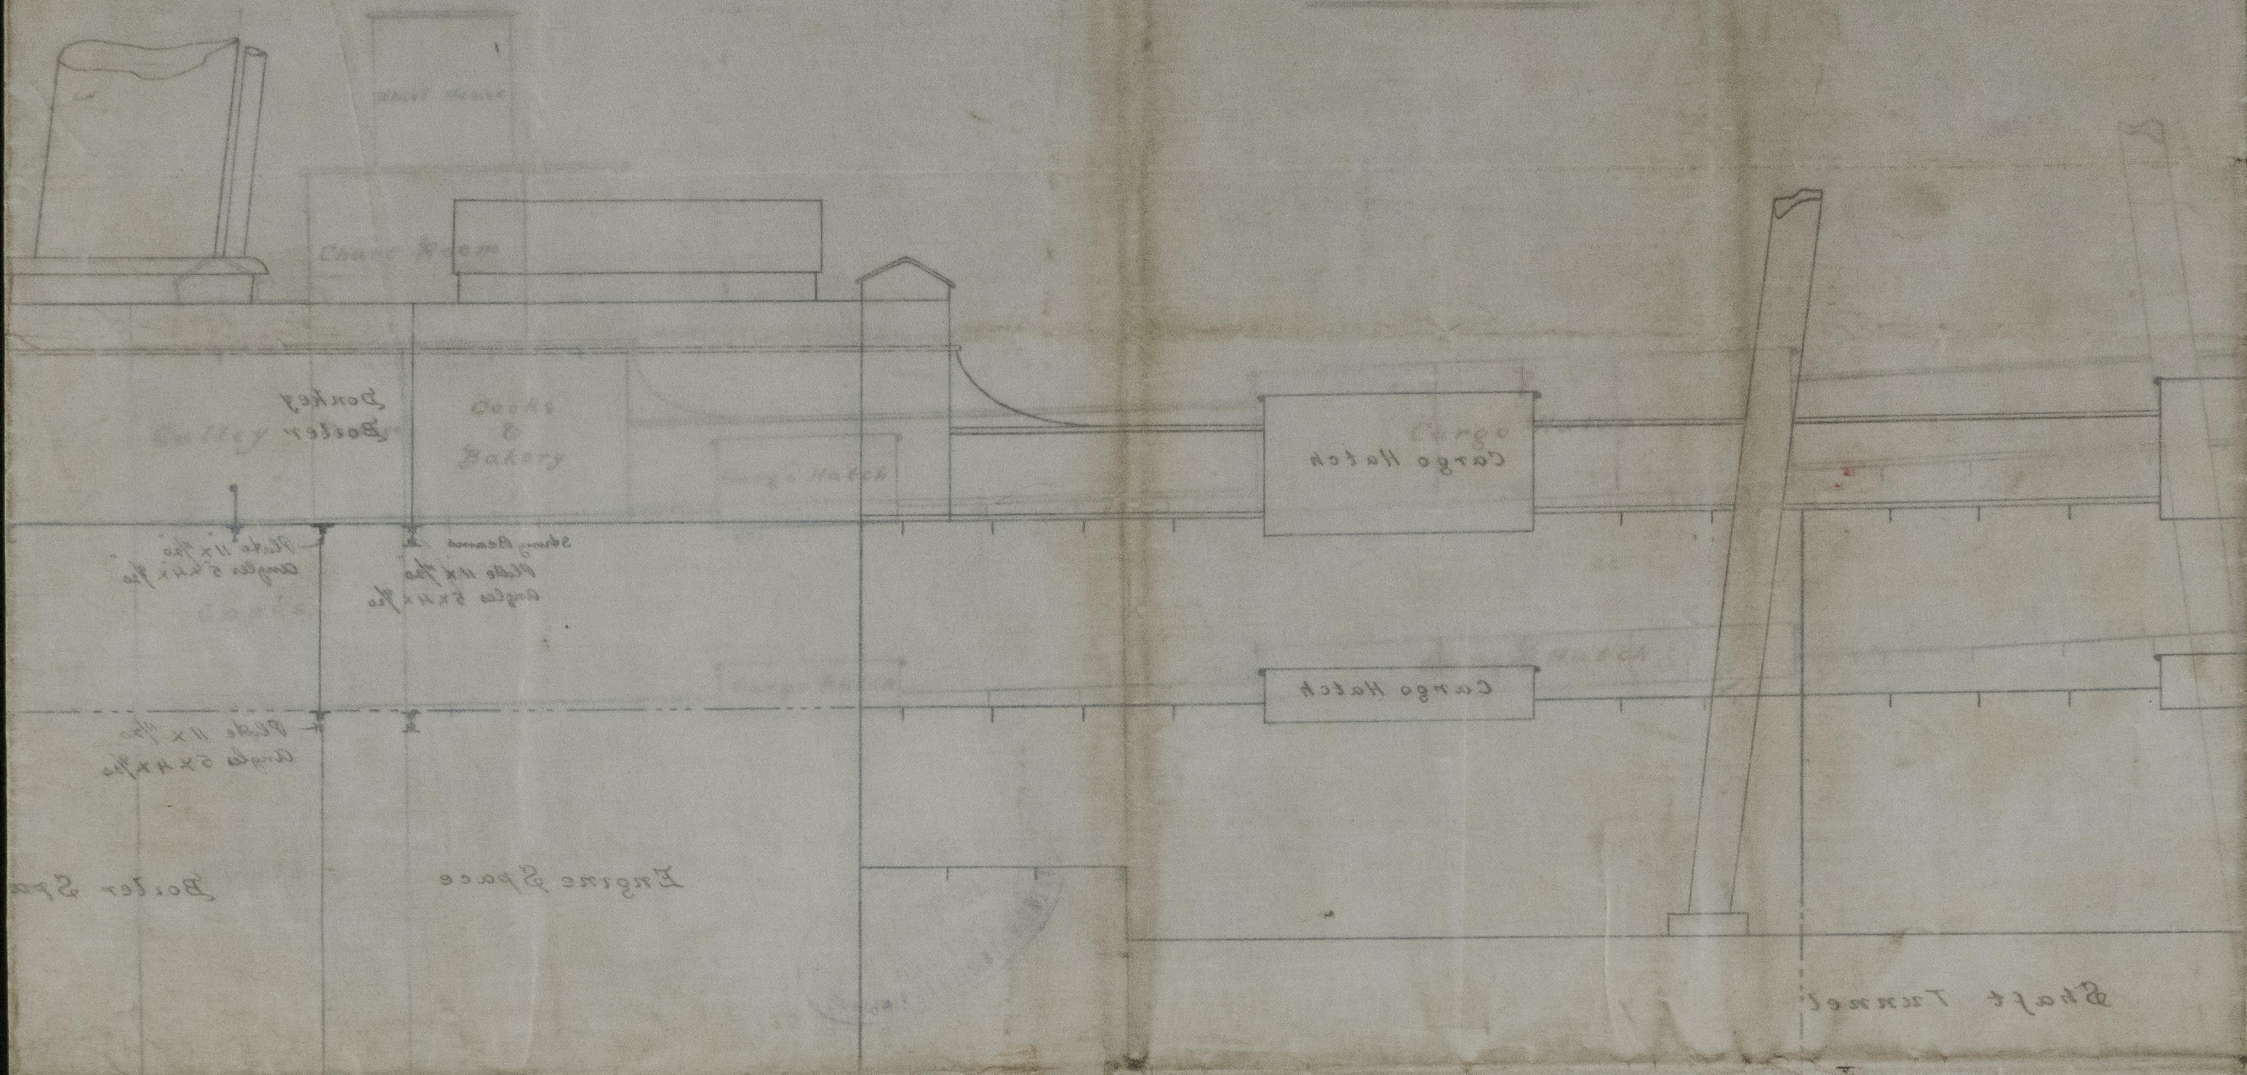

S.S. "Brazilian"
Glasgow - 9494.

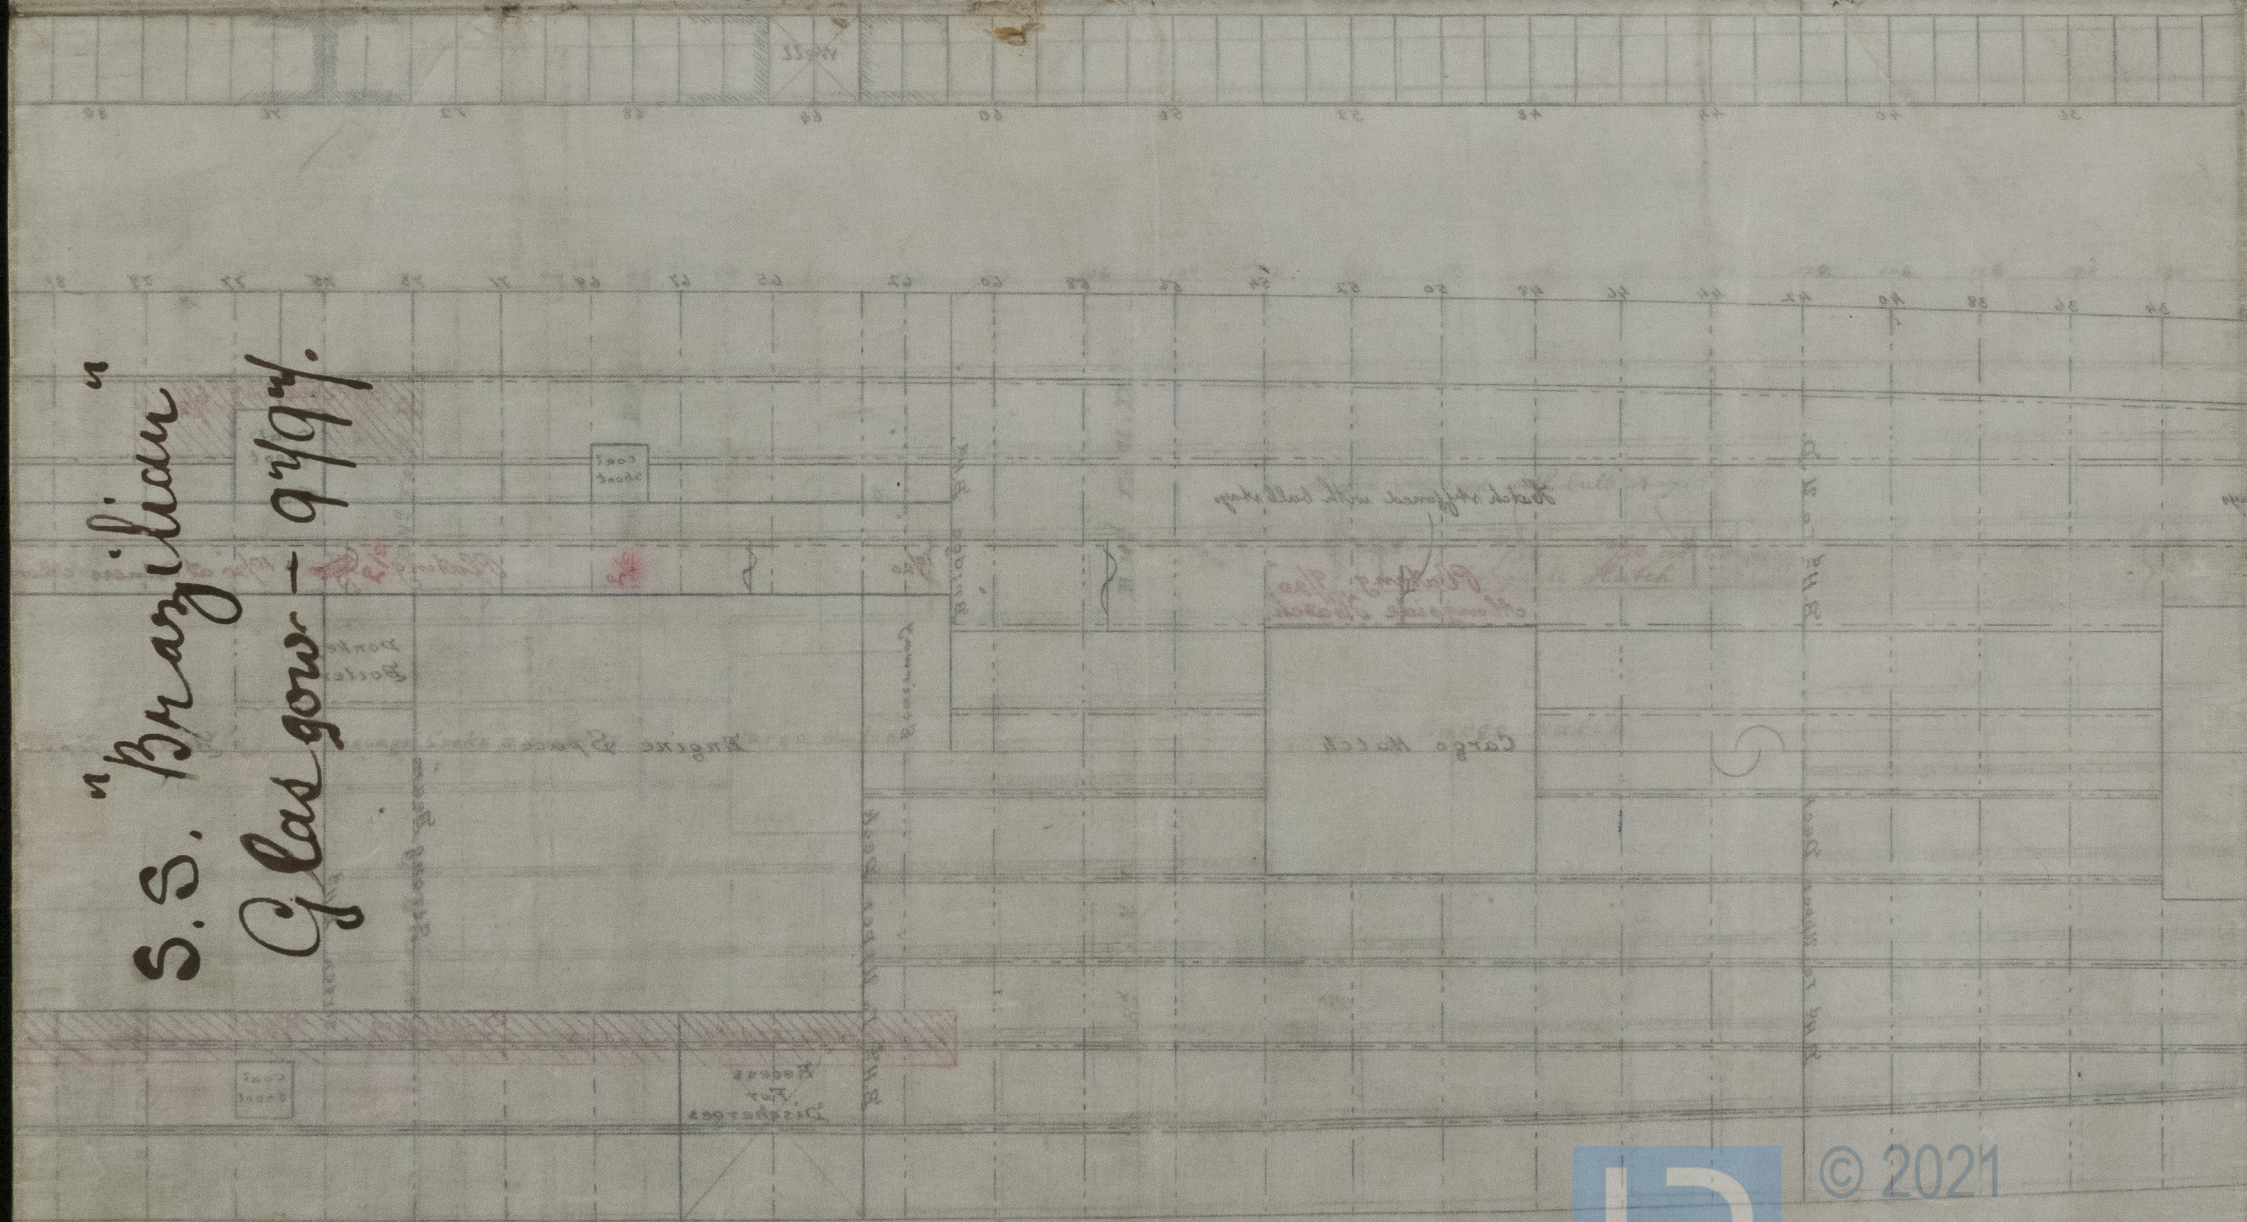

© 2021

Lloyd's Register
Foundation