

FRI 4 OCT 89
MON 18 NOV 89

Iron Twin Screw Steamer N^o 78

Scale $\frac{1}{2}" = 1 \text{ Foot}$
Classed 90A

S.S. "Route No 2"


May 28/90

SCOTT & CO
Shipbuilders
BOWLING

18 + 5/16 27/9/89.

Section in way of E. & B. Gasing

Section at fore & after end of Gasings

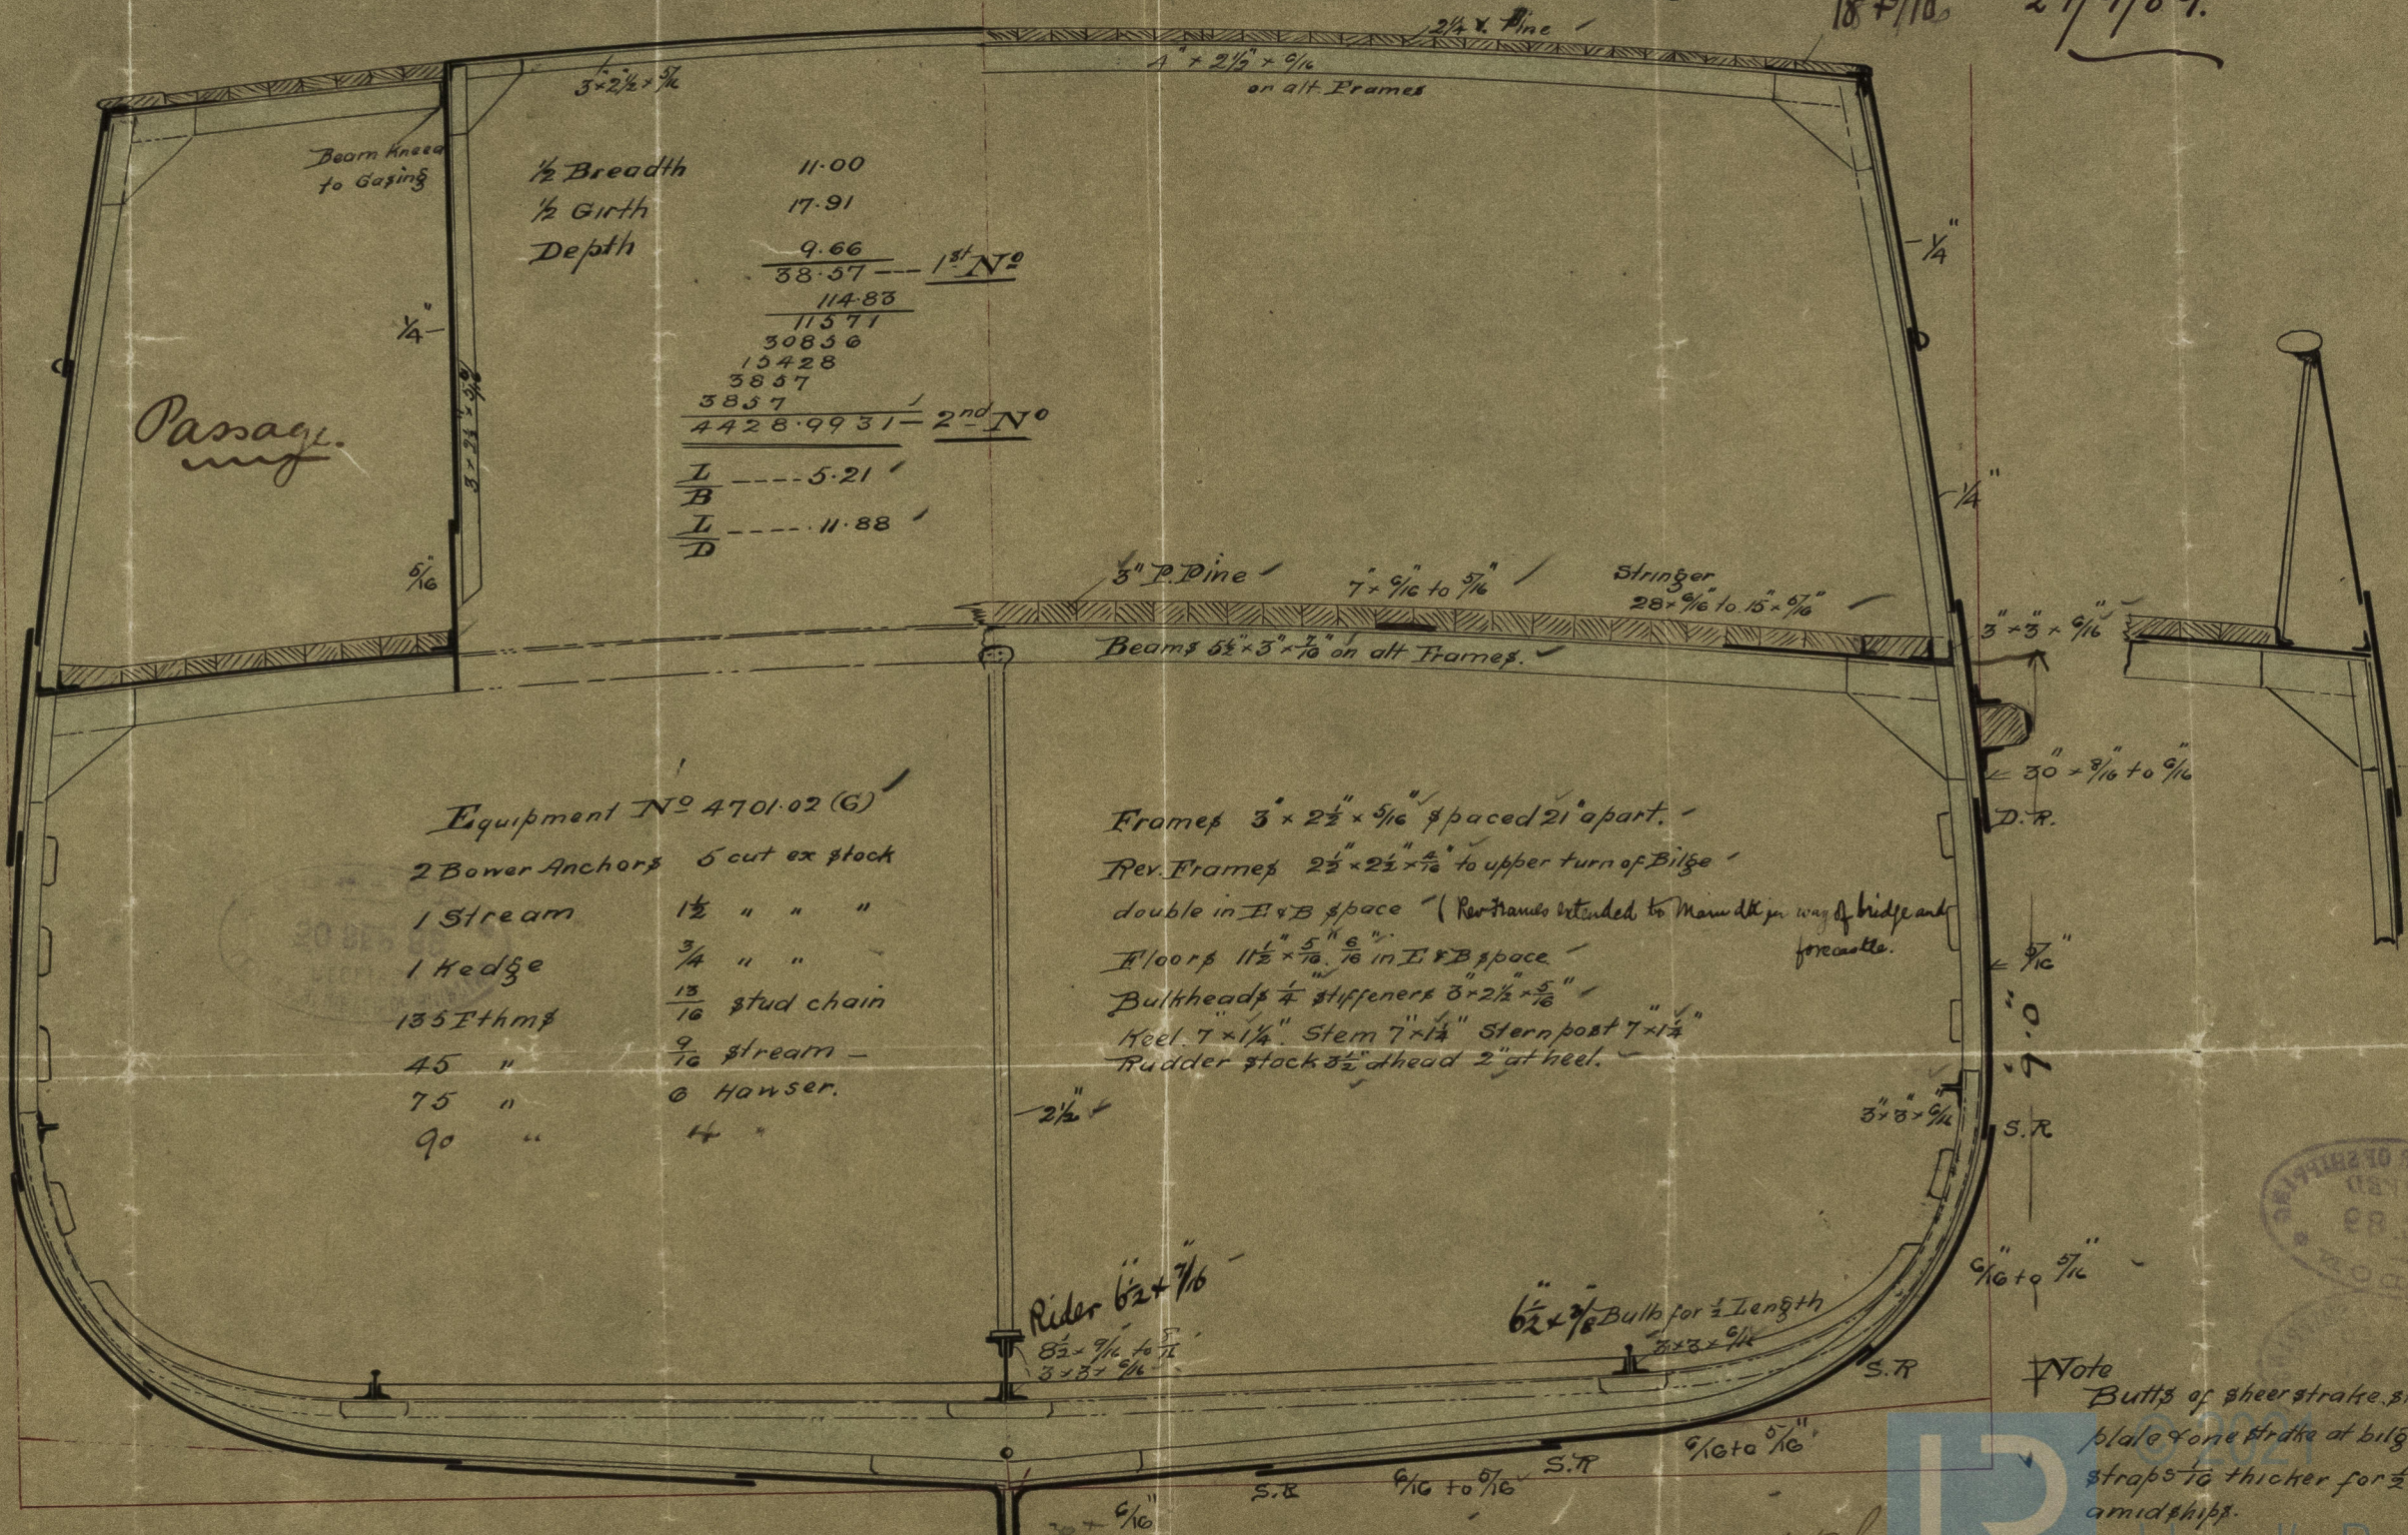

Equipment N^o 4701.02 (G)

| | |
|-----------------|----------------------------|
| 2 Bower Anchors | 5 cut ex stock |
| 1 Stream | $1\frac{1}{2}$ " " " |
| 1 Hedge | $\frac{3}{4}$ " " " |
| 135 Ithm ϕ | $\frac{13}{16}$ stud chain |
| 45 " | $\frac{9}{16}$ stream - |
| 75 " | 6 Hawser. |
| 90 " | 4 " |

Frames $3 \times 2\frac{1}{2} \times 5\frac{1}{16}$ spaced 21" apart.

Rev. Frames $2\frac{1}{2}'' \times 2\frac{1}{2}'' \times \frac{1}{16}''$ to upper turn of Bilge -

double in $E \times B$ space - (Reframes extended to Main dkt in way of bridge and

H/loop $11\frac{1}{2} \times \frac{5}{16} \times \frac{6}{16}$ in E & B space.

Bulkheads $\frac{1}{4}$ stiffeners $3 \times 2\frac{1}{2} \times \frac{5}{16}$

Keel $7 \times 1\frac{1}{4}$ " Stern $7 \times 1\frac{1}{4}$ " Stern post $7 \times 1\frac{1}{4}$ "
Rudder stock $3\frac{1}{2}$ " head 2" at heel.



Note
Butts of sheer stroke, stringer
blade & one strike at bit to have
straps to thicker for $\frac{1}{2}$ length
amidships.

all butt straps double riveted

GLS218-0107

02/02/00

"Soul stuck" 2-2

S.S. Butte No. 2

Glasgow Report

N^o 9830

10 NOV 89

LLOYD'S REGISTER OF SHIPPING
 RECEIVED
 11 DEC. 89
 LONDON

ROYAL MAIL
29 APR 90

Will have strong double under

RECEIVED
30 SEP 89

