


Oct 10 10 89




Longitudinal Seams Drilled in Place
Circumferential
Rivet Holes 1" diam. Steel Rivets 4" Pitch
Shell 3/4" Thick.
All Plates and Stays of Steel.

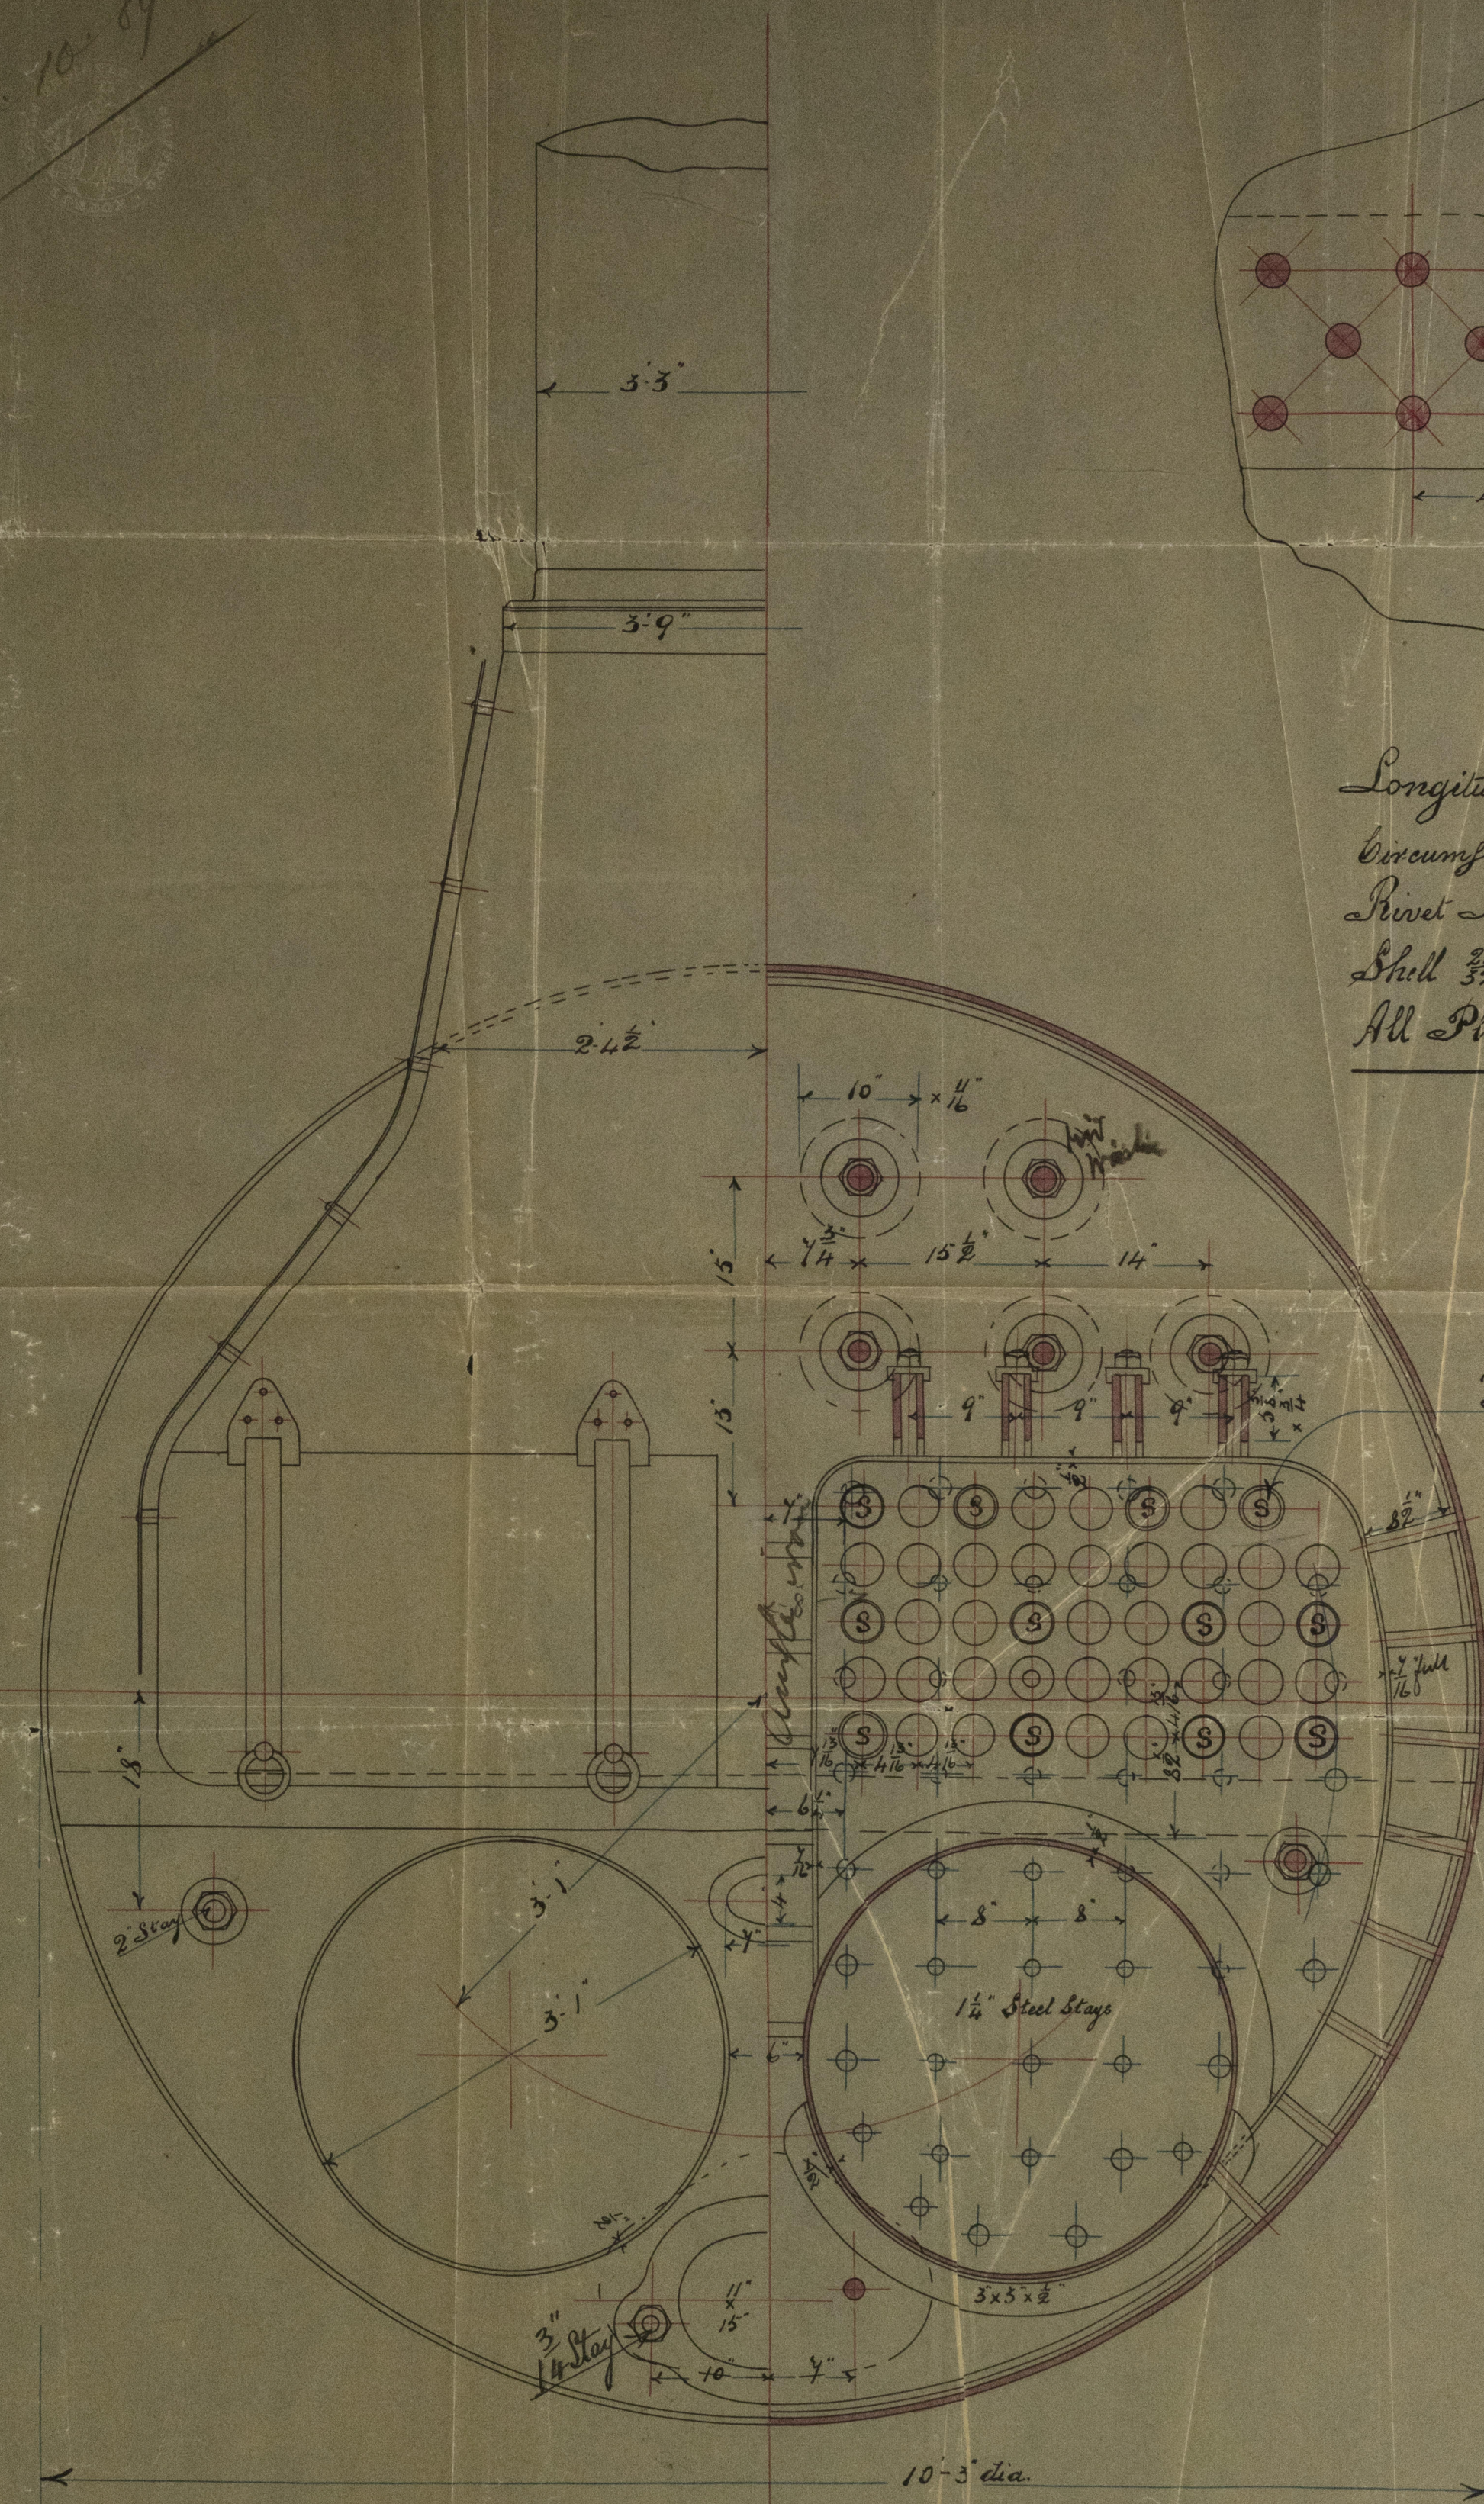

Boiler No 78

Working Pressure 90 lbs per square inch

Scale 1" = 1 Foot

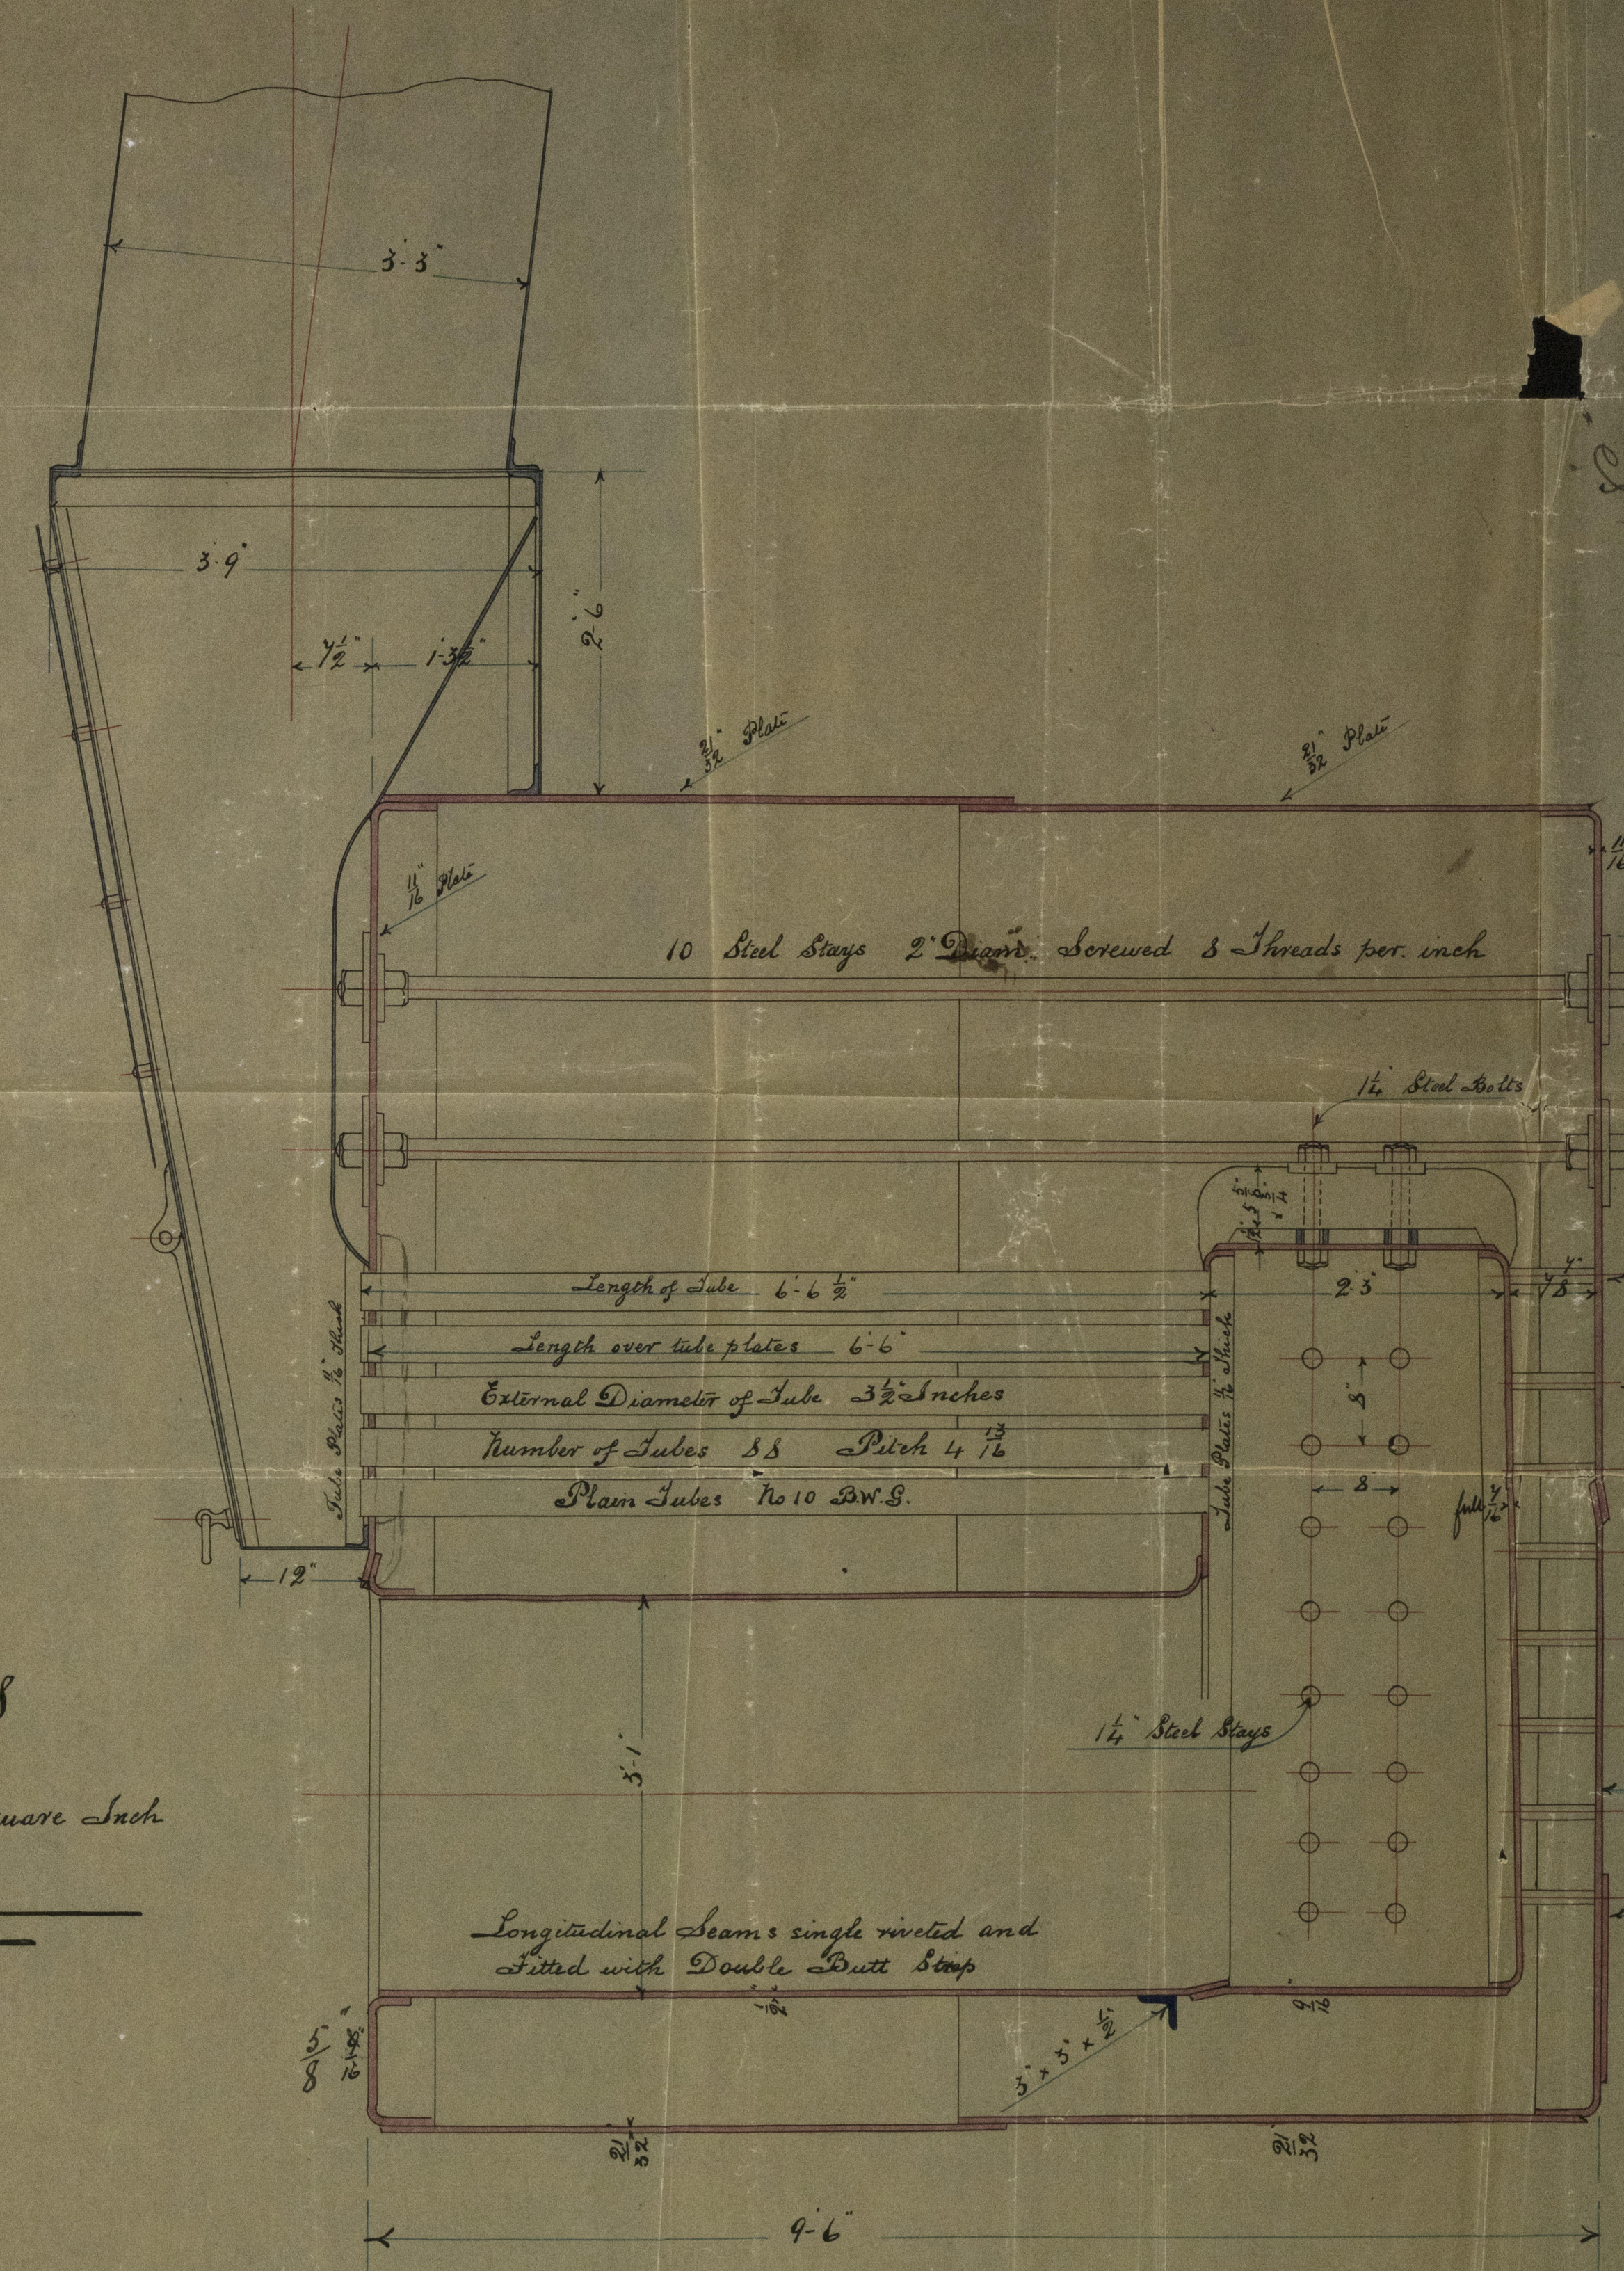

27th Oct 88
Inspected & approved
- J. B. P. L.

W.D. 9-10-89

W.D. 9-10-89

GLS218-0108

ps 01-01 1562


GLS218-0108

68.01 1/2
1/2 1/2 1/2

1/2 1/2 1/2

Counting Plate

Meeting Hall
S. S. Butte A#2
Glasgow Report
A# 9830.

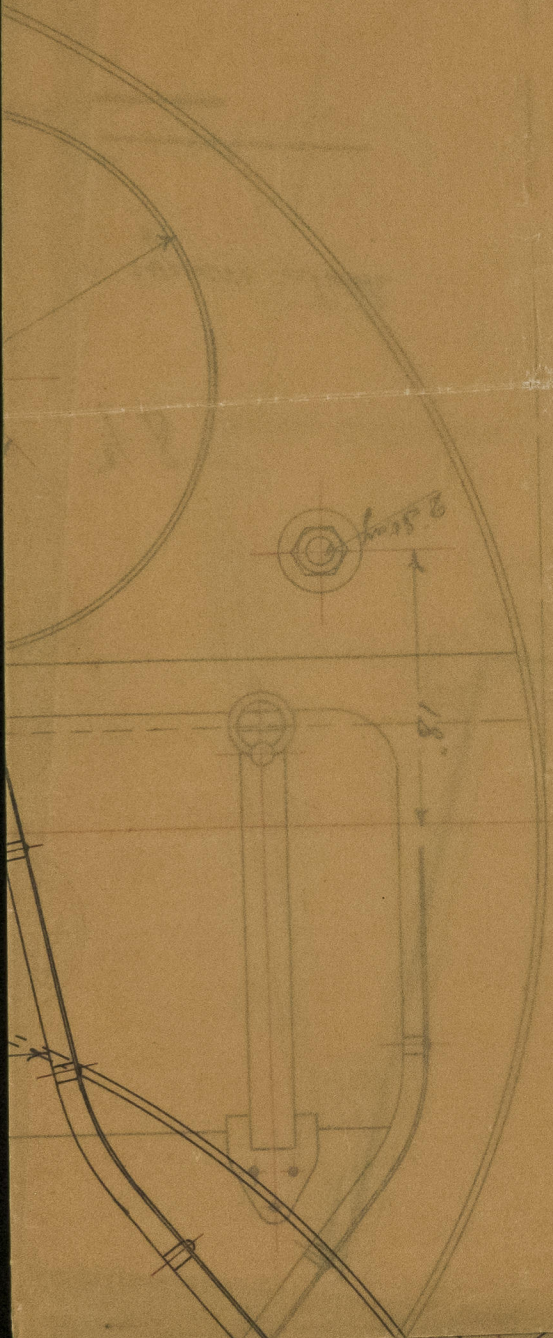

© 2021
Lloyd's Register
Foundation