

W. 7.12.89

Dec: 13:12:89


"L.M. etc N° 88  
088 P.M. traded up and down

# S.S. N° 78 Pumping Plan

Scale 8" = one foot

hand pumps to bilge on each side

N.A. 11-12-89

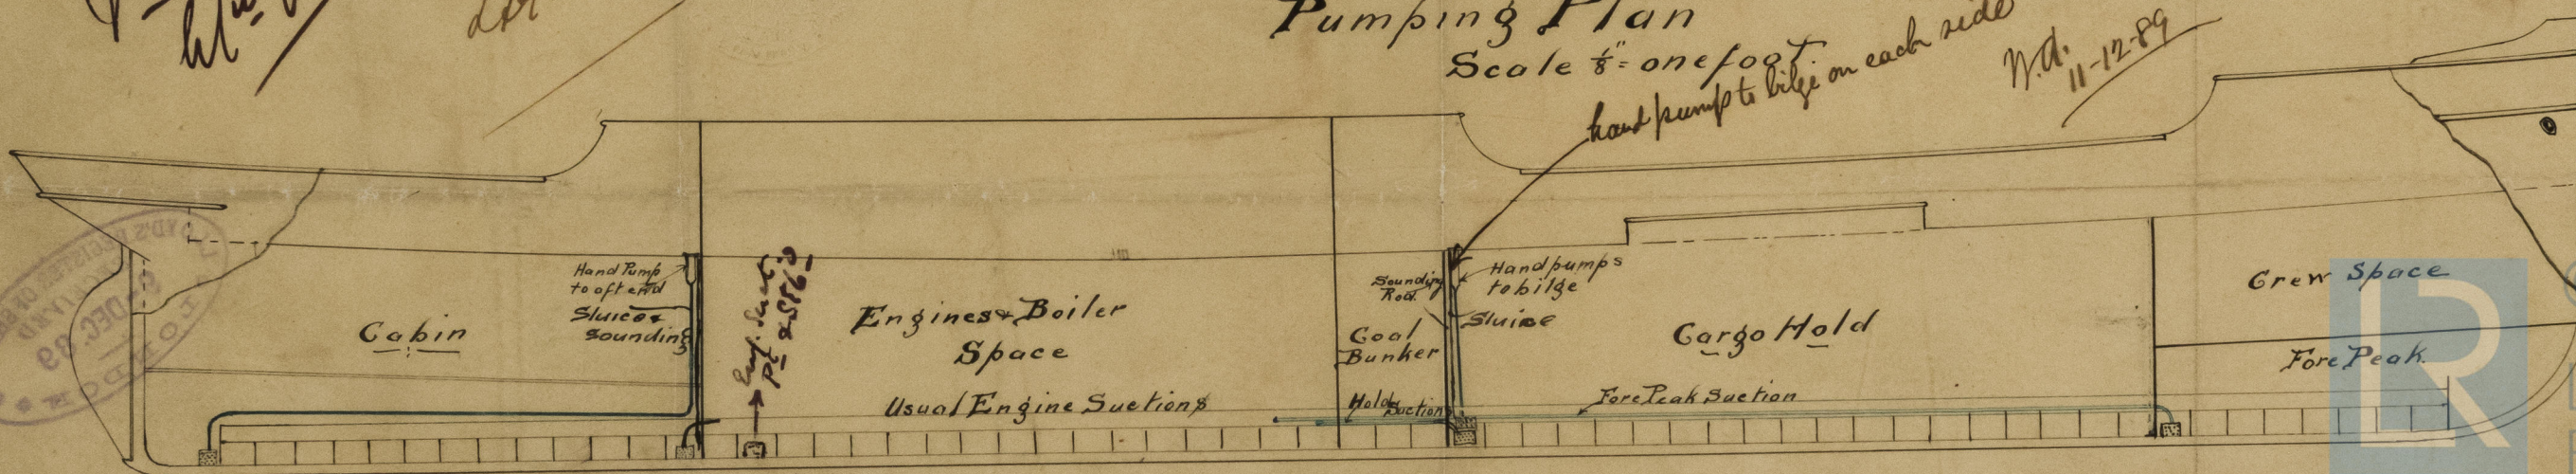

Eng. Suction  
to aft end

Engines & Boiler  
Space

Usual Engine Suction

Coal  
Bunker

Sounding  
Rod

Hand pumps  
to bilge

Sluice

Cargo Hold

Fore Peak Suction

Holds  
Suction

Crew Space

Fore Peak

9010-81525-2

GLS218-0109

Scott & Co  
Shipbuilders  
Glasgow

© 2021 Lloyd's Register  
Foundation



W. & A. TROSBY  
SHEPHERD & SON  
LONDON












© 2021 Lloyd's Register Foundation

