



Scale $\frac{1}{8}'' = \text{One Foot}$

Classed 90A.

Profile

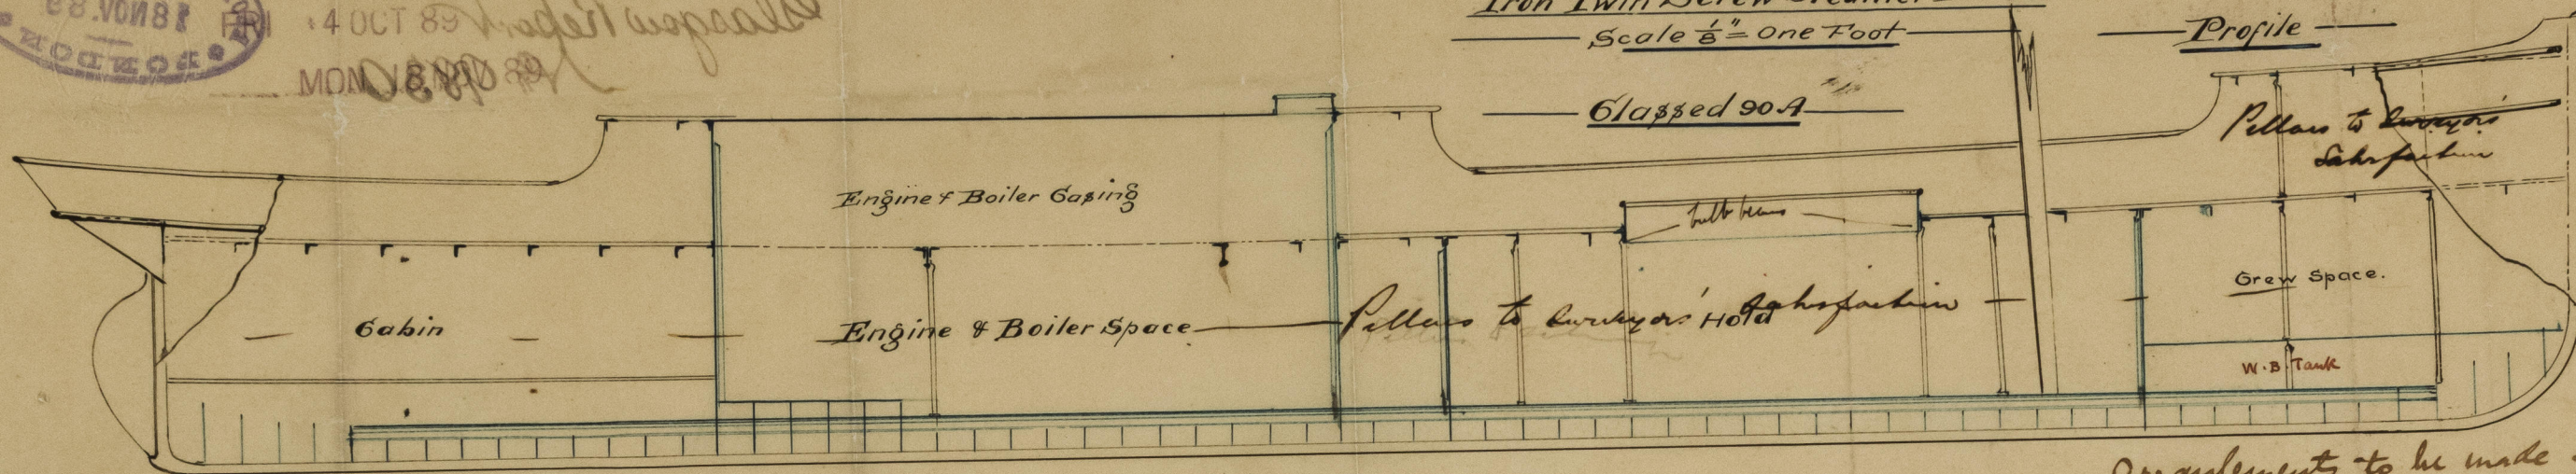



Arrangements to be made for
keeping the fore peak tank
Deck Plan full of water }

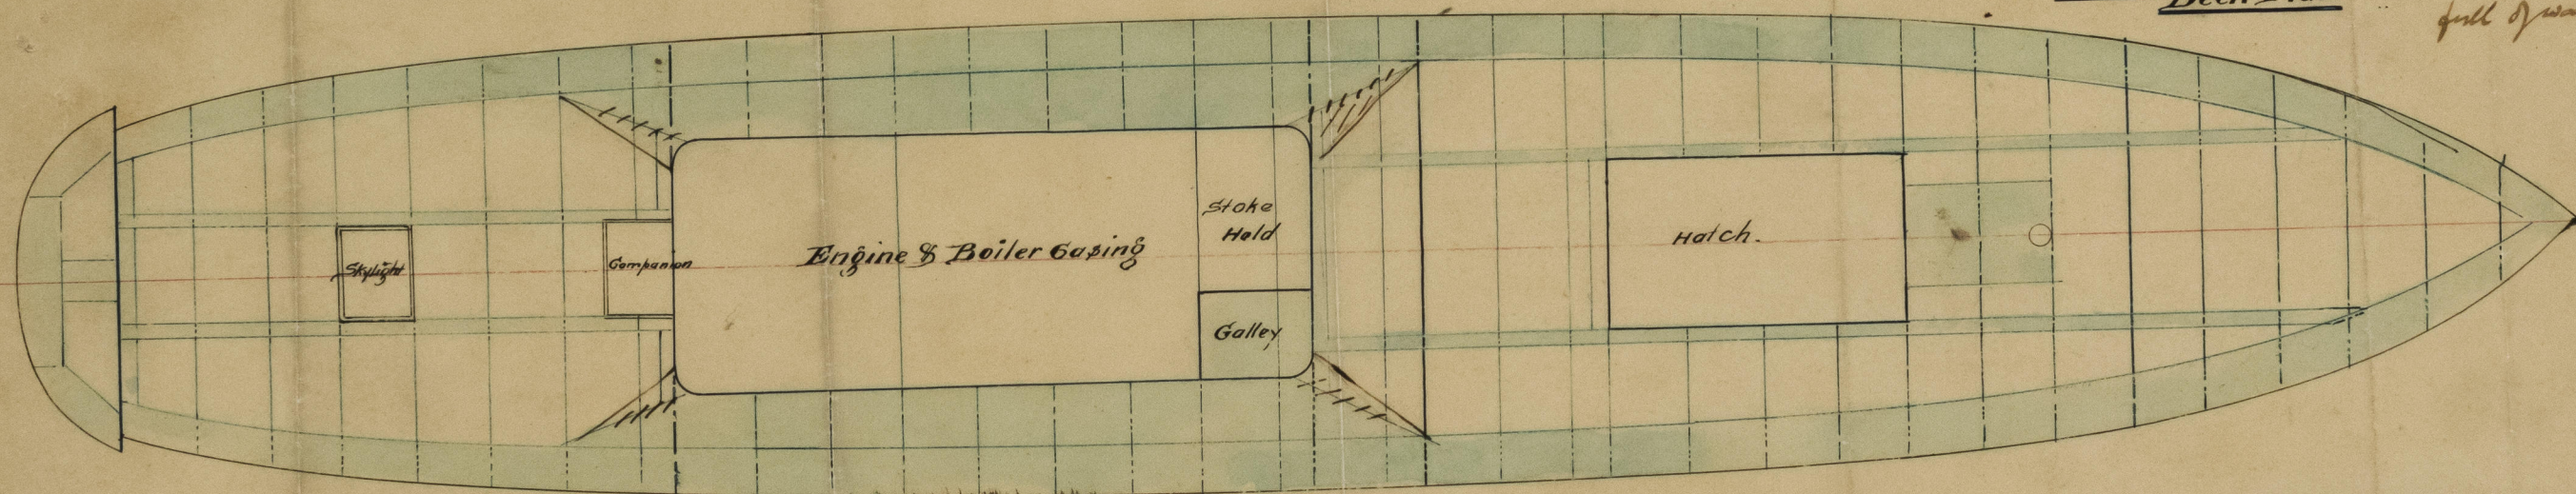



27/9/89.

J. H. L.
3/10/89

S.S. Bute No. 2
 Glasgow Report No. 9830
 OCT 89

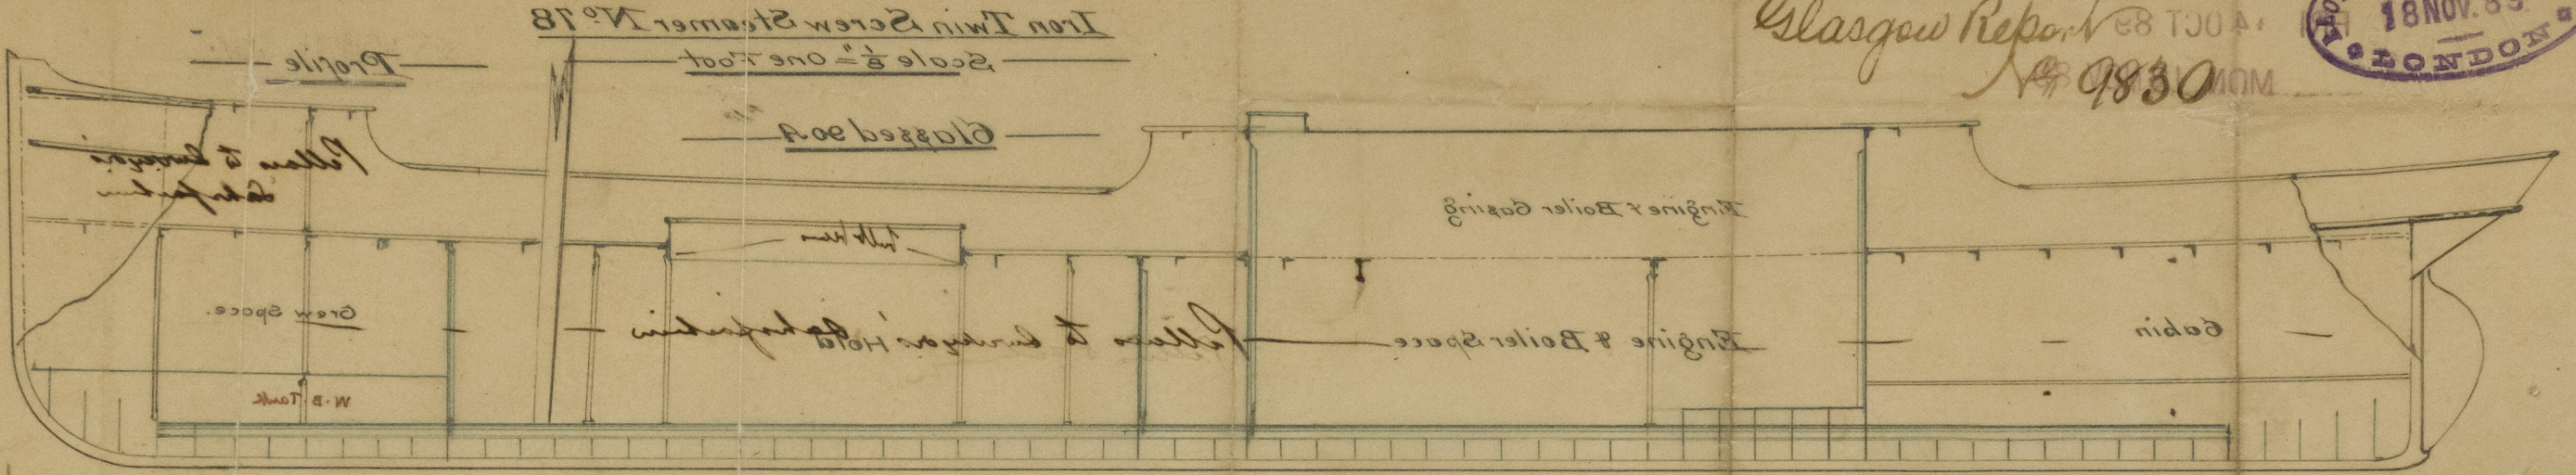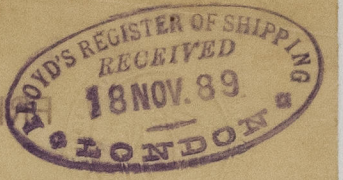


Arrangements to be made for
 taking the fore peak tank
 Deck plan

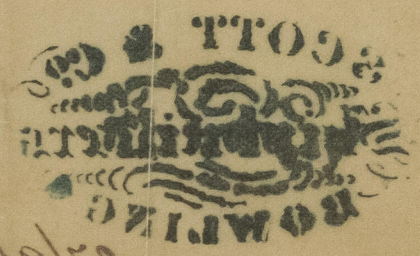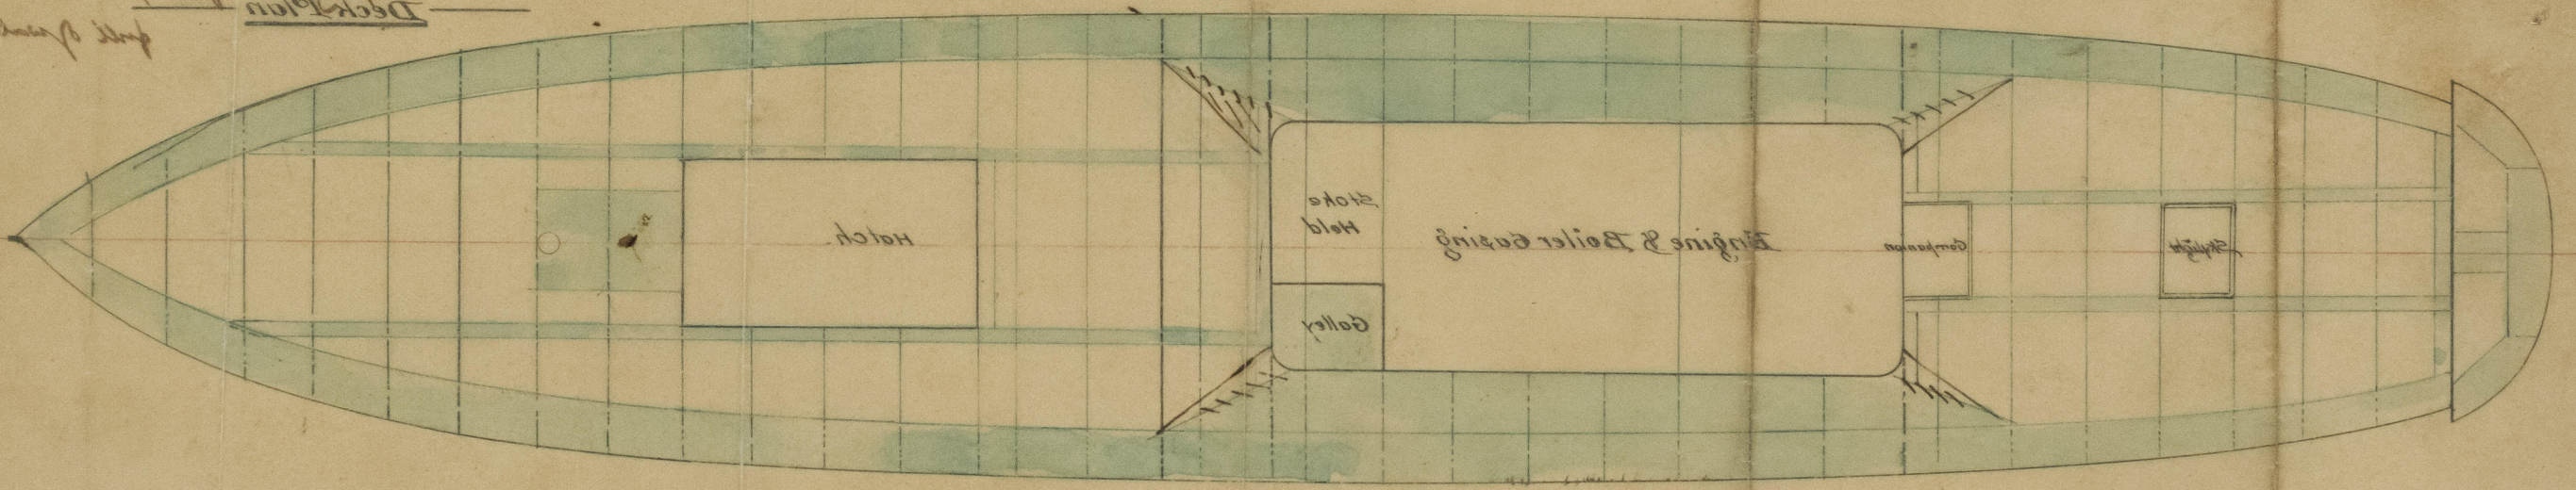

21/9/89

3/10/89

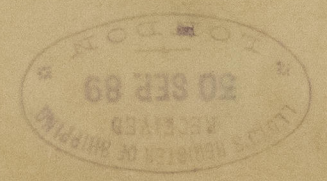

© 2021
 Lloyd's Register
 Foundation

1110-815237

1110-815237