

Lloyd's Register of British and Foreign Shipping.

(Report on Vessel No. 9830 Port Glasgow)
S. S. "Belle No. 2."

No. 2424 SHIP FORGINGS OR CASTINGS.

The words FORGINGS or CASTINGS, IRON or STEEL, should be struck out as may be required.

I have to report that the undermentioned Iron or Steel Forgings or Castings, manufactured by The Portland Forge Coy of Kilmarnock for the Vessel No. 78, being built by Messrs Scott & Coy of Bowling have been inspected by me as set forth below, and found to be, so far as can be seen, Sound & efficient



Mark on Forgings.

Lloyd's
 No. 2424
WH

William Hamilton
Glasgow
29/3/90

	STERN FRAME.	RUDDER FRAME.	STEM.
Material*	/	Scrap iron	/
How made		Forged	
Dimensions		diag 3 1/2 to 2	
Progress on Inspection		Forging & smithing	
Dates when Inspected		16.24/12/89. 20.28/3/90	

SKETCHES OF FRAMES SHEWING POSITION AND DESCRIPTION OF WELDS OF FORGINGS, OR PARTICULARS OF TESTS APPLIED TO CASTINGS.

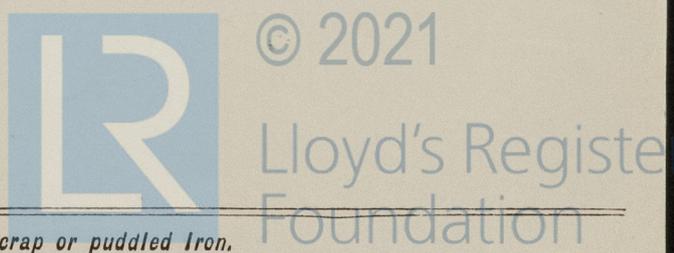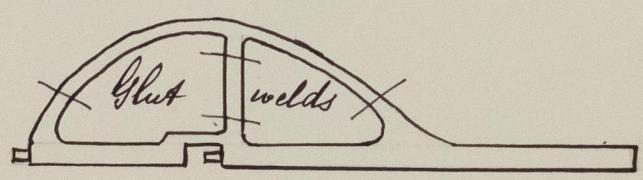

* If of Iron, state whether scrap or puddled Iron.