
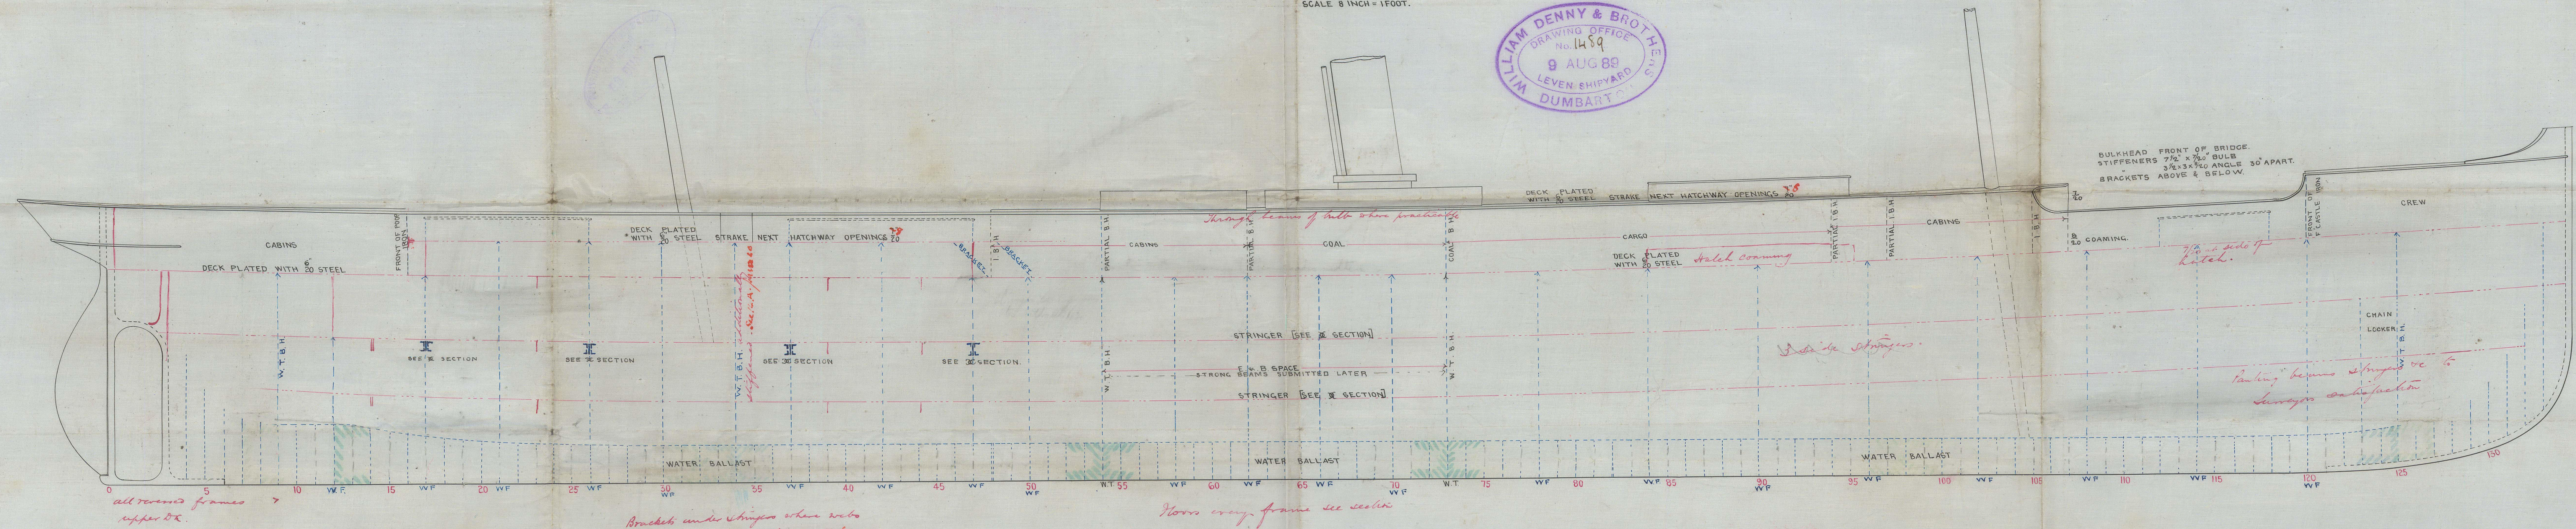


0.180 A. Head of Bridge "amidships" b.b.

FRI 16 AUG 89
FRI 13 SEP 89
MON 23 SEP 89

ELEVATION No 435.
SHOWING DISPOSITION OF DECK & STRINGERS
S. S. 270' x 37'-6" x 21'-9".
SCALE 1/8" INCH = 1 FOOT.

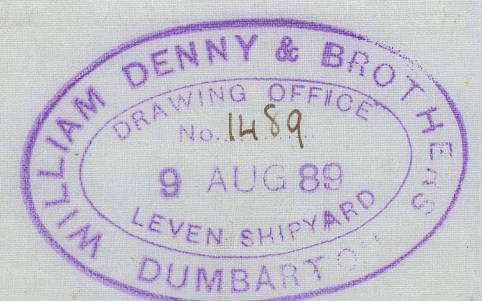

*all reverse frames
upper 100'*
See letter 16/8/89

*Brackets under stringers where webs
are 5 spaces apart. Sec. 14.A. para. 7.*

Flows every frame see section

BULKHEAD FRONT OF BRIDGE.
STIFFENERS 7/2" x 7/16" BULB
3/8" x 3/4" ANGLE 30' APART.
BRACKETS ABOVE & BELOW.

CREW

CHAIN
LOCKER

*7/8" side of
hatch.*

*Painting beams stringers &c to
surveys satisfaction*

S. S. "Rotokino" Glasgow Report No. 9840. —

ELEVATION No. 432

SHOWING DISPOSITION OF DECK & STRINGERS

S.S. 270' x 37'-6" x 21'-9"

SCALE 1/8" = 1'-0"

