

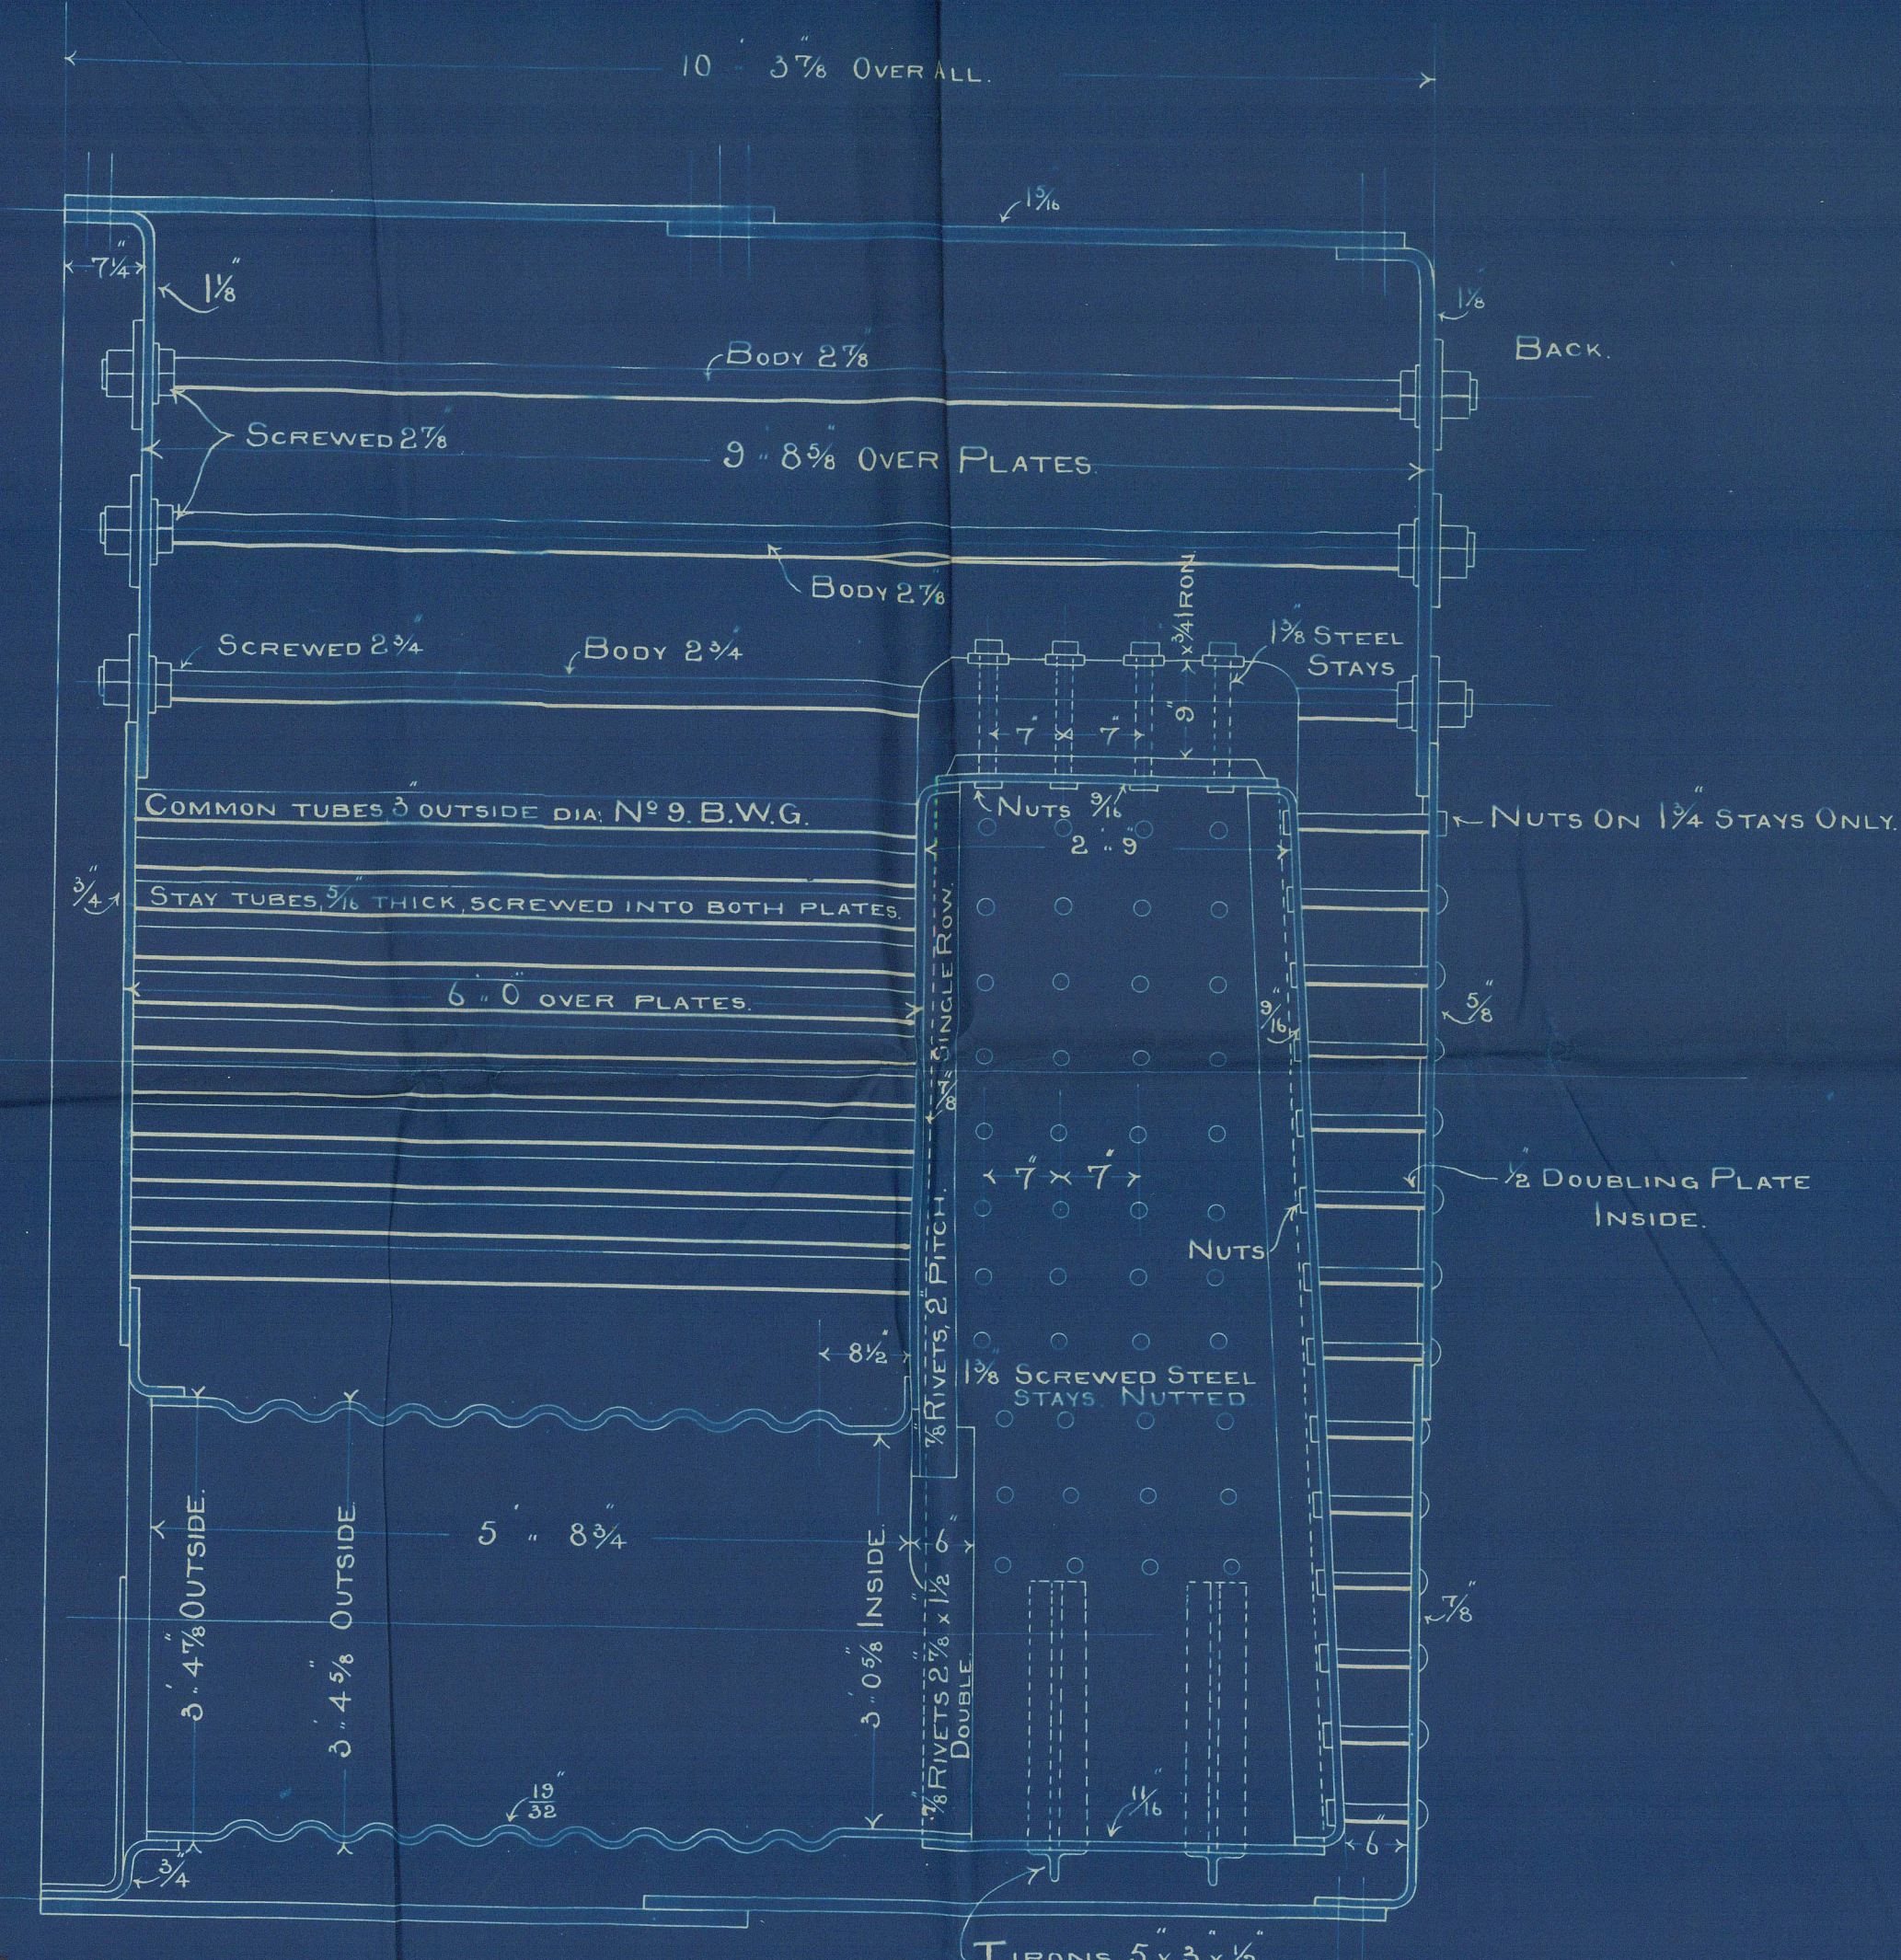
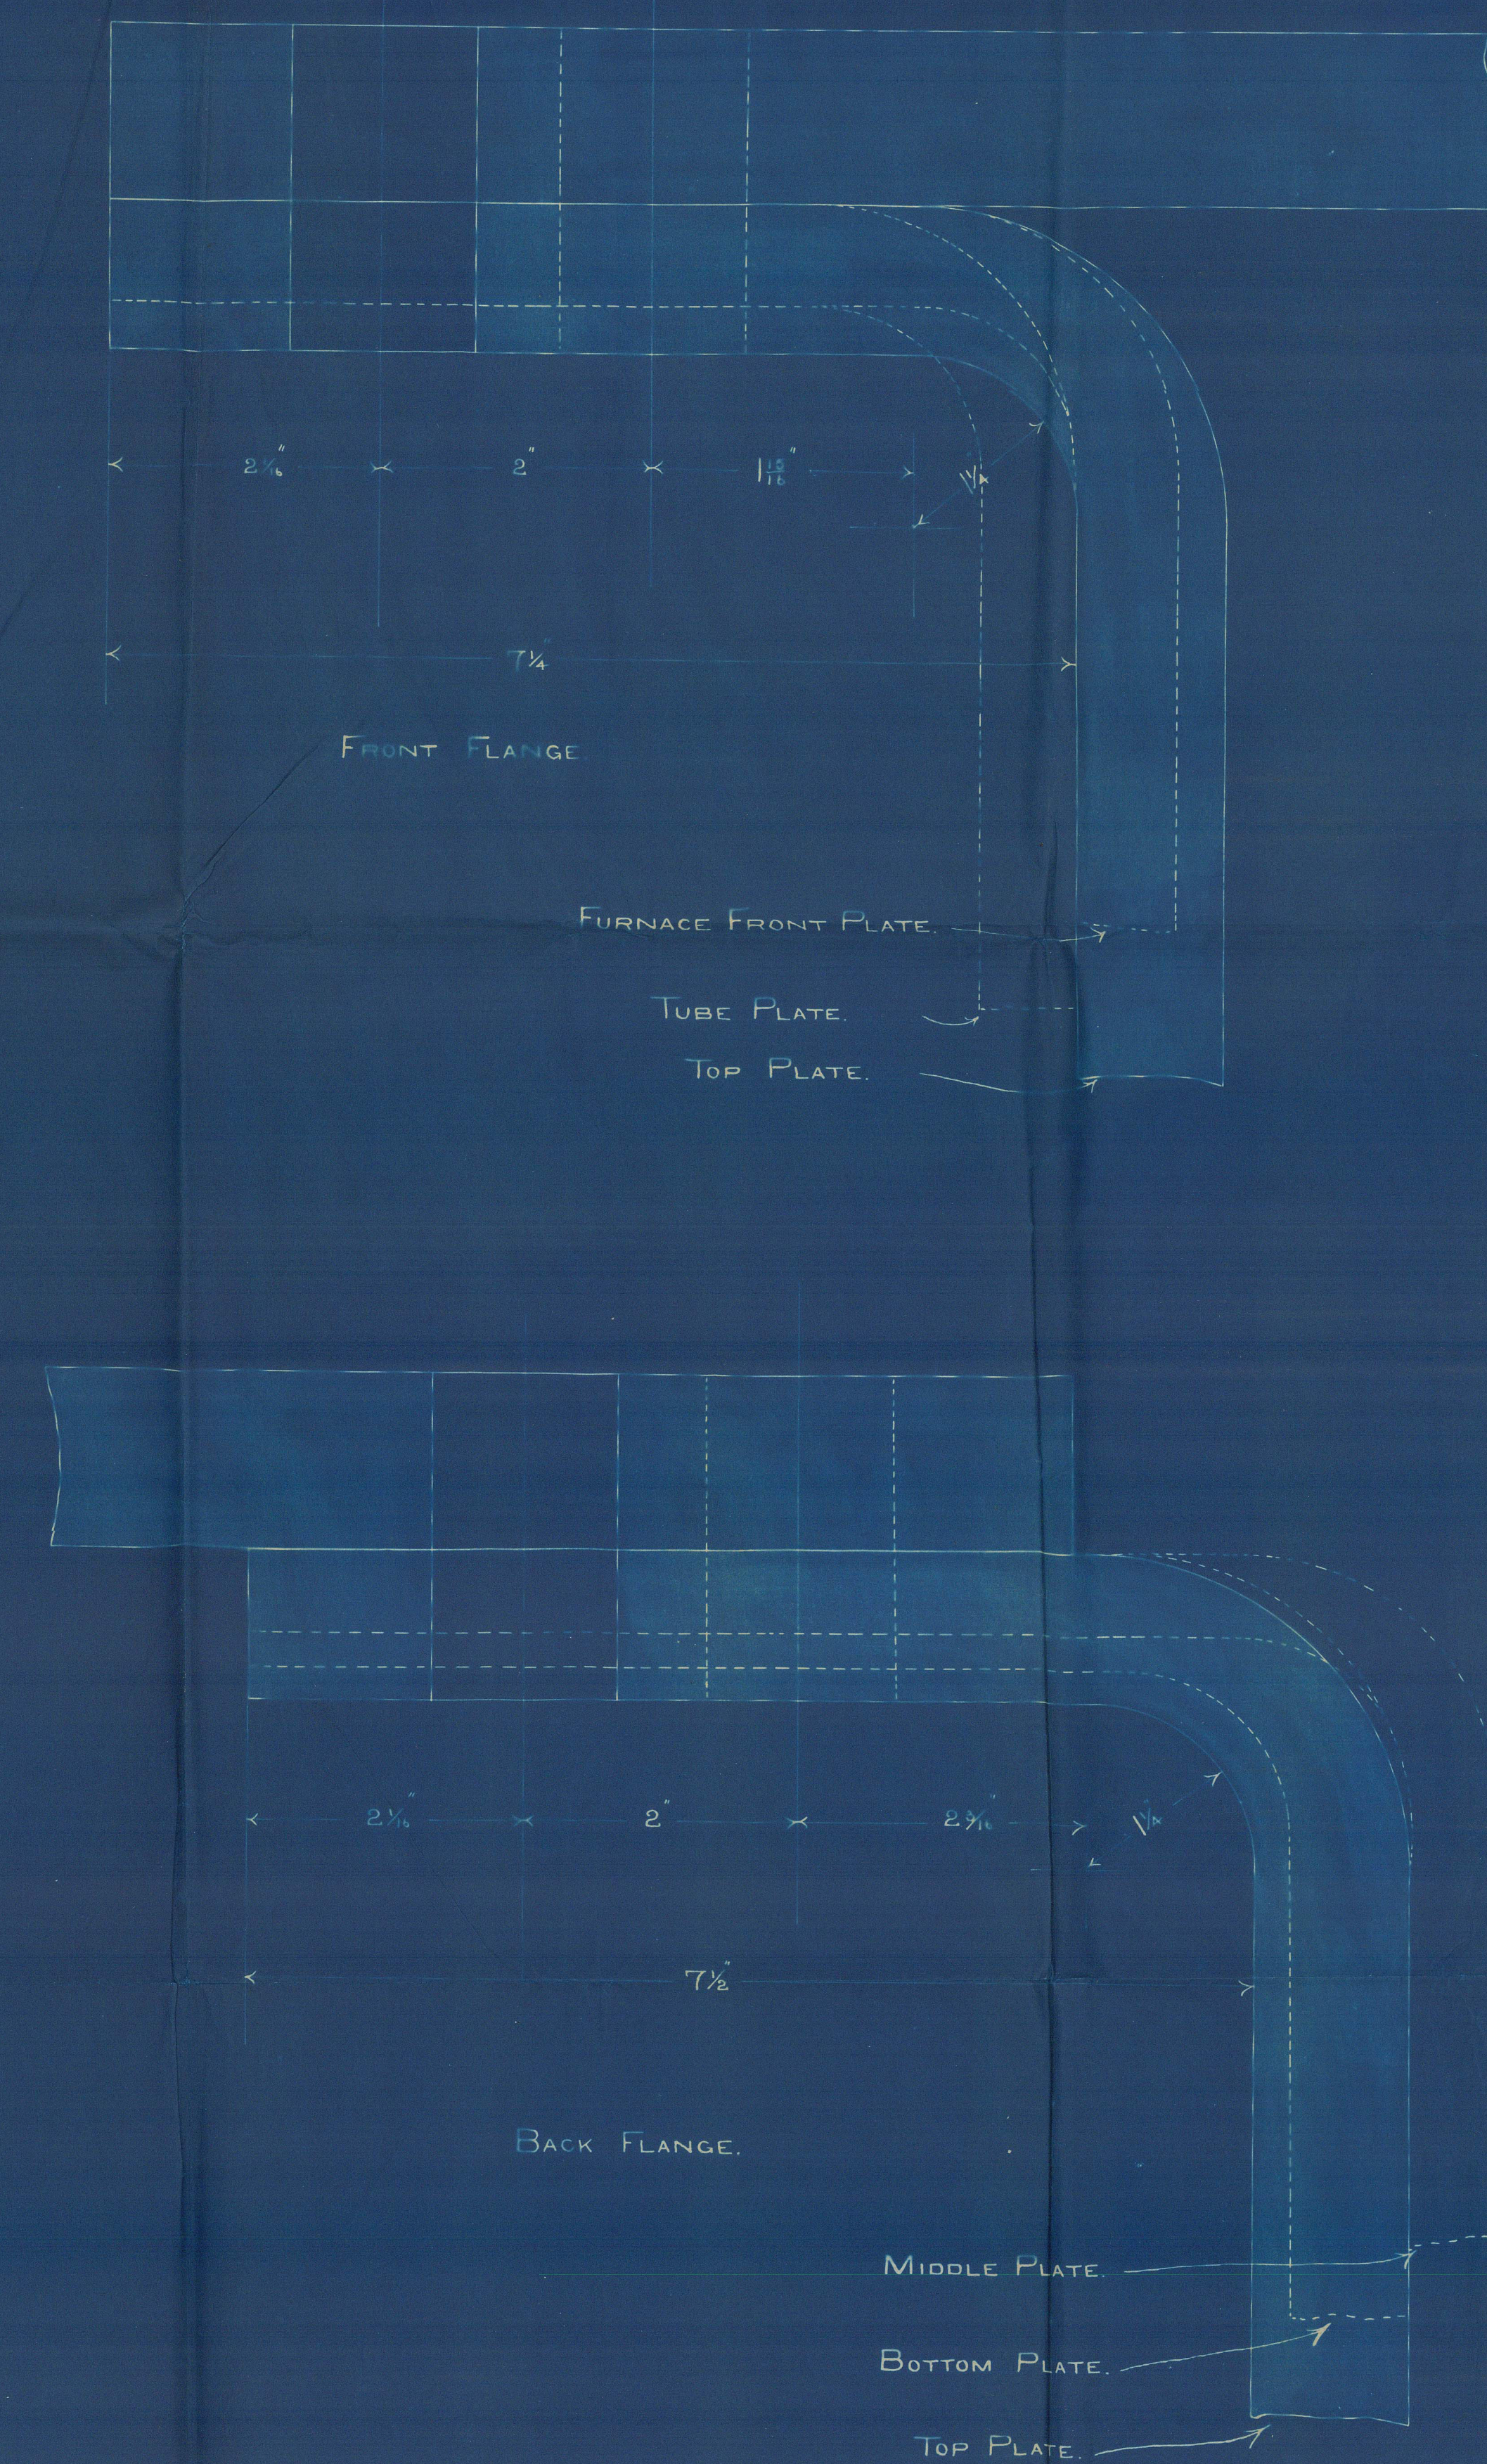
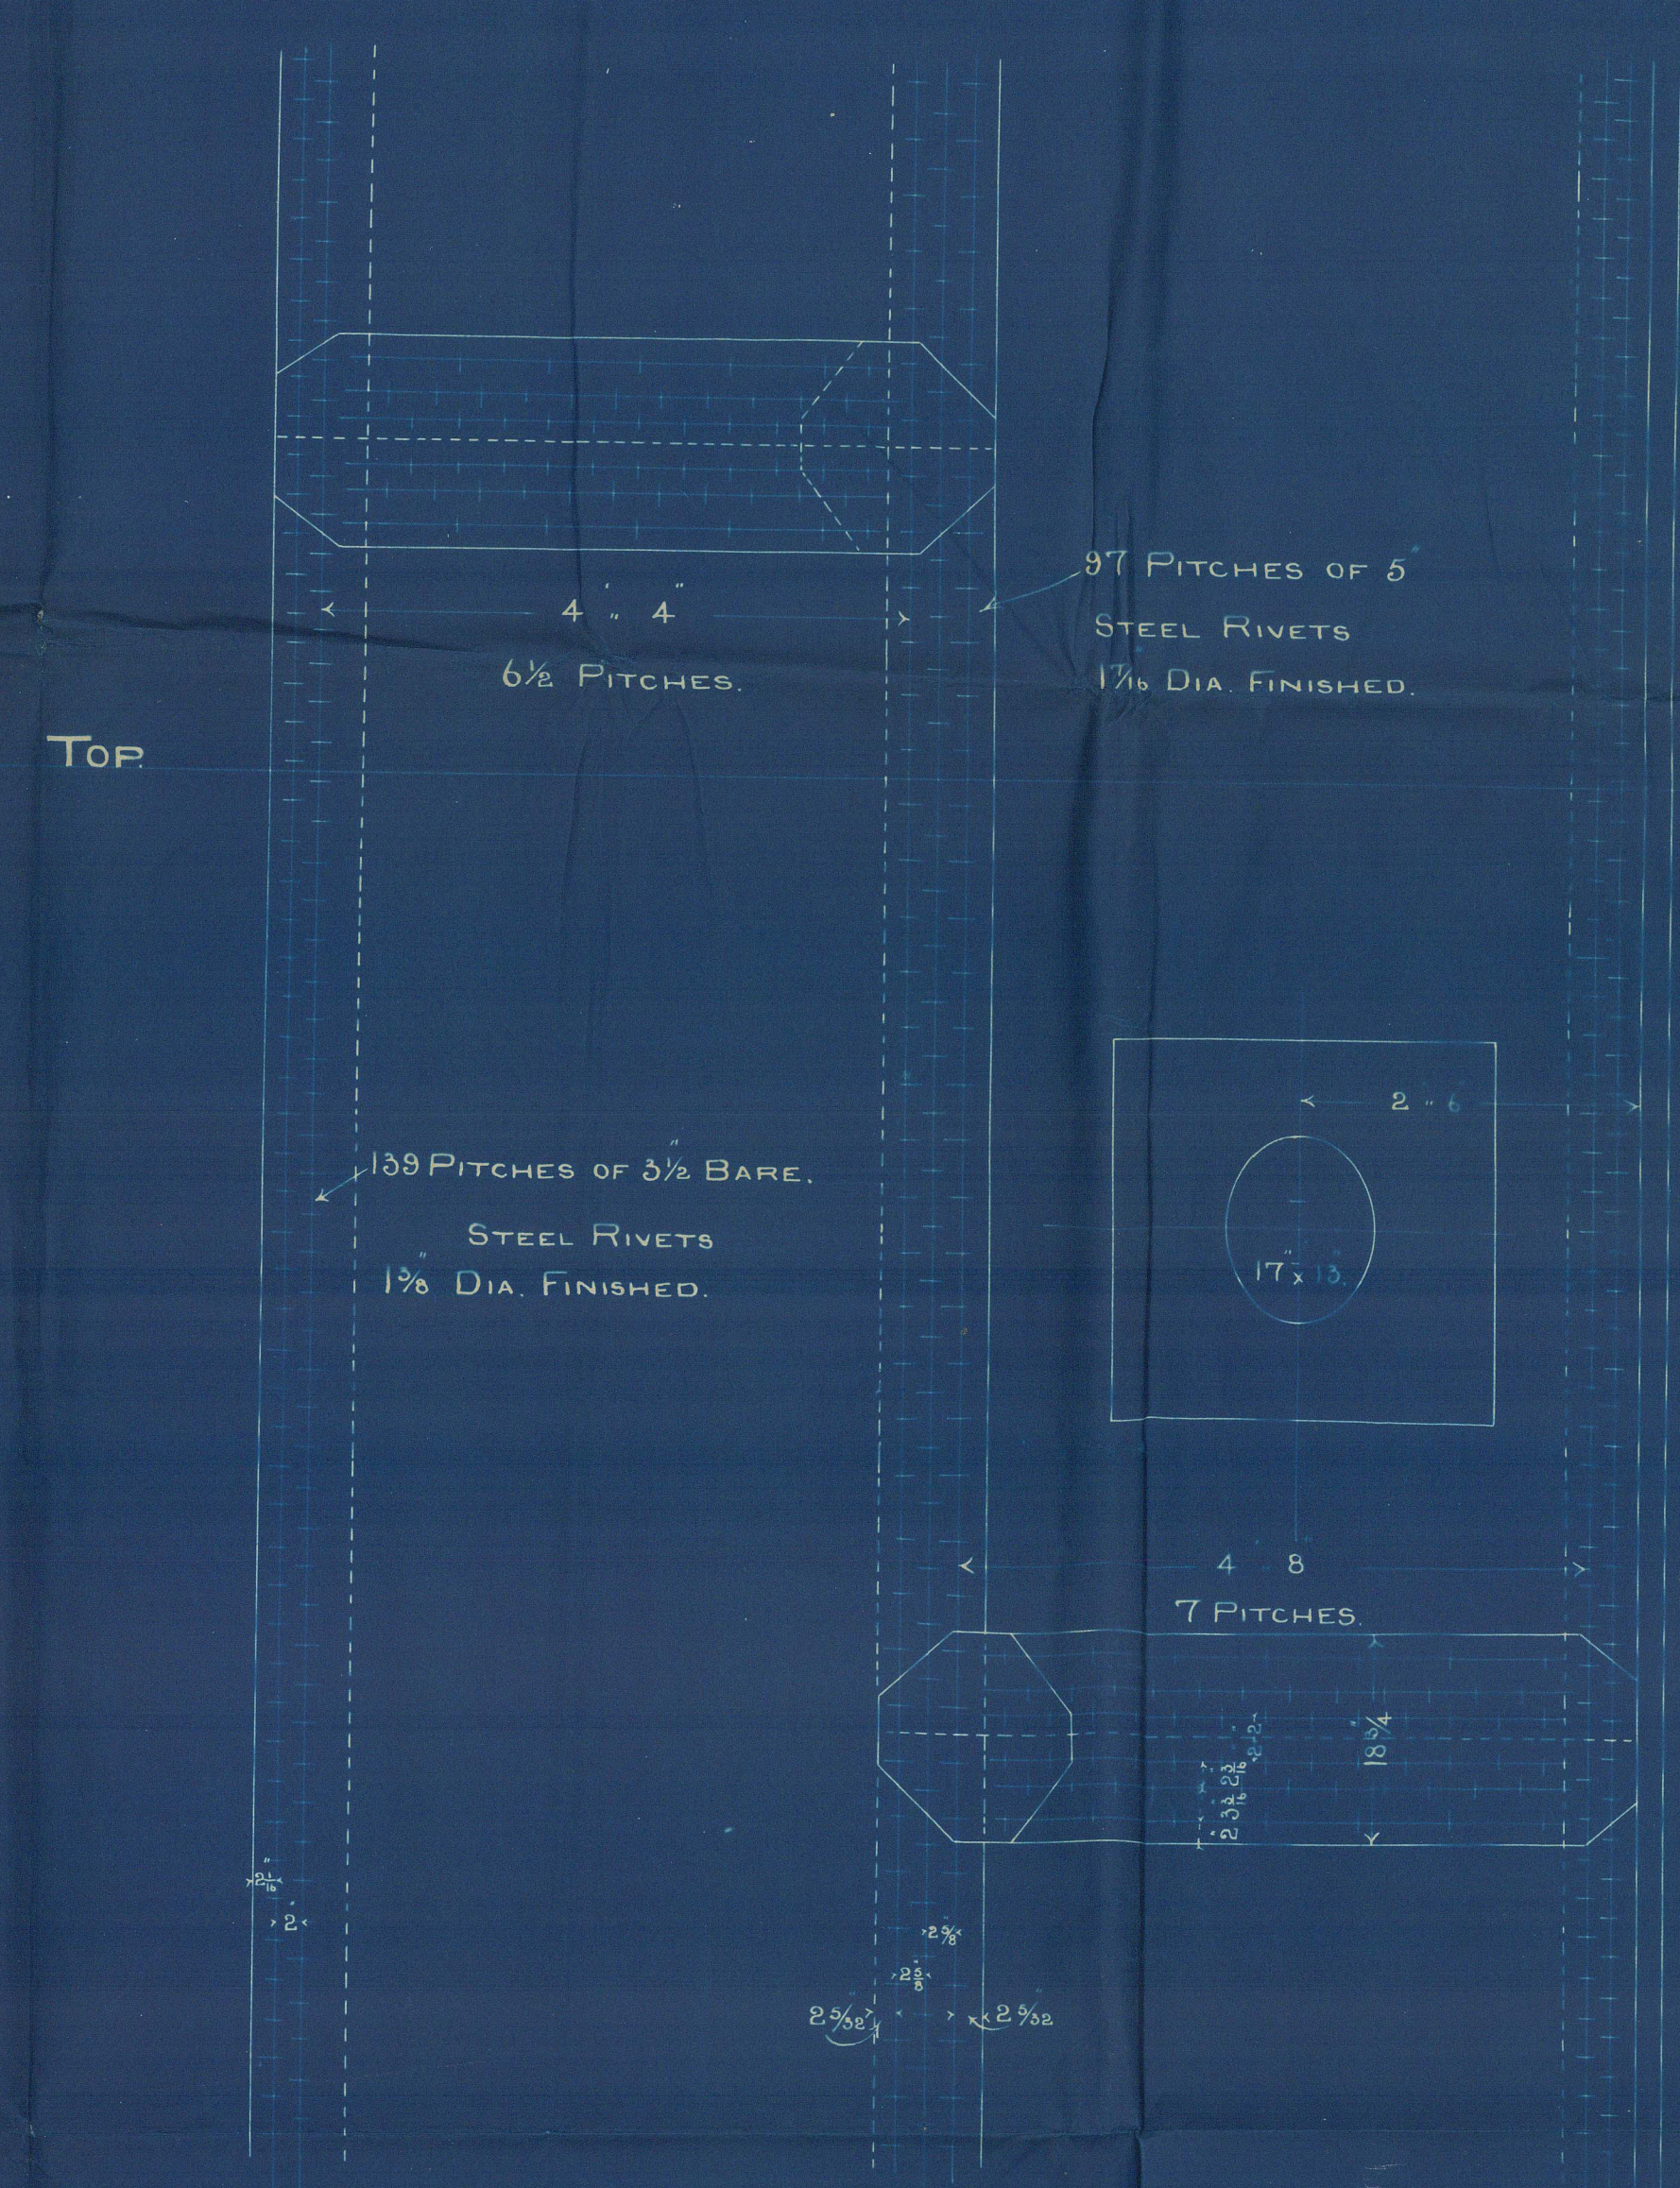


26 30/9/19

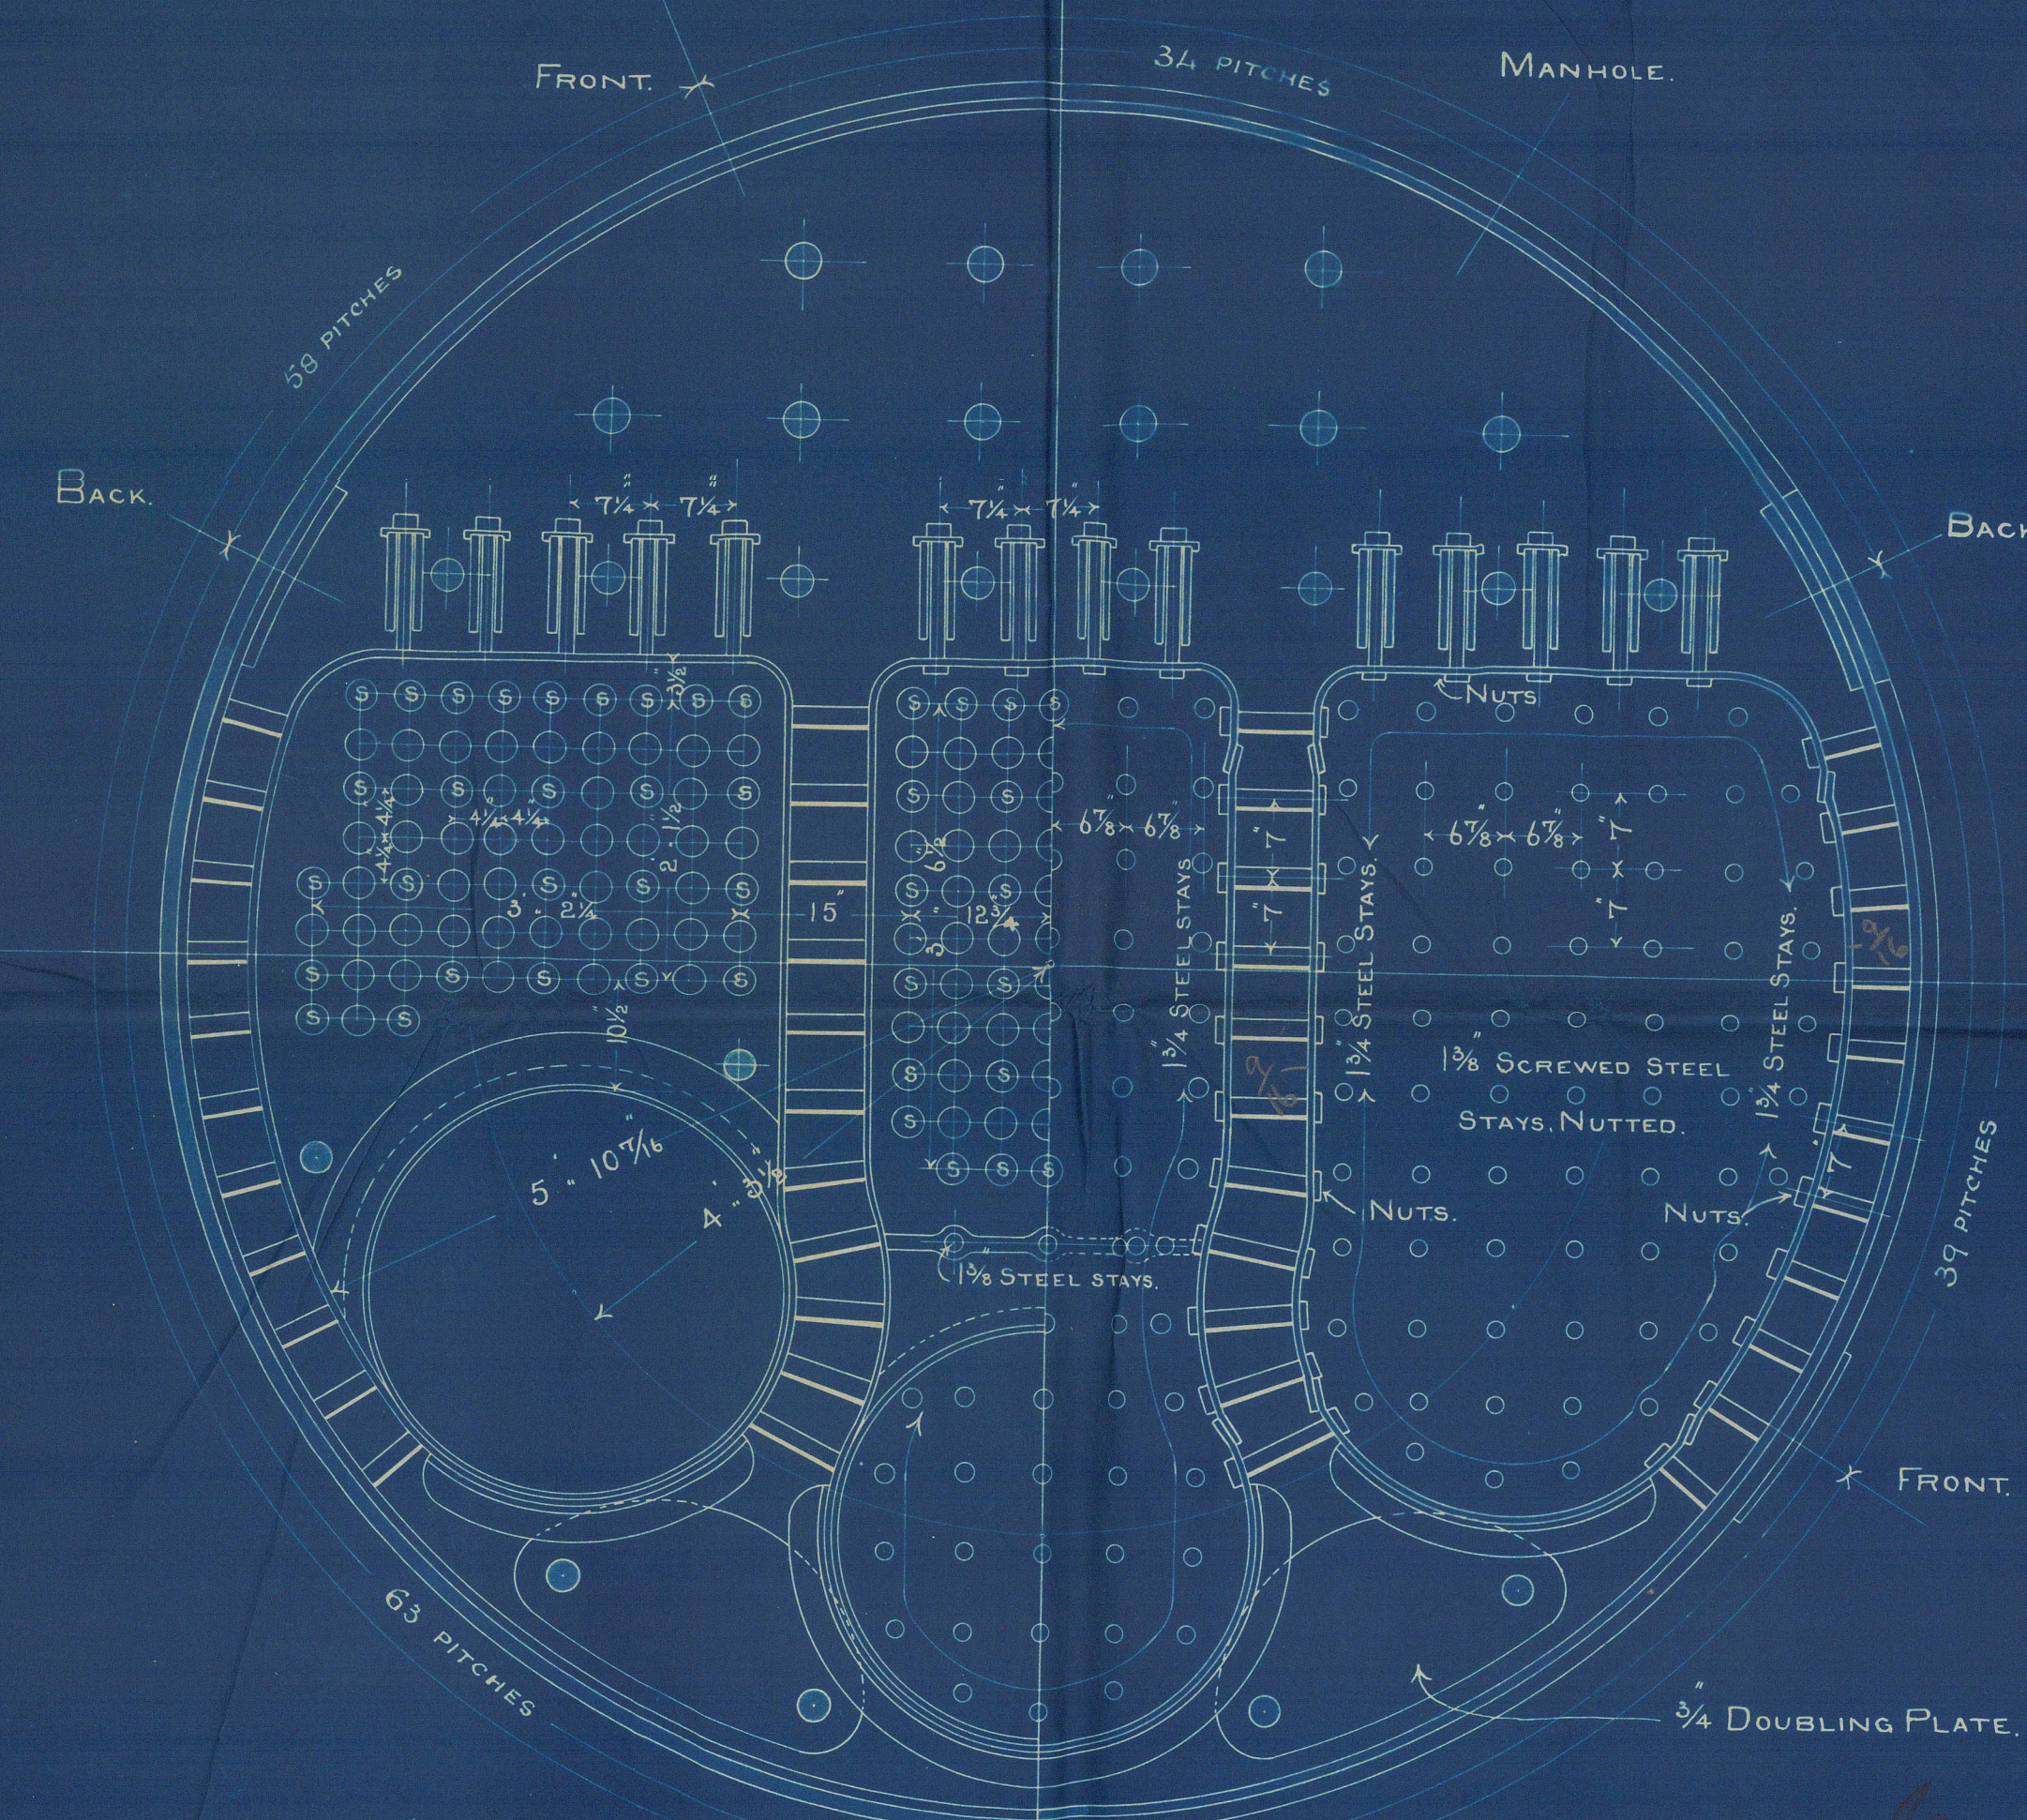

LINE OF JOINT.
BUTT STRAPS 18 3/4 x 1 1/2 x 1 1/2.
PLATE 80.5 5/8
RIVET FS 82-6 5
COVERING PLATES 1 1/2

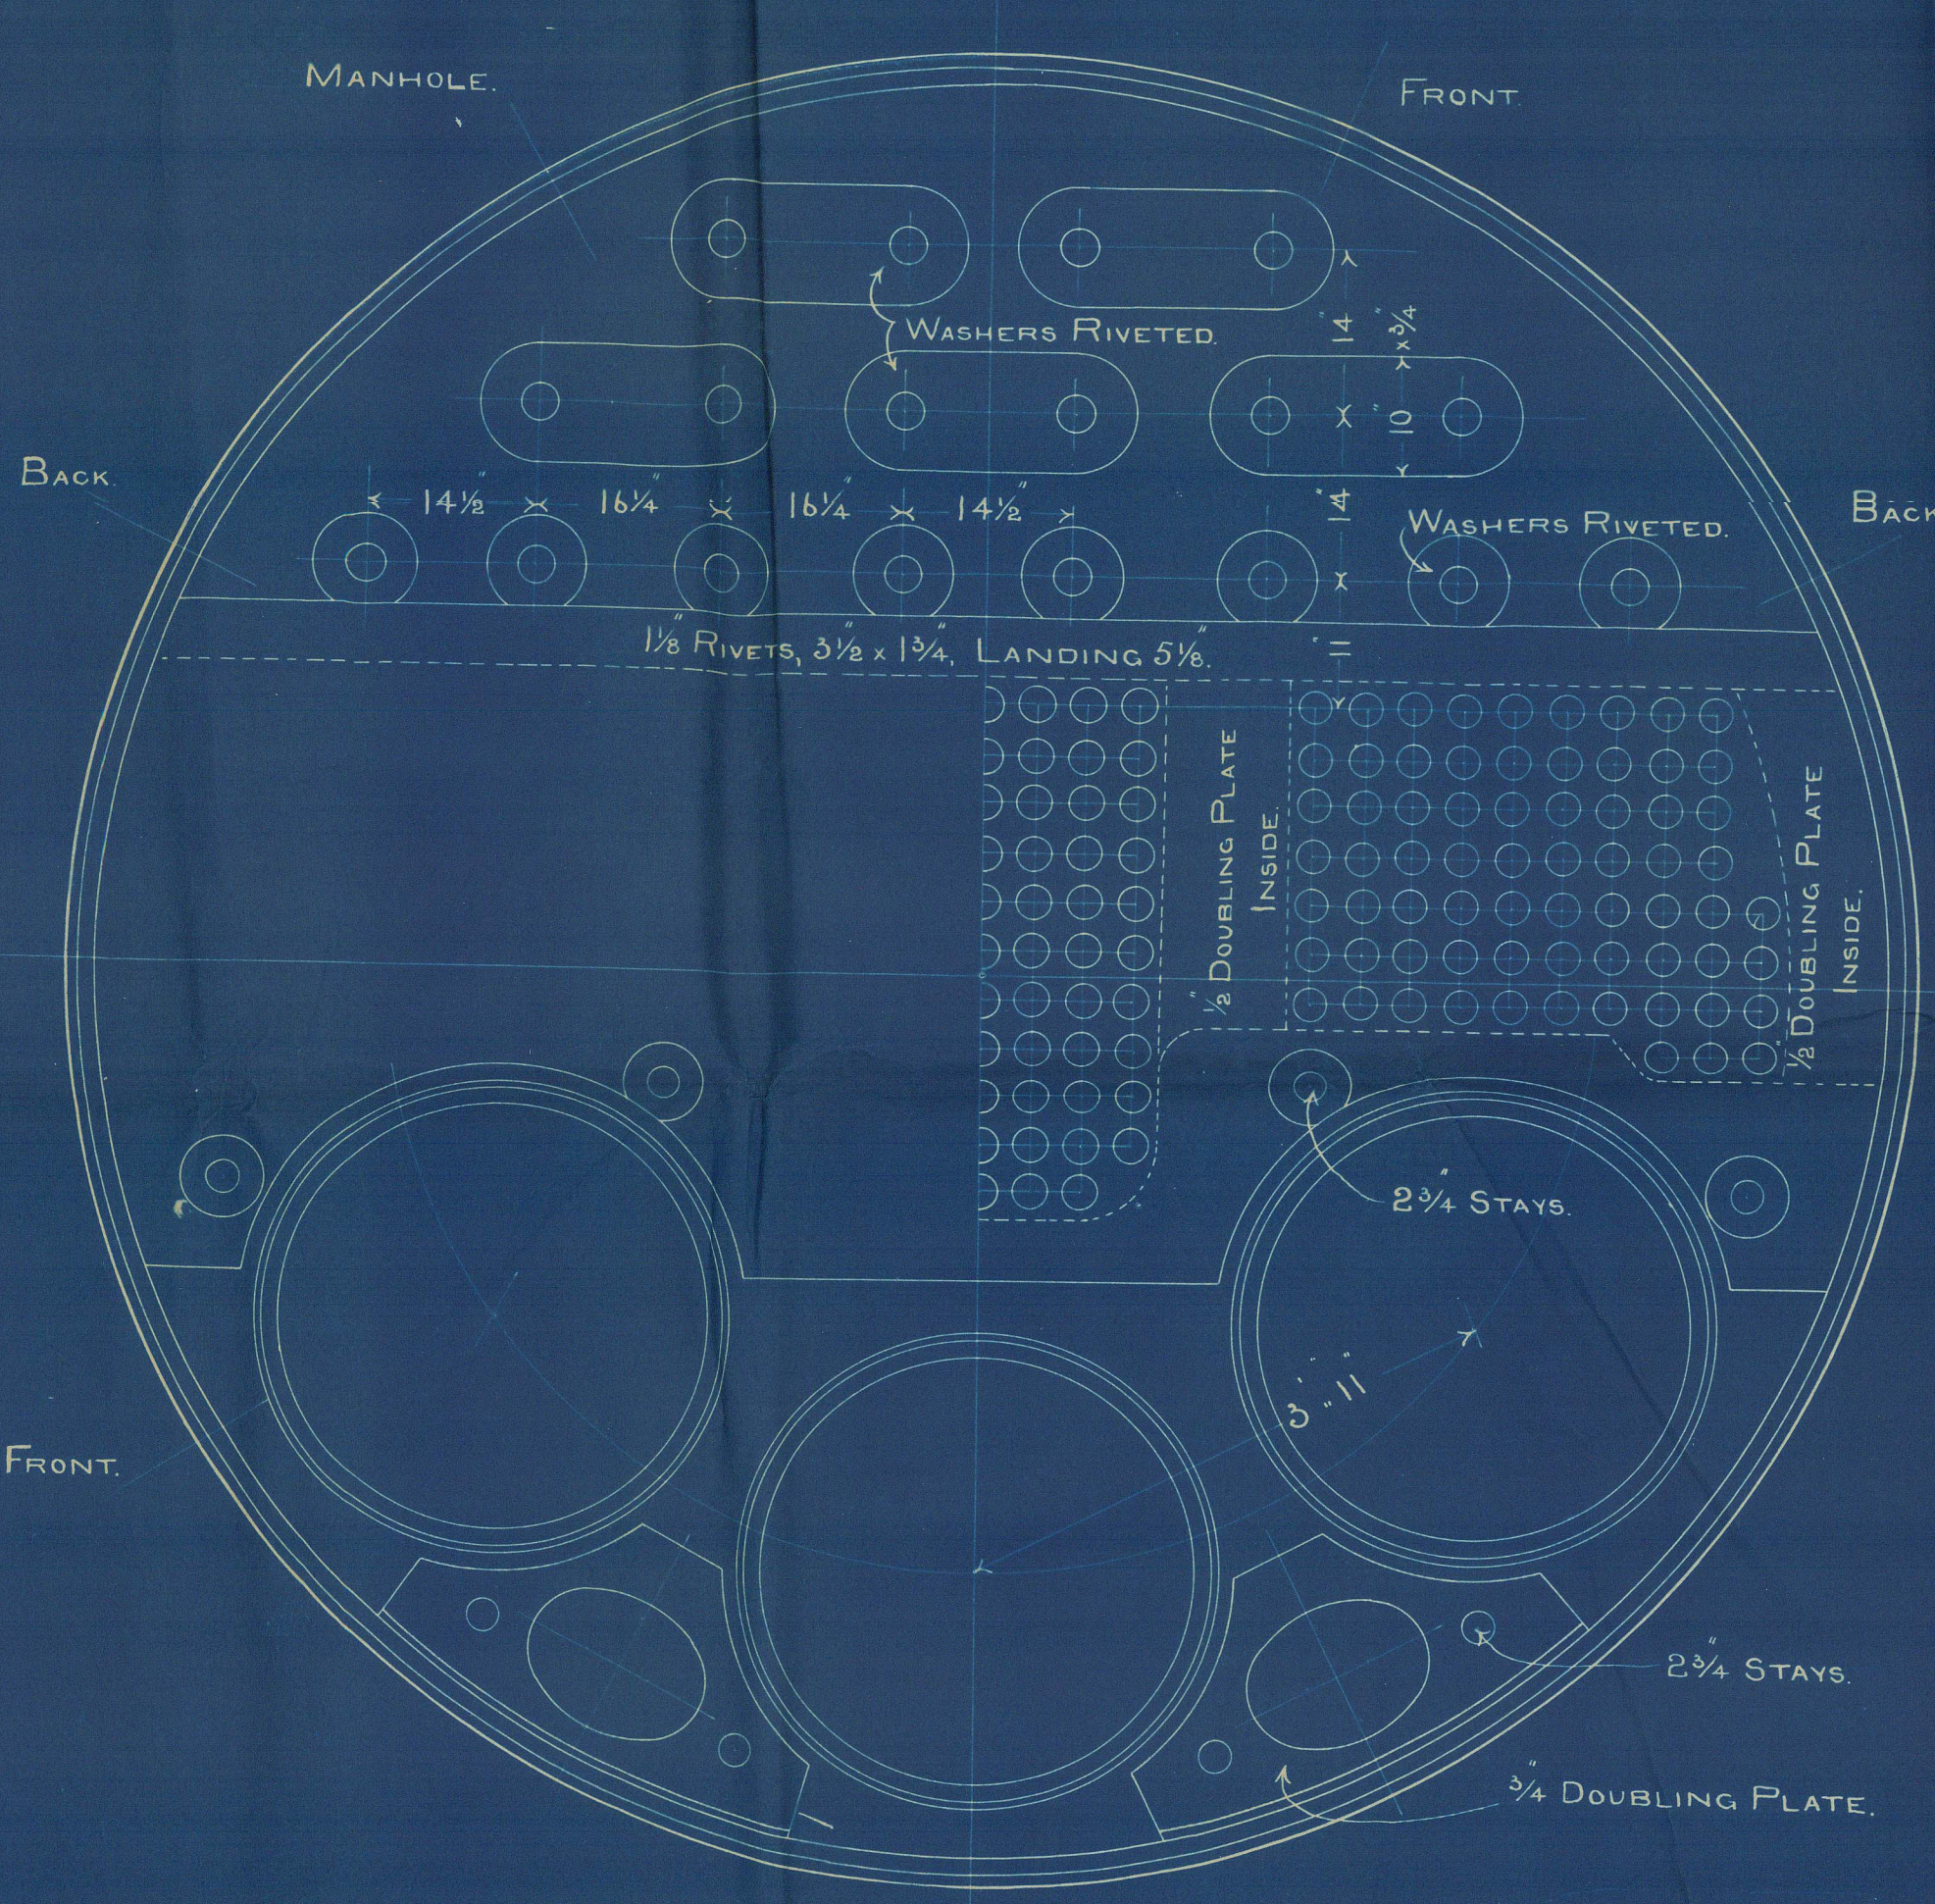

FOR TWO BOILERS

TOTAL NUMBER OF COMMON TUBES	262
STAY	164
TUBES	426
SURFACE OF ONE TUBE	4.71 Sq. Ft.
TOTAL TUBE SURFACE	2006.4 Sq. Ft.
FLUE	580.6
HEATING	2587
AREA OF FIREGRATE	5.3 BARS. 100
THROUGH TUBES	16
OF UPTAKE	19.6
RATIO HEATING SURFACE TO FIREGRATE	25.8
FIREGRATE TO TUBE AREA	6.2
UPTAKE	5.1


WORKING PRESSURE 180 LBS.

24/9/19

S.S. "Rotokino"
Glasgow Report
No 9840.

Lenny Vbo

GLS218-0117

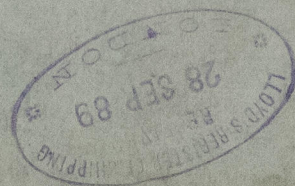

© 2021

Lloyd's Register
Foundation