



Mr. 2. 11. 89

Mr. 2. 11. 89

PUMPING ARRANGEMENT

S S N^o 435

SCALE $\frac{1}{8}$ INCH = 1 FOOT.

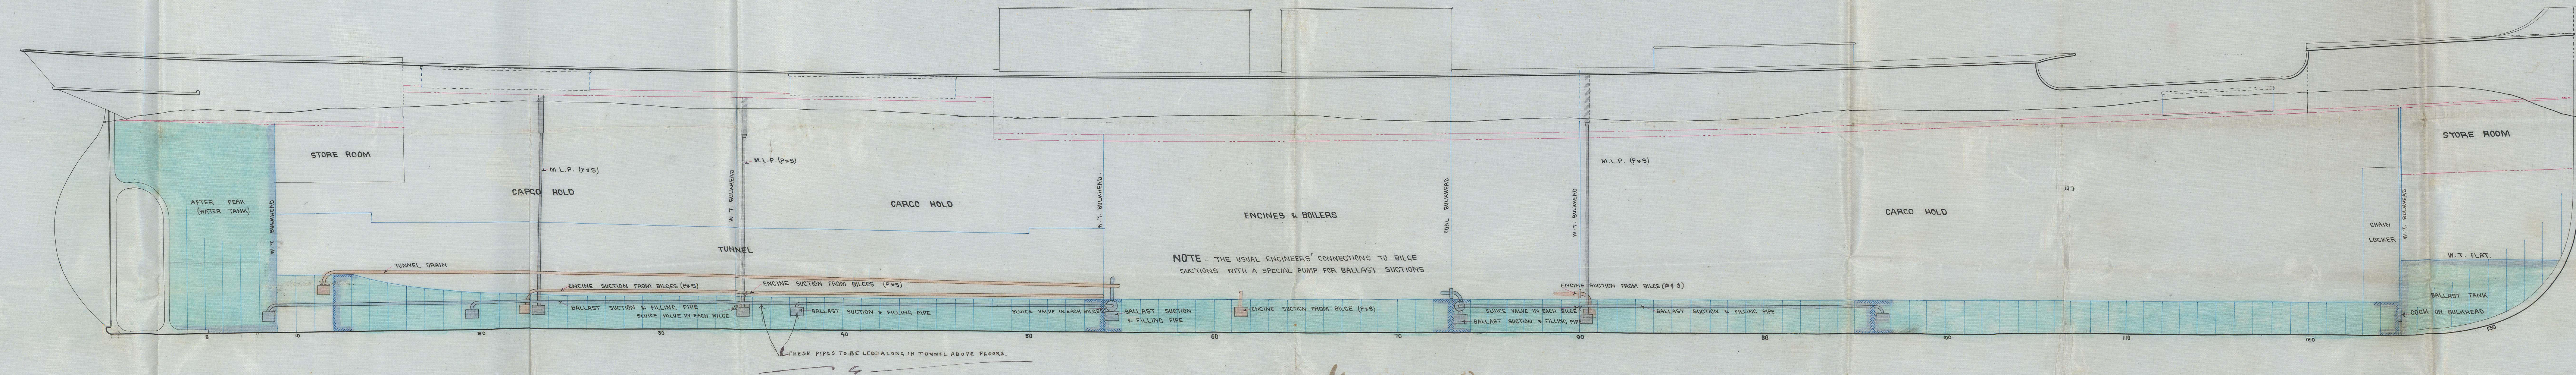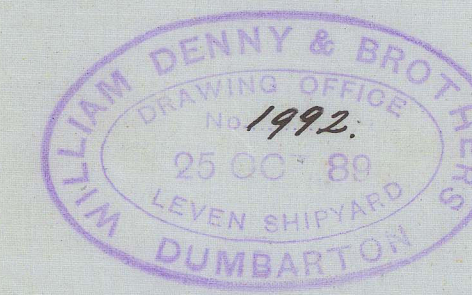

P.B. 11.1

Mr. 2. 11. 89
30/10/89
29/10/89

Mr. 2. 11. 89

18-11-89
W.D.M.



S. S. Rotokino
Glasgow Report
No. 9840.

FRIDAY 8 NOV 1889



© 2021

Lloyd's Register
Foundation

8110-812512