



POOP-X-QUARTER DECK

QUARTER DECK-X-BRIDGE


 


POOP, QUARTER-DECK, BRIDGE

AND FORECASTLE.

S. S. N° 435.

SCALE 1/4 INCH = 1 FOOT.

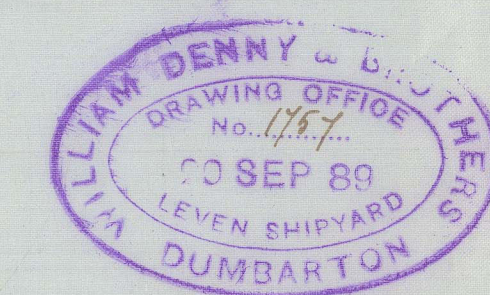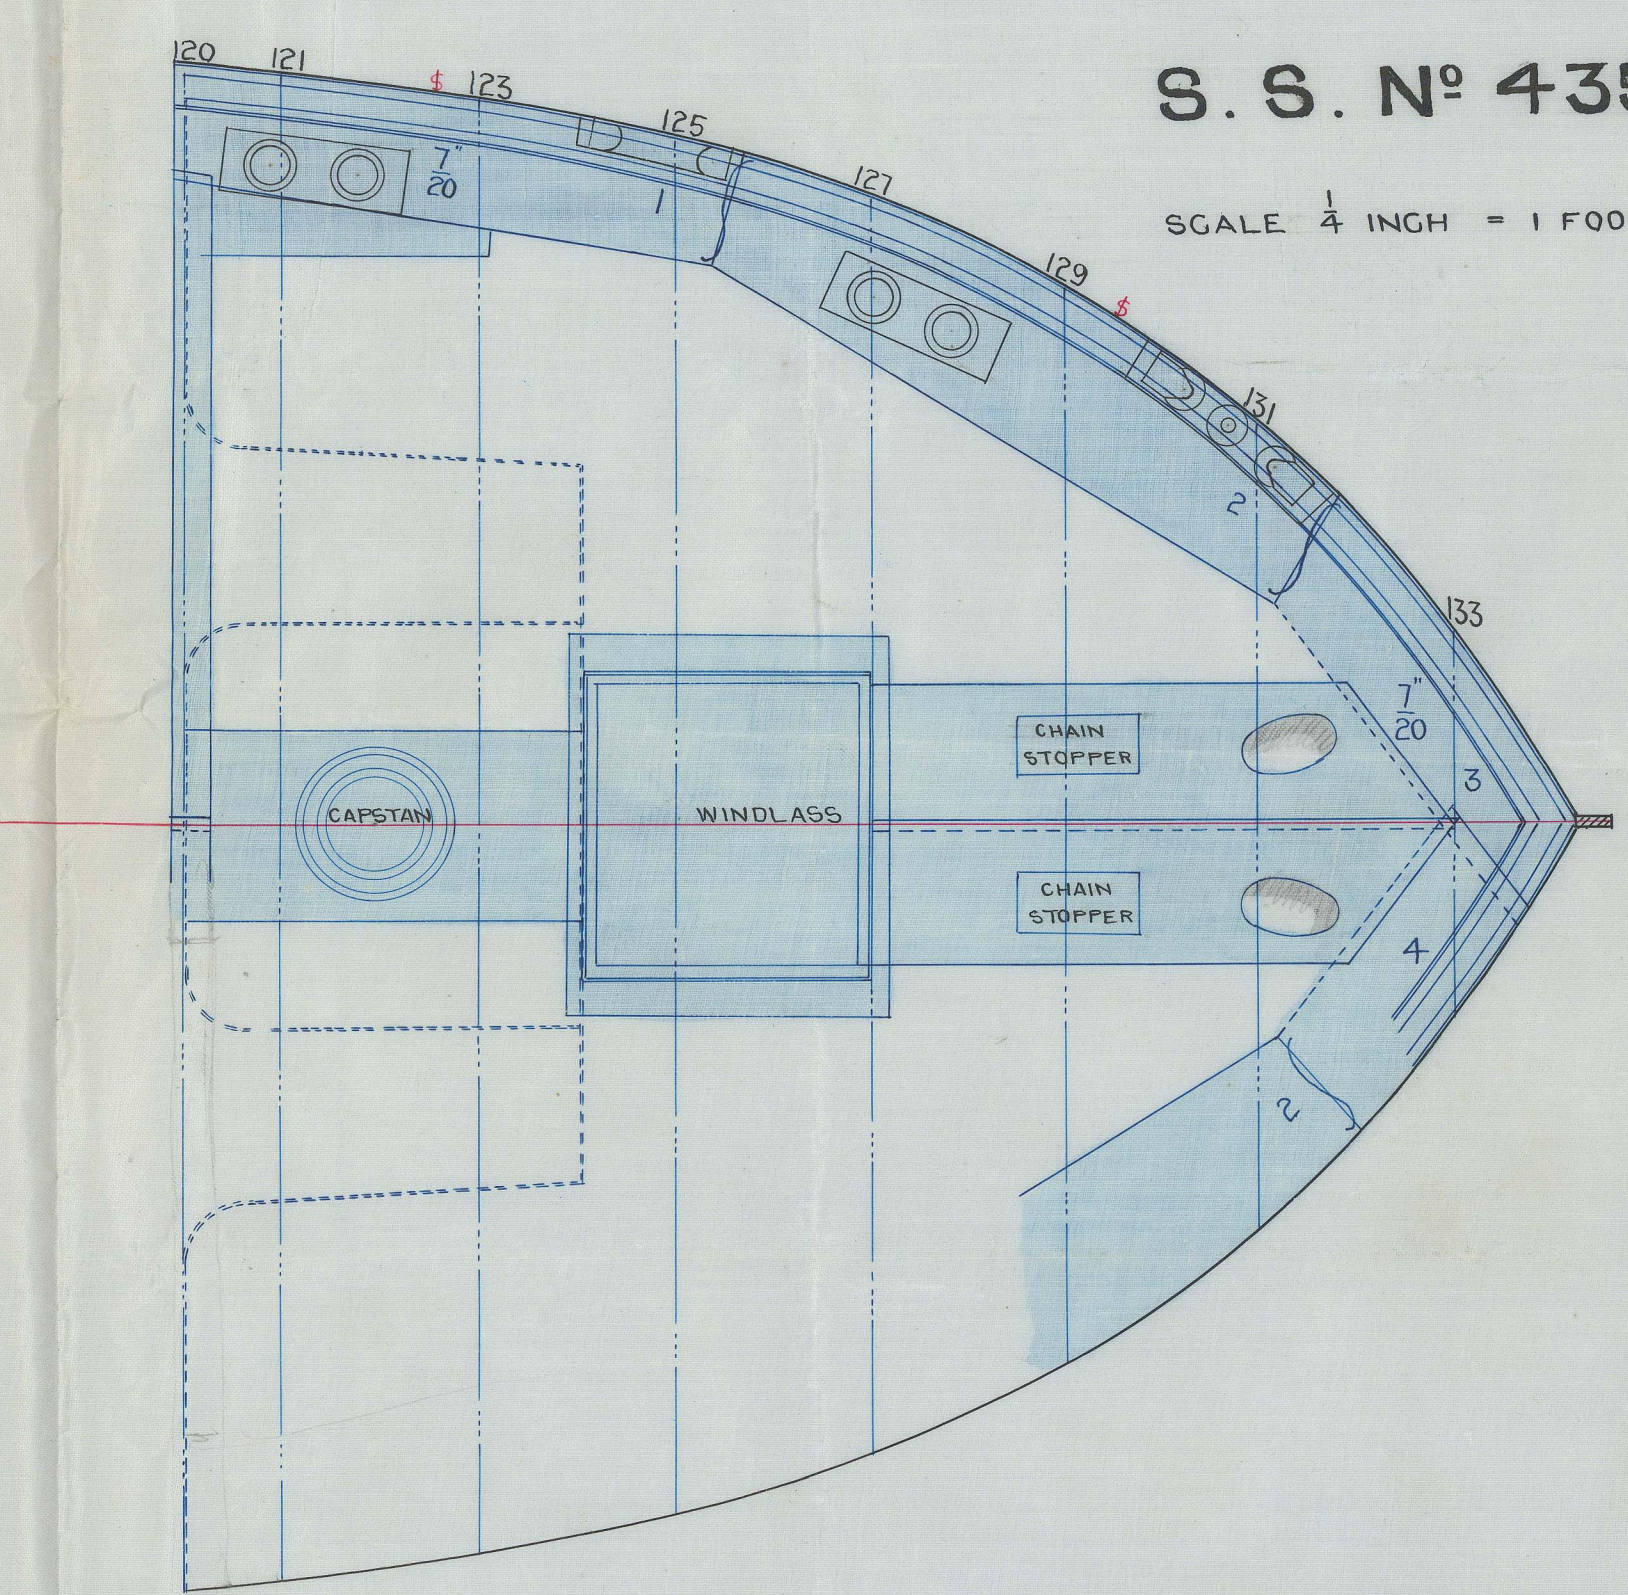

24.7.89



S.S. "Polokino" Glasgow Report No 9840.

4210-812574

QUARTER DECK-X-BRIDGE

POOP-X-QUARTER DECK

