

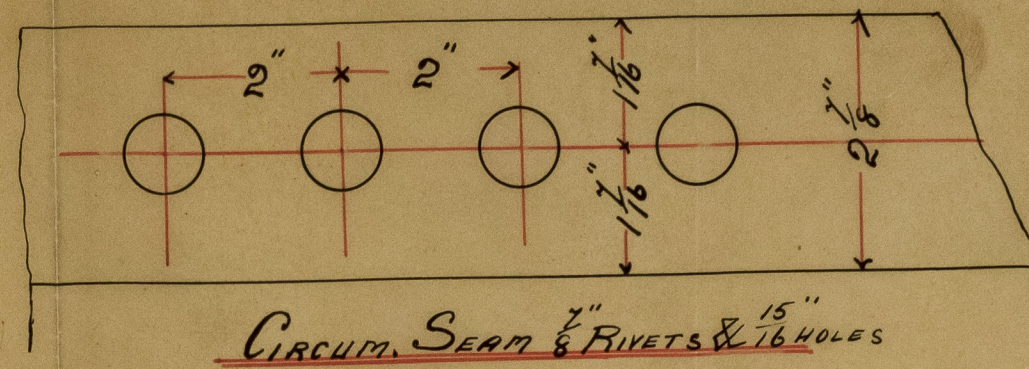


W. & A. R. & Co. Ltd.
 Glasgow & London
 1884

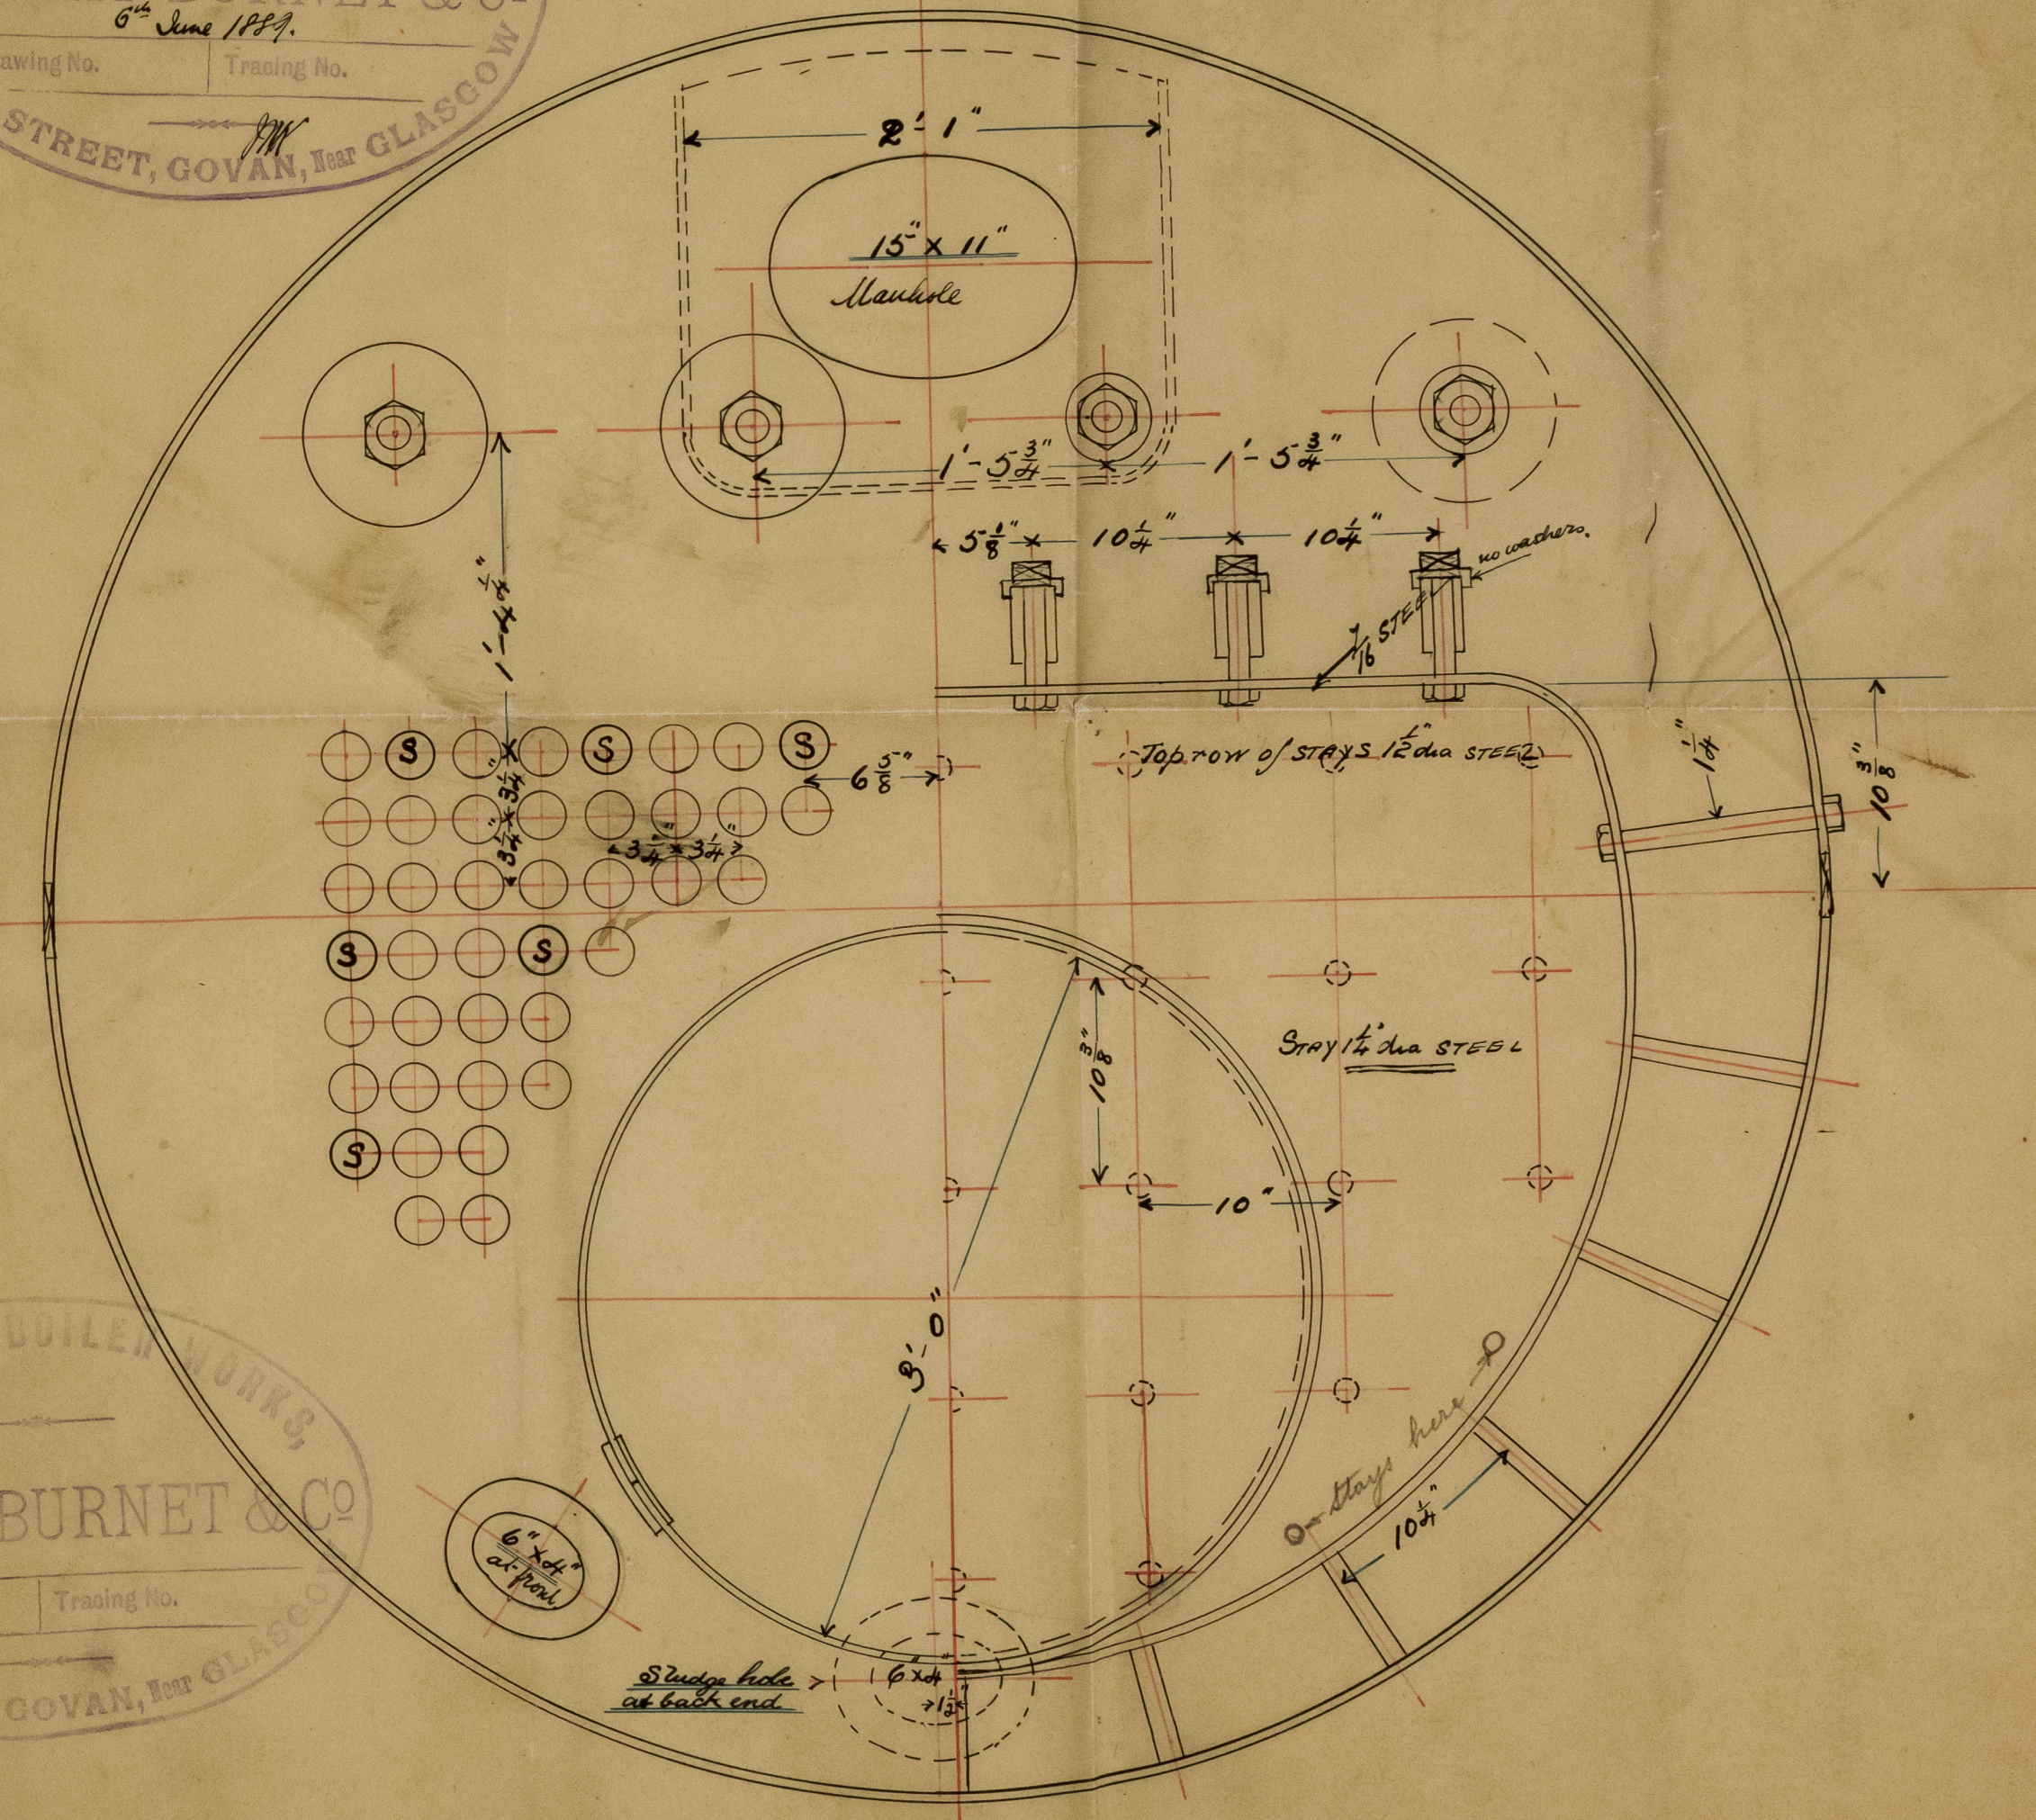





MOORE PARK BOILER WORKS,
LINDSAY BURNET & CO
 6th June 1884.
 Drawing No. Tracing No.
 HELEN STREET, GOVAN, NEAR GLASGOW

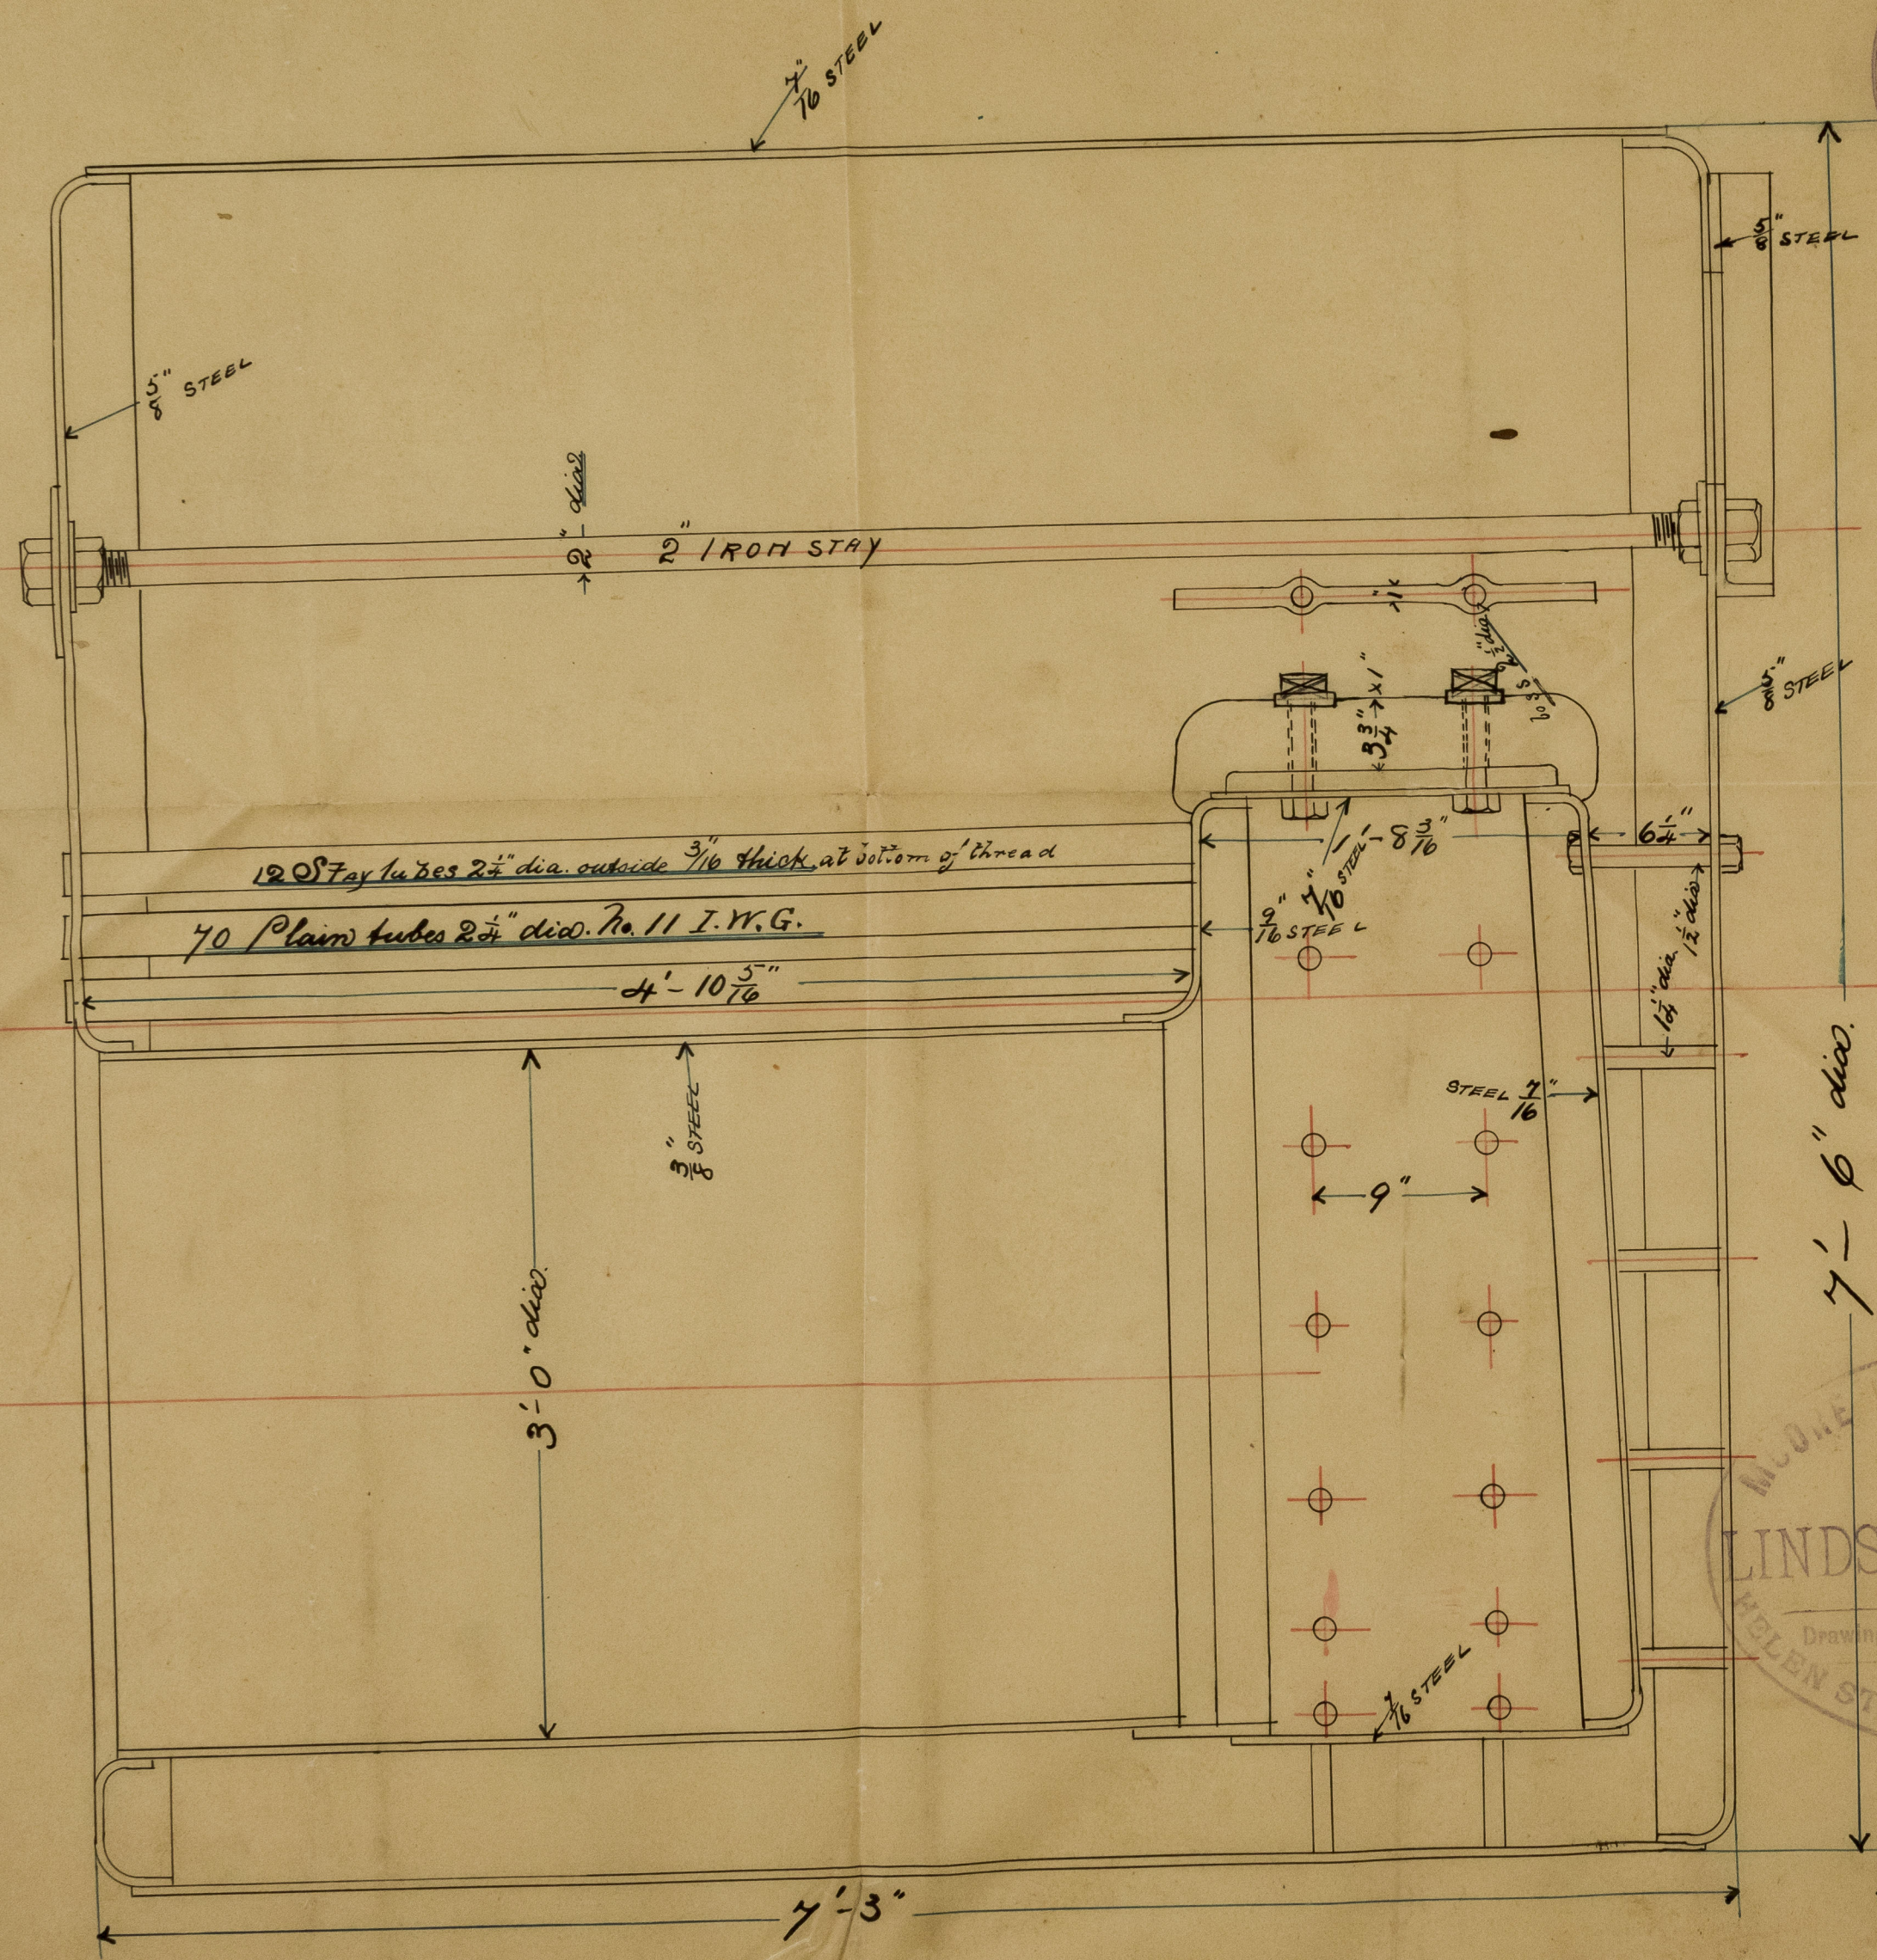

— **MARINE BOILER 7'-6" DIA X 7'-3" LONG** —
 — **WORKING PRESSURE = 50 lbs** —
 — **SCALE 1 1/2" = ONE FOOT** —
 — **BOILER NOS 308, 9 & 10** —
 — **Under LLOYD'S SURVEY** —

Winch Boilers
for Cumberland
Dredger & Dredger

Boiler S. S. Cumberland
Glasgow Report No. 9845.

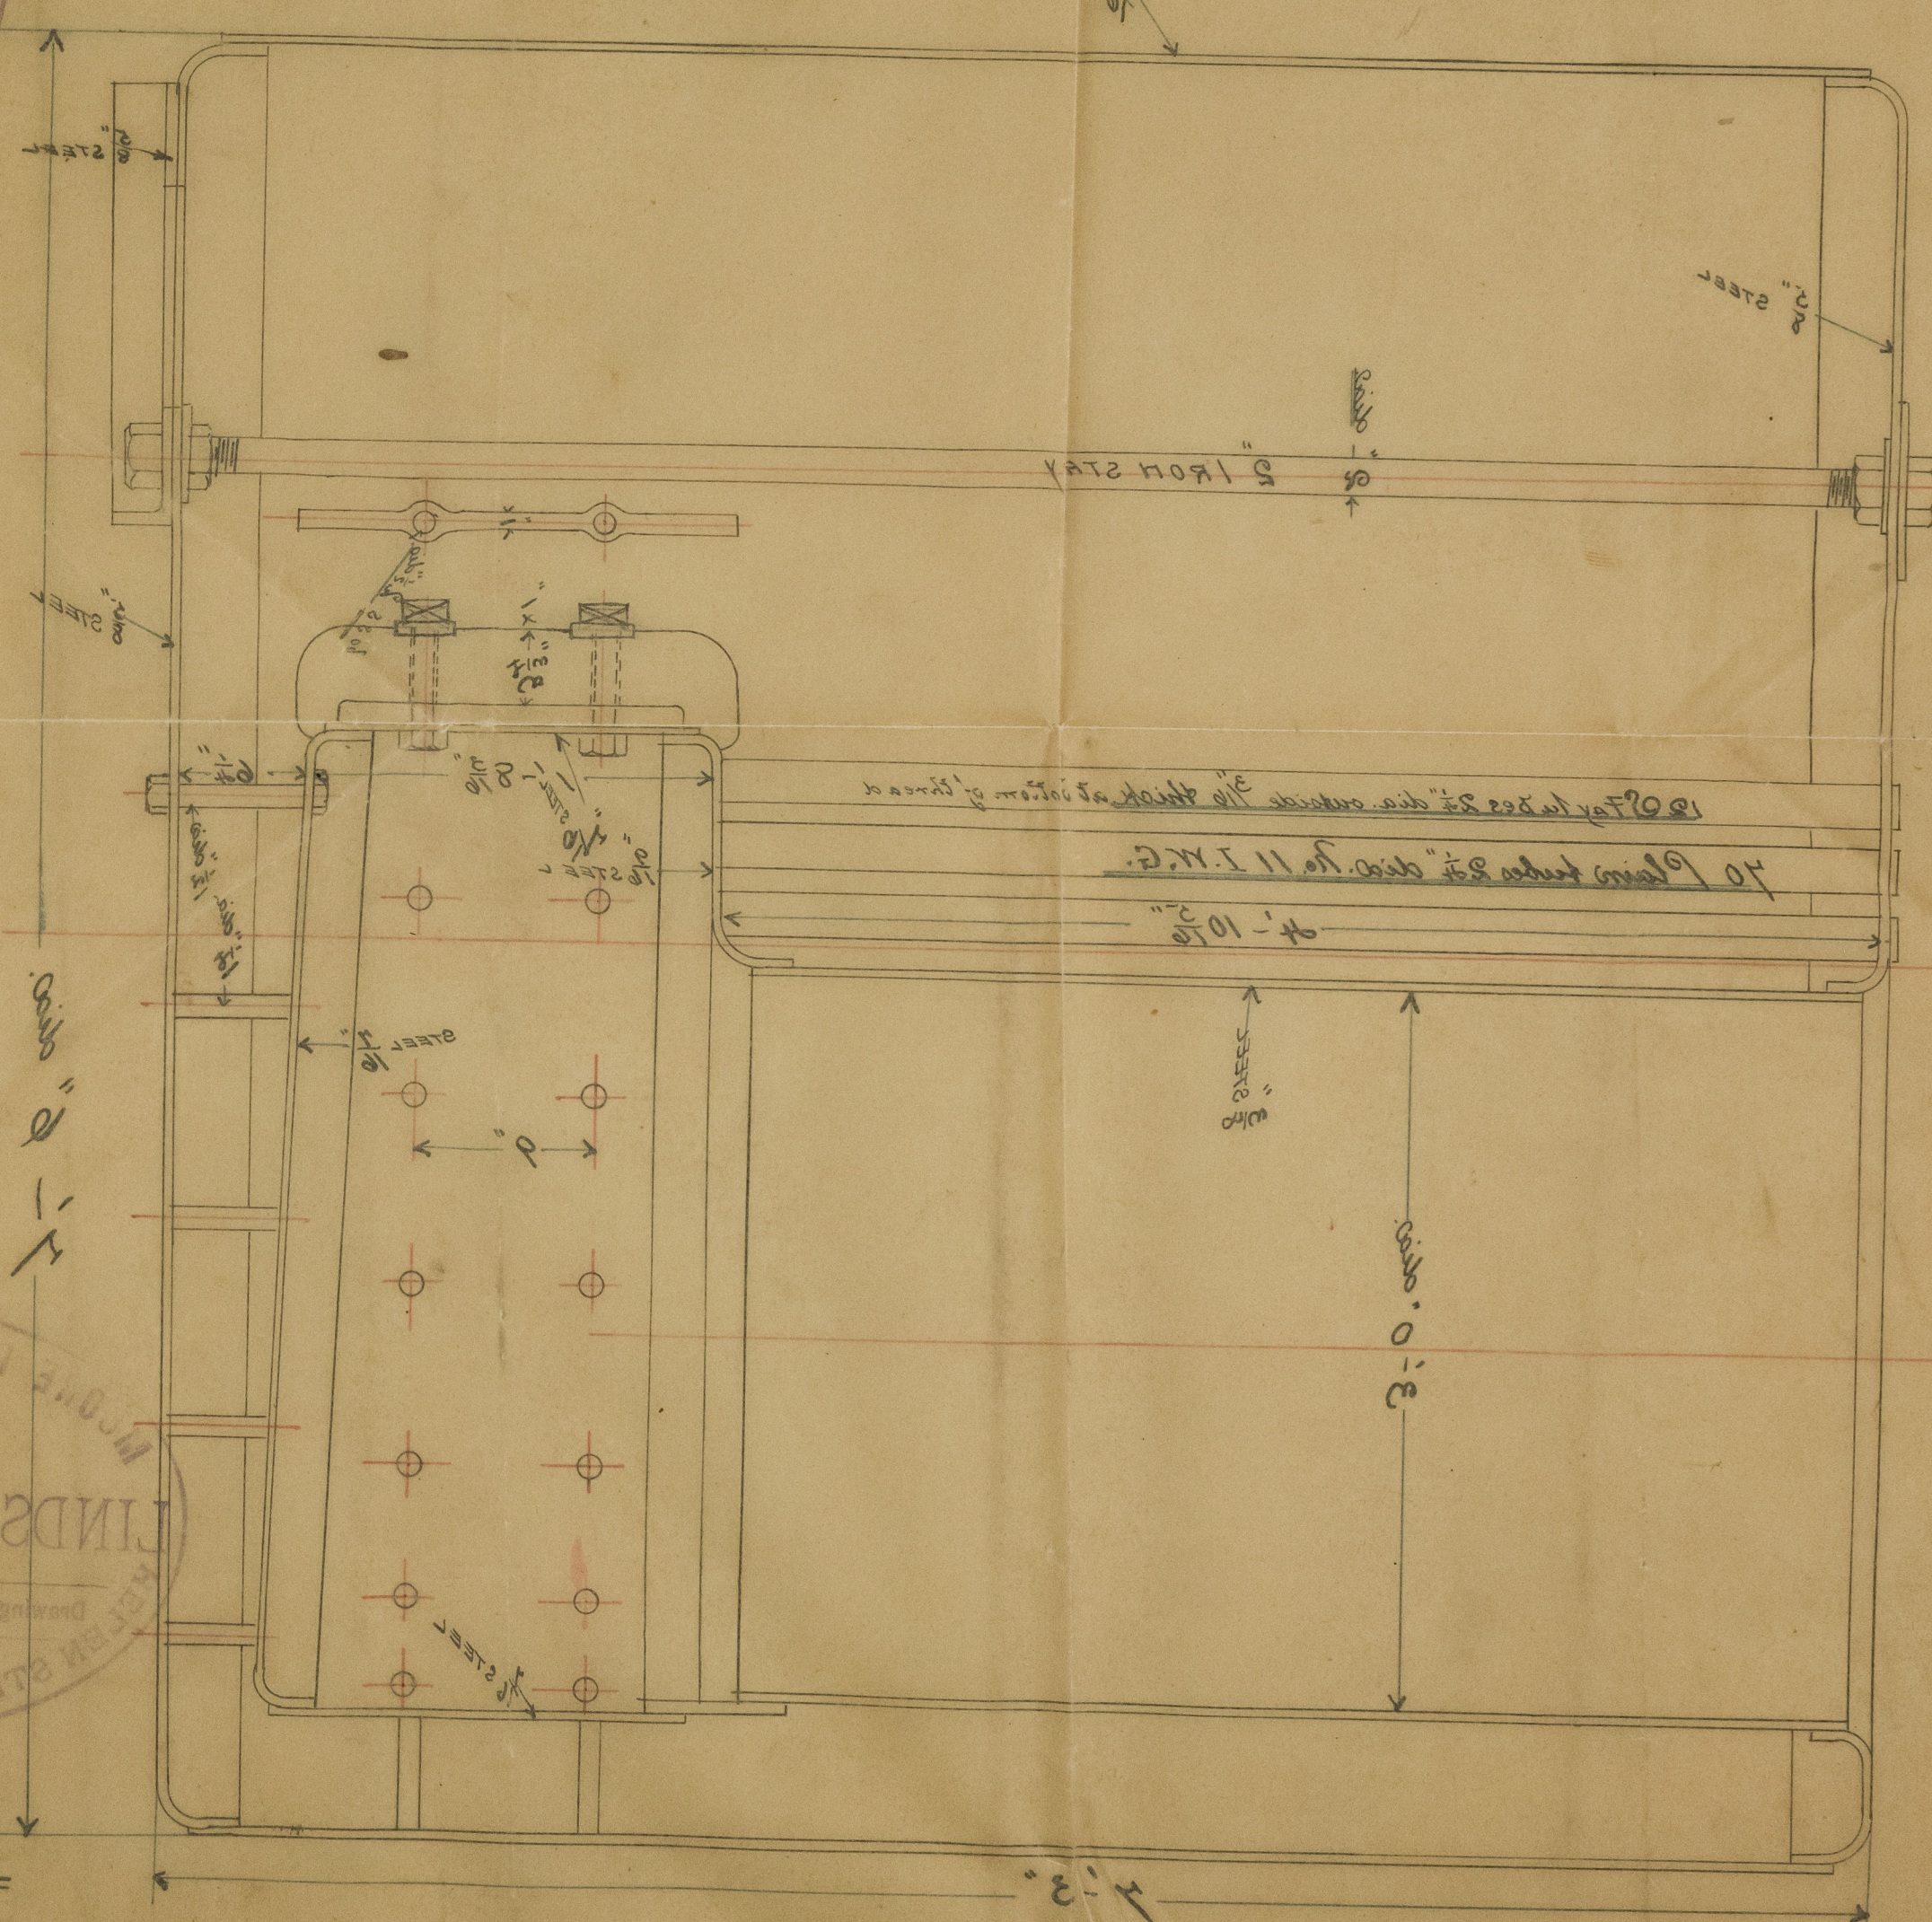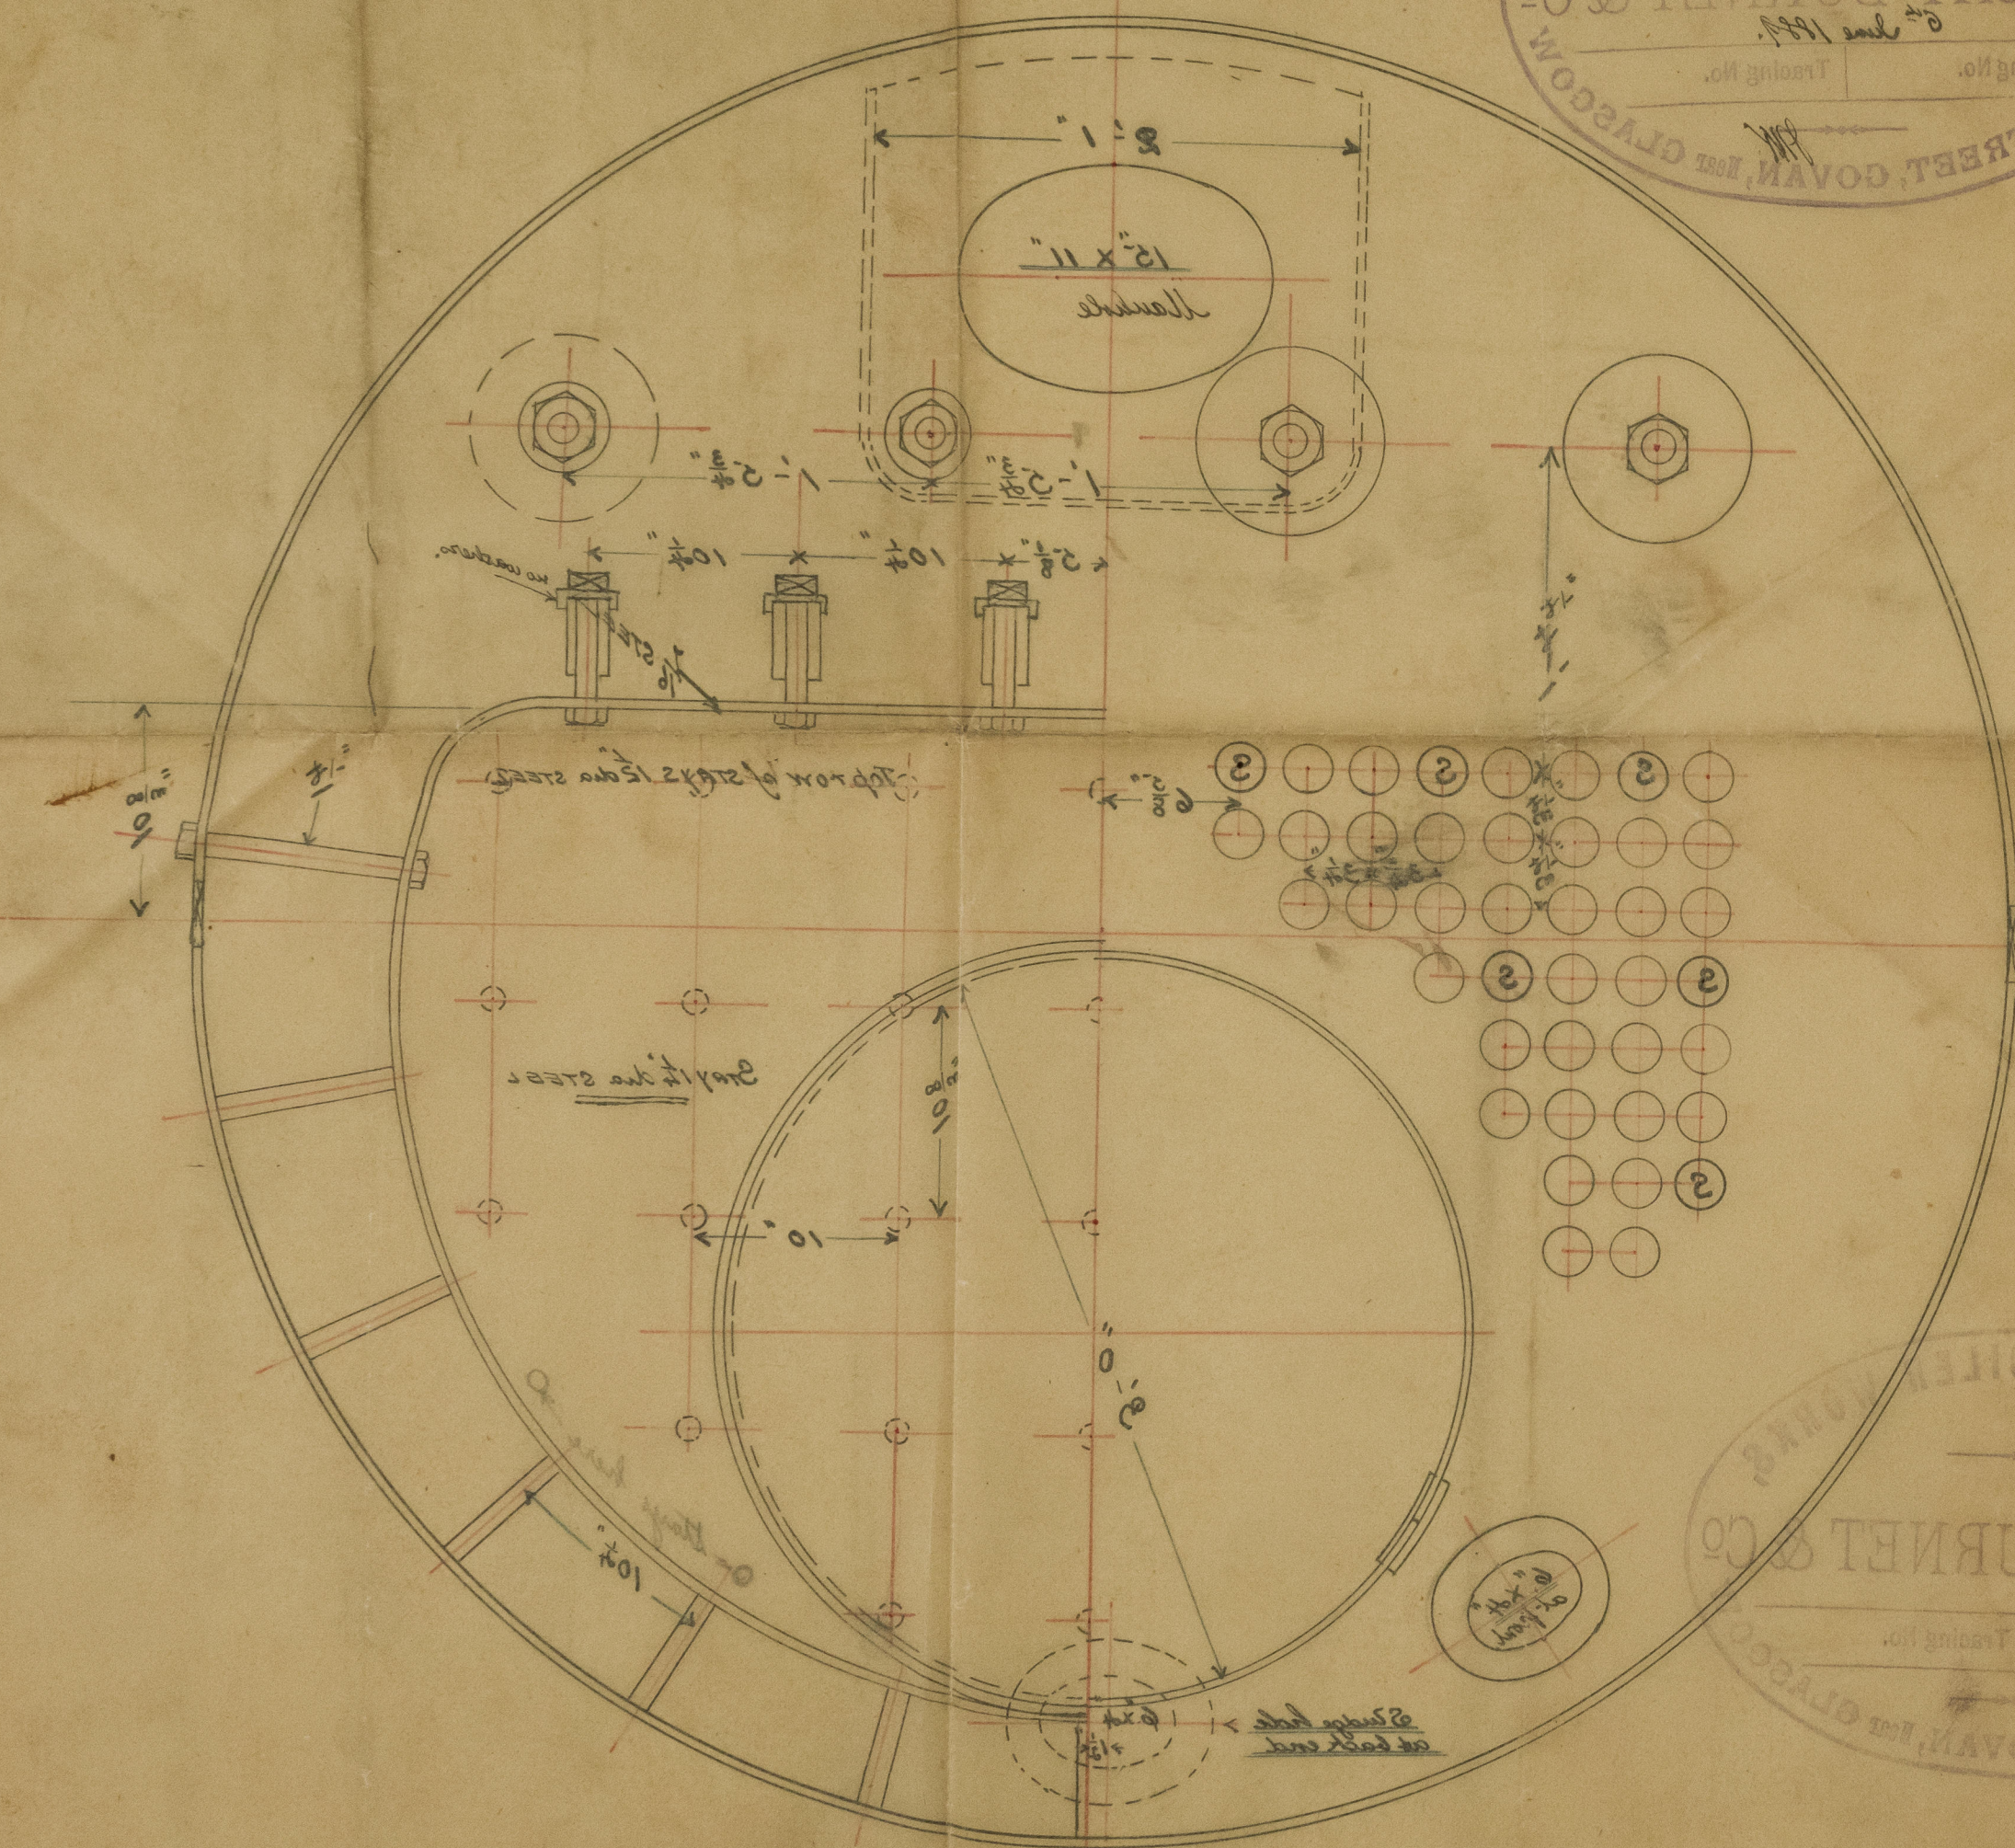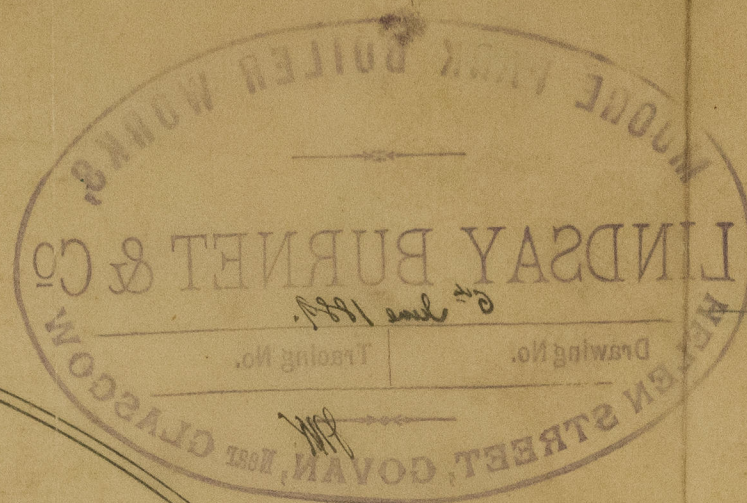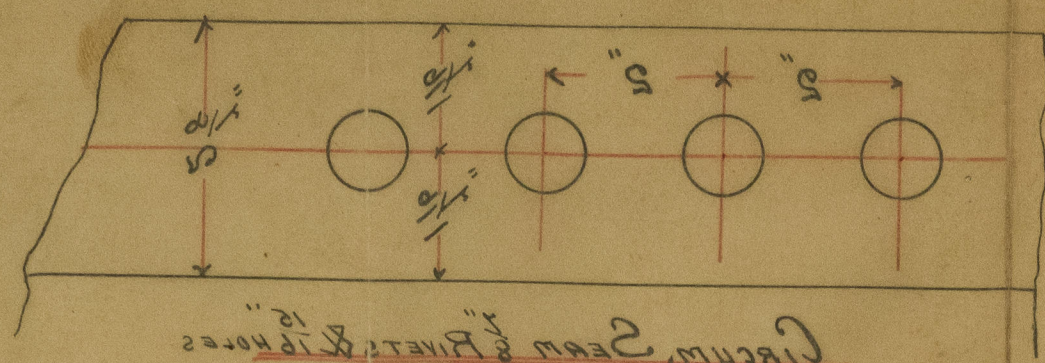

Marine Boiler 7'-6" x 3'-0" =
Working Pressure = 20 lbs.
Scale 1/2" = One Foot
Boiler No. 308 of 10
Under Lloyd's Survey



© 2021
Lloyd's Register
Foundation