

LONGITUDINAL SECTION & DECK PLAN OF TWIN SCREW STEAMER No 148



TO CLASS 100A STEEL AT LLOYDS

SCALE 1/2" = ONE FOOT

26 JUL 89

27/7/89


Handwritten notes and signatures on the right margin.

  

Handwritten signature and date at the bottom right.


645219-0066

0066

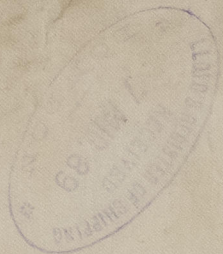

GLS219-0066

4
S. S. Duckenfield
Glasgow Report
No 9920

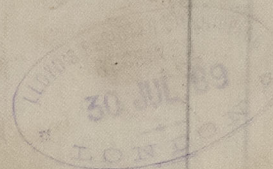

[Handwritten signature]
2/8/99



© 2021

Lloyd's Register
Foundation