

## Lloyd's Register of British and Foreign Shipping.

(Report on Vessel No. *9926*, Port *Glasgow*)*Glasgow*No. *1473a*

## SHIP FORGINGS OR CASTINGS.

*Duckenfield*

The words FORGINGS or CASTINGS, IRON or STEEL, should be struck out as may be required.

I have to report that the undermentioned Iron or ~~Steel~~ Forgings or Castings, manufactured by*the Weath Quay Forge Co.**of Sunderland*for the Vessel No. *148*, being built by *Messrs Fleming & Ferguson*of *Paisley*

have been inspected by me as set forth below, and found

to be, so far as can be seen, *sound*.

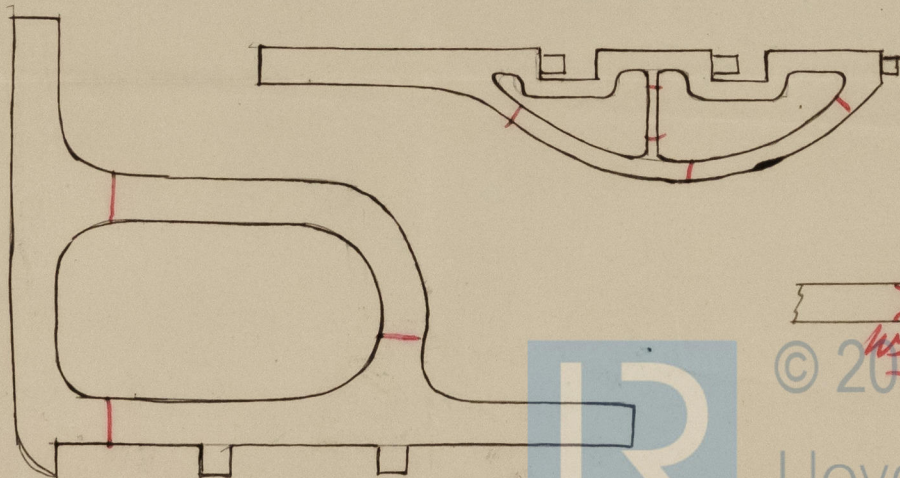
Mark on Forgings.

Lloyd's

No. *1473a**T.C.C.**Hugh Cameron**Sunderland**10.3.90*

	STERN FRAME.	RUDDER FRAME.	STEM.
Material* - - - -	<i>Scrap iron</i>	<i>Scrap iron</i>	<i>Scrap iron</i>
How made - - - -	<i>Forged</i>	<i>Forged</i>	<i>Forged</i>
Dimensions - - - -	<i>7' x 4 3/4"</i>	<i>5 1/4' - 3"</i>	<i>7' x 2 3/8"</i>
Progress on Inspection -	<i>Forged &amp; milled</i>	<i>Forged &amp; milled</i>	<i>Forged</i>
Dates when Inspected	<i>Oct 2.9-10-12-19/89</i>	<i>July 16-29 Aug 8-14-20-25/90</i>	<i>Oct 9/89</i>

SKETCHES OF FRAMES SHEWING POSITION AND DESCRIPTION OF WELDS OF FORGINGS, OR PARTICULARS OF TESTS APPLIED TO CASTINGS.

© 2021  
*Welds*Lloyd's Register  
Foundation