


THU 7 MAR 89  
FRI 15 APR 89  
SAT 18 MAY 89


Descriptive Longitudinal Section & Upper Deck Plan  
S.S. No 211

No Class 100 A Spar Deck, Steel

Scale 1/4 inch = 10 feet

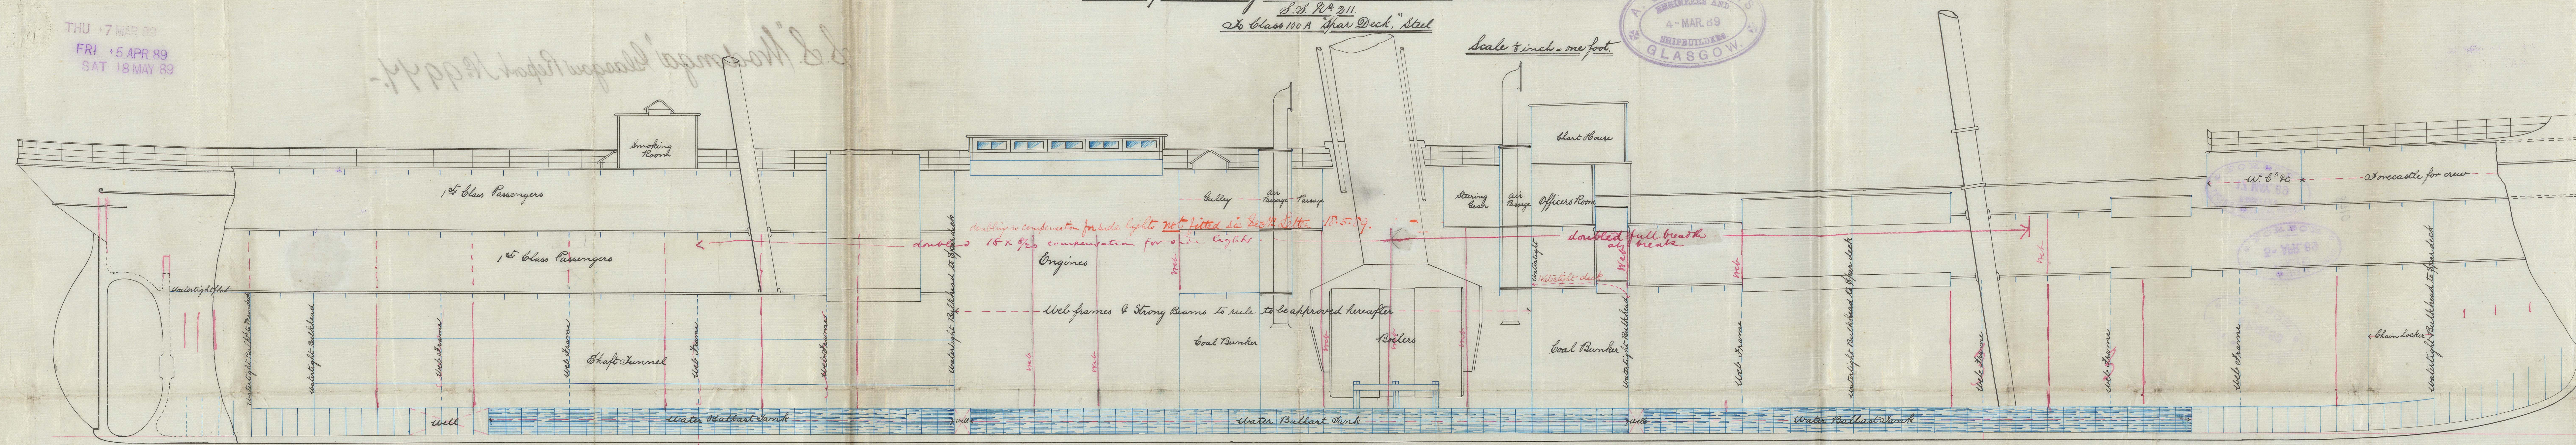

Reverse frames all up to Spar Deck amidships for 1/2 length, on every frame

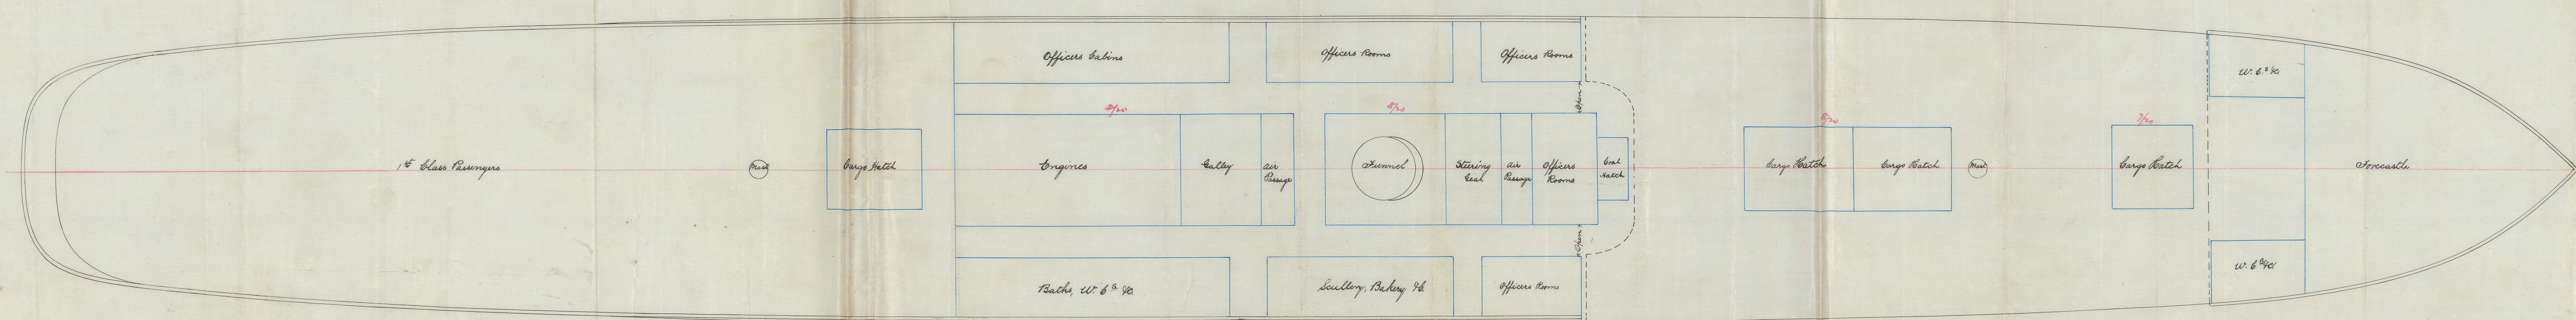


J.S.L.  
7/3/89



GLS219-0148

S.S. "Wodonga" Glasgow Report No. 9944.

THU 7 MAY 89  
FRI 8 APR 89  
SAT 18 MAY 89

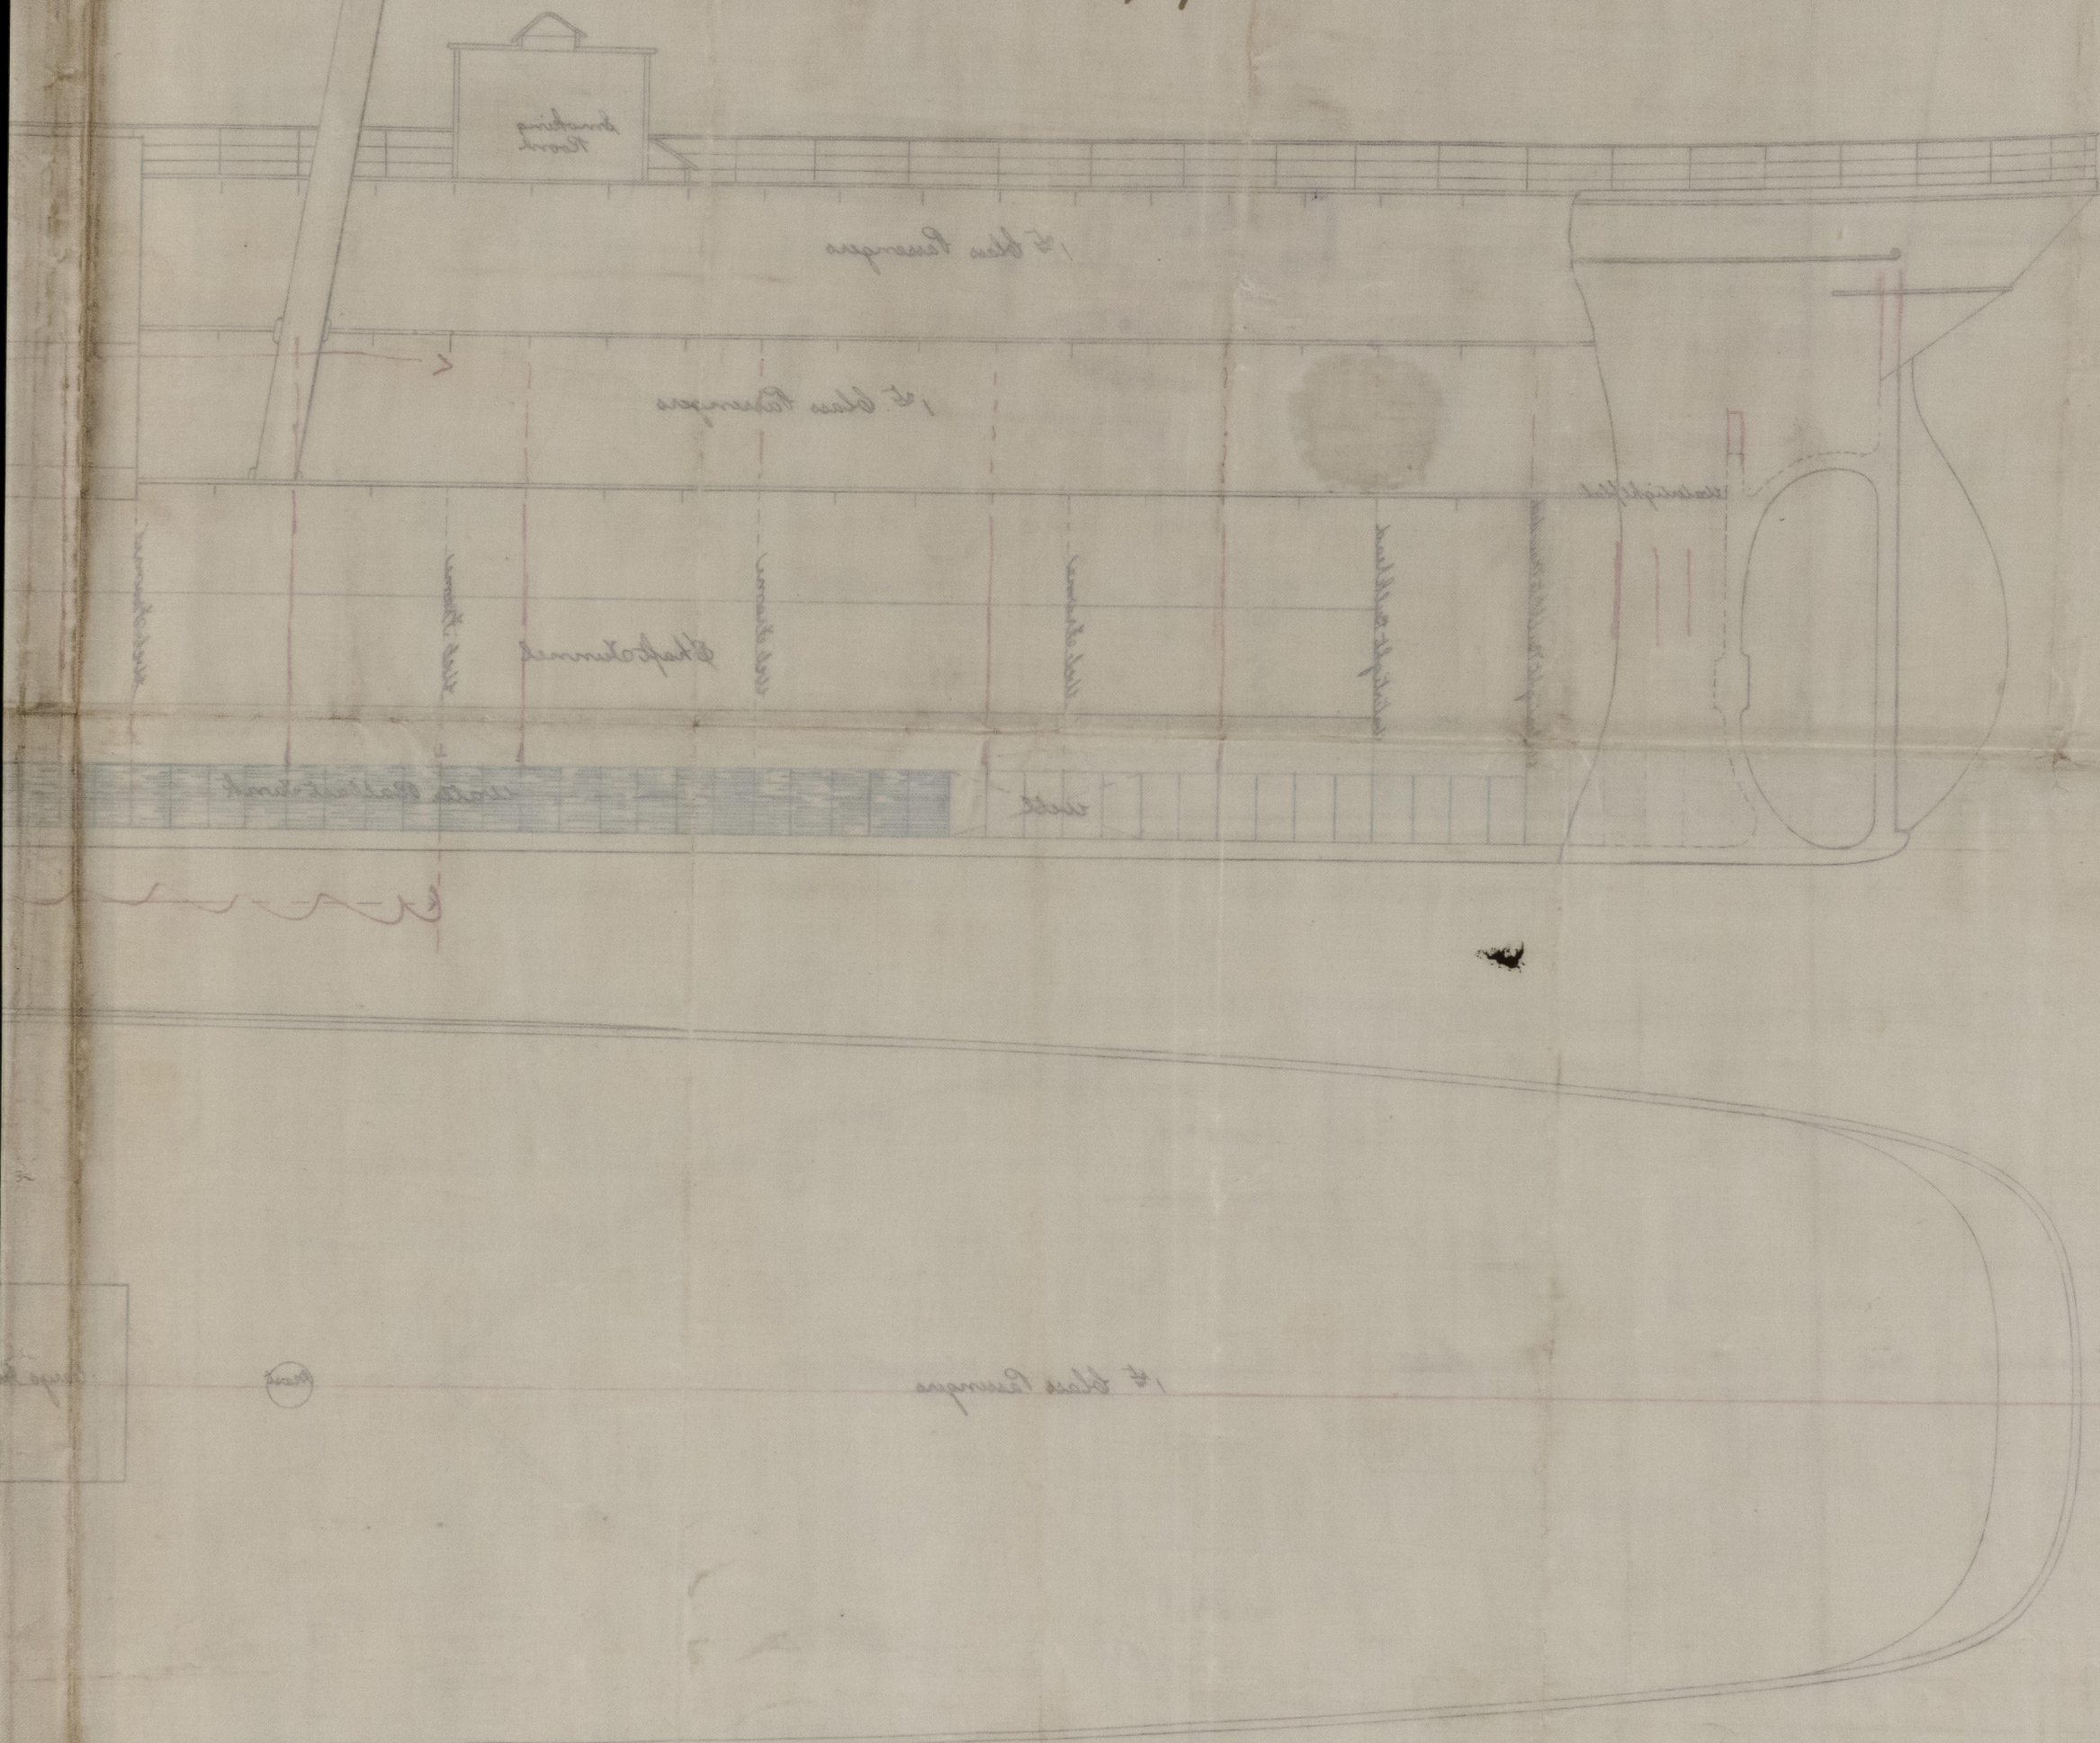

© 2021

Lloyd's Register  
Foundation



