



ELEVATION & DECK PLAN OF PADDLE TUG, N^o 149.

TO CLASS 100. A.1 AT LLOYDS.

SCALE 1/4" = ONE FOOT.

Amended 3/9/89
 V. J. J. J.
 11.1.89

MON 19 SEP 89

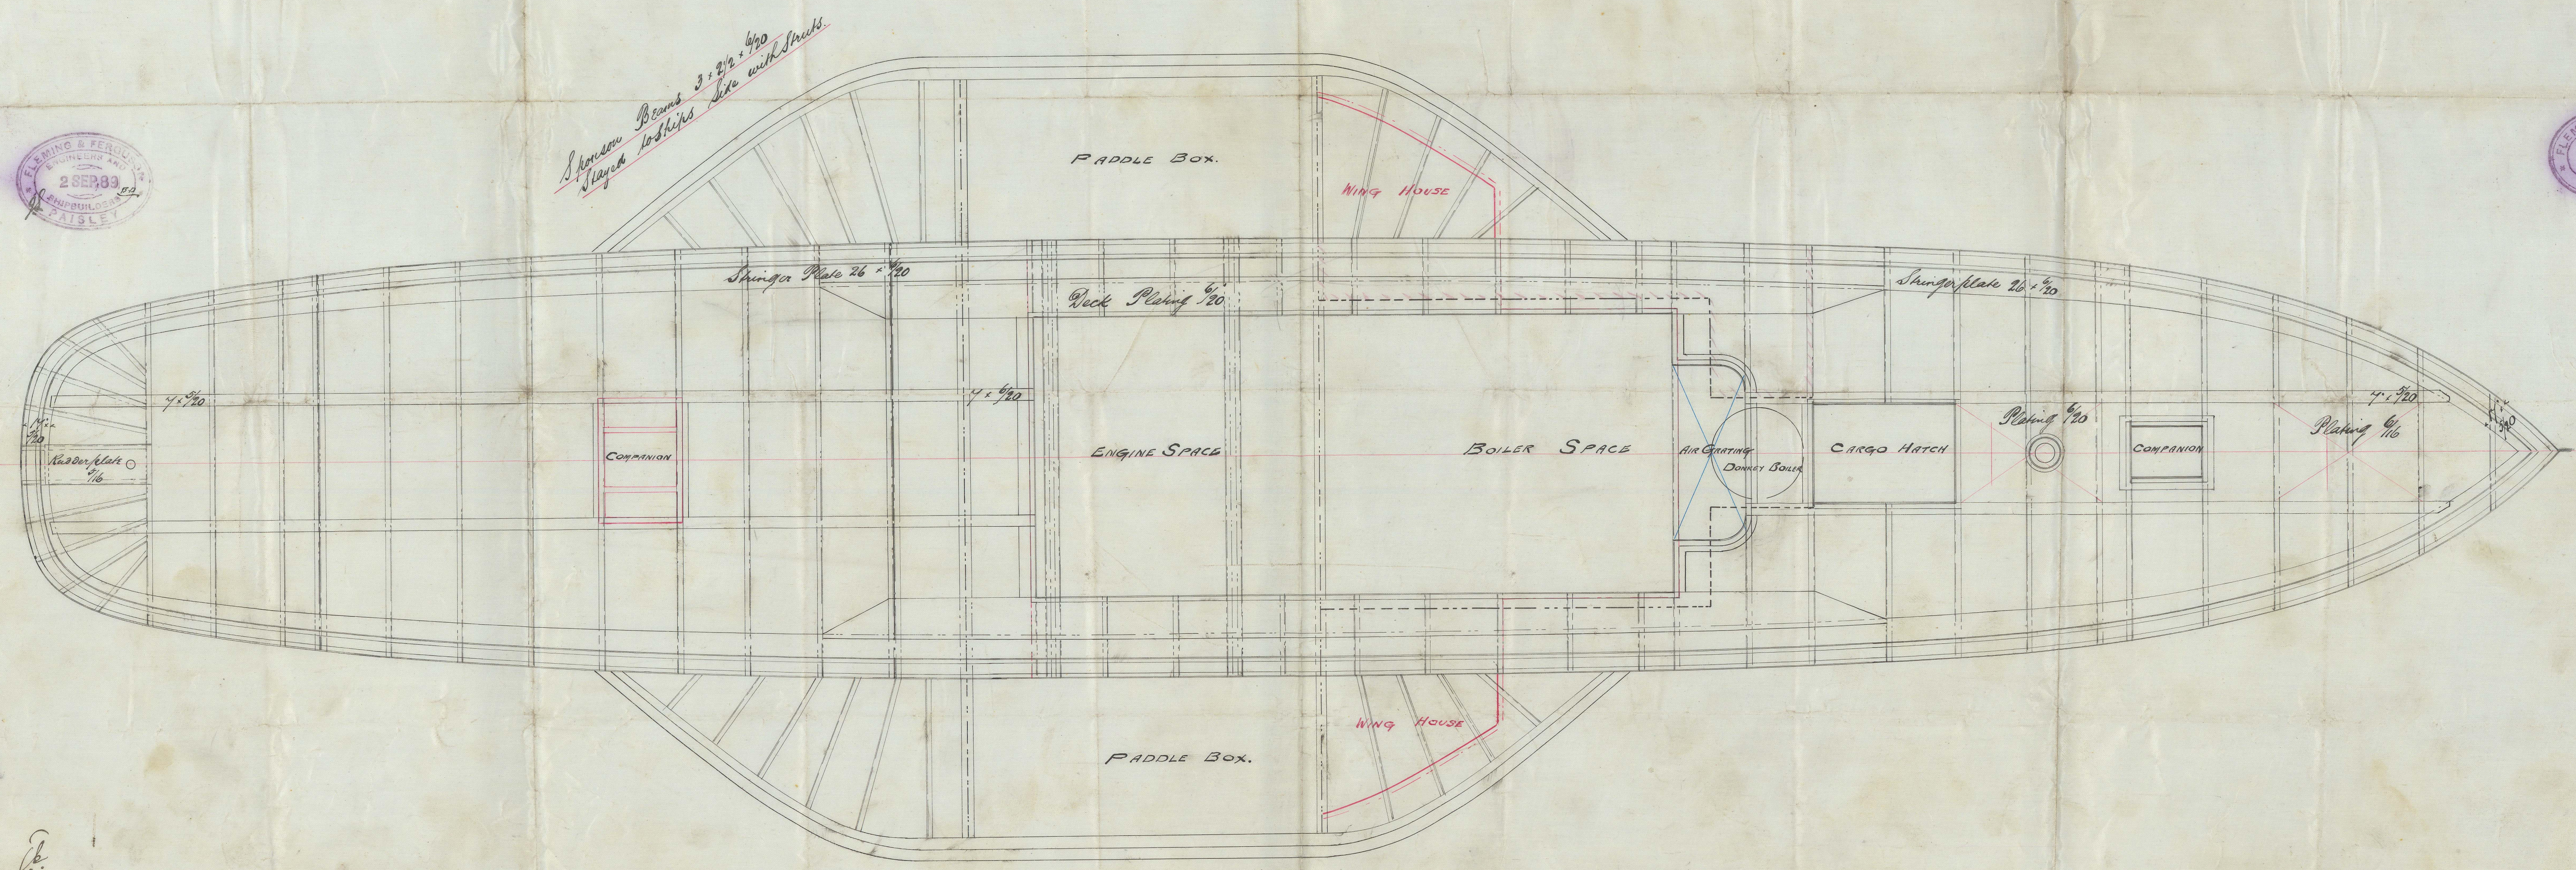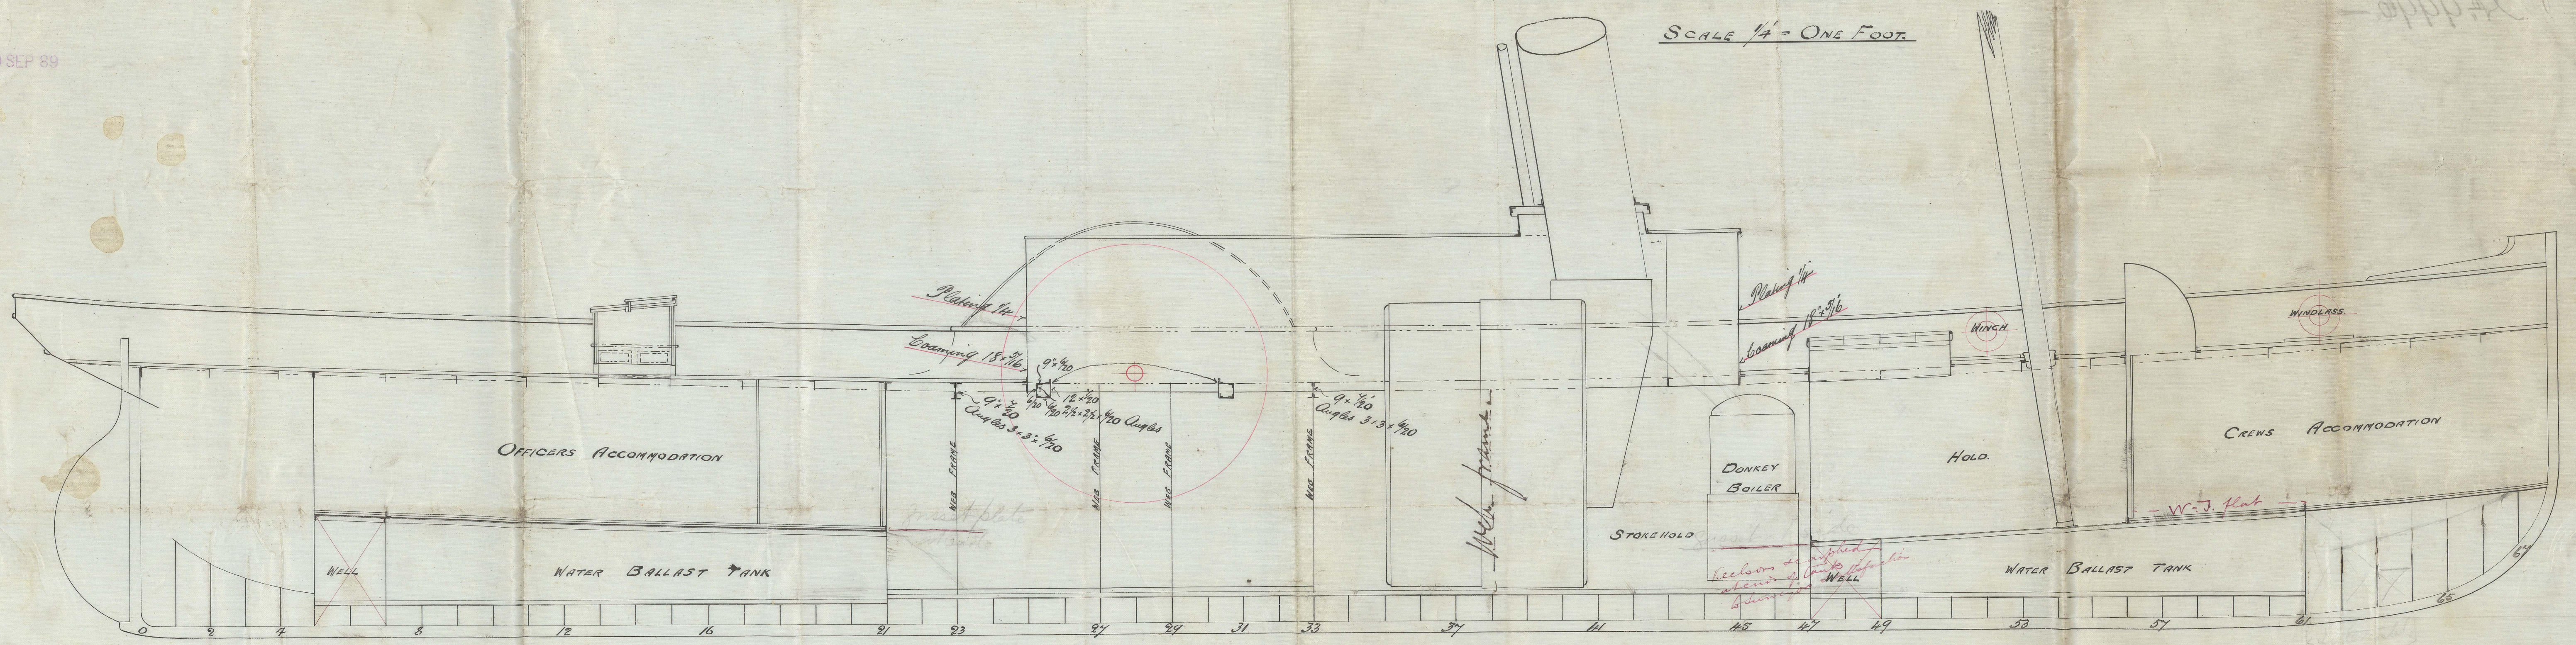

2 SEP 89
 PAISLEY



2 SEP 89
 PAISLEY

7/9/89

⁴
P. S. Manda
Glasgow Report
No. 9996. —

[Faint handwritten signature]

GLS219-0164

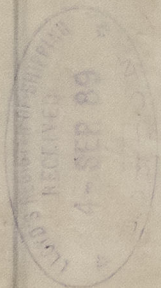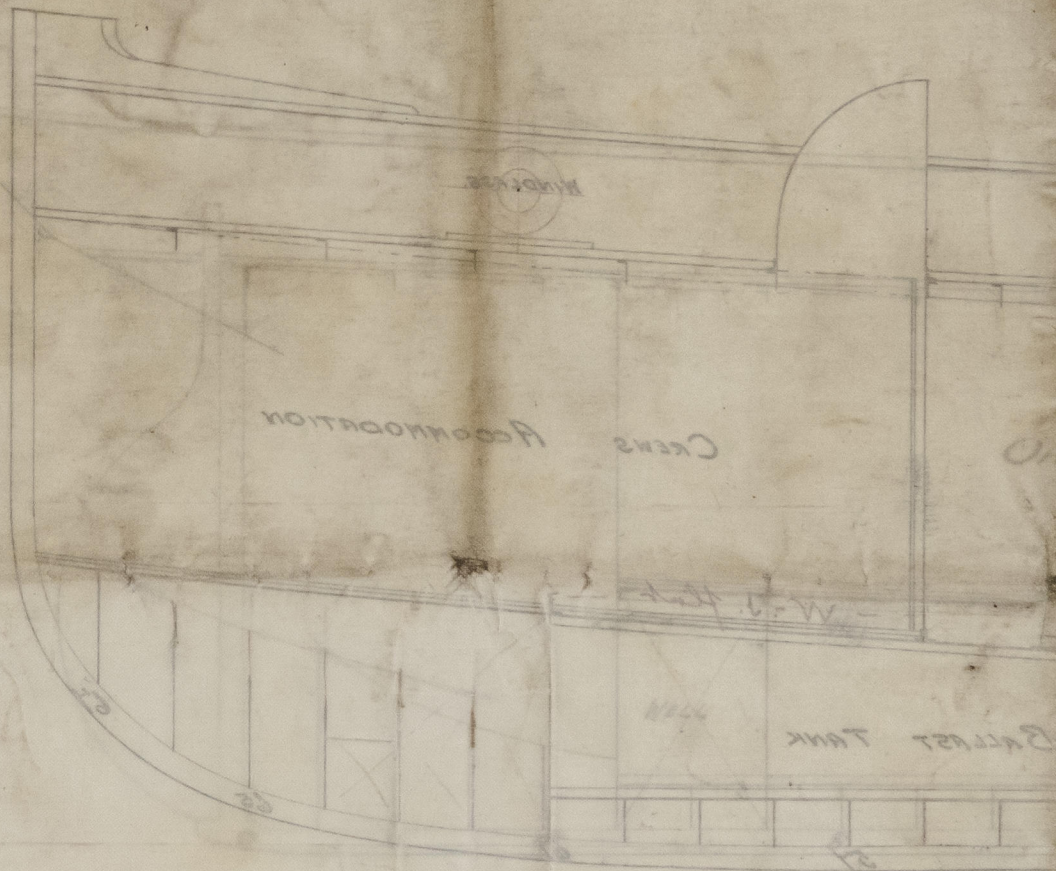

© 2021

Lloyd's Register
Foundation