

Lloyd's Register of British and Foreign Shipping.

(Report on Vessel No. 9996 Port Glasgow)Glasgow
No. 1489 a.

SHIP FORGINGS OR CASTINGS.

I have to report that the undermentioned Iron or Steel Forgings or Castings, manufactured by

Messrs R L Bagnall Sons of Wylton
for the Vessel No. 149, being built by Messrs Fleming & Ferguson
of Paisley have been inspected by me as set forth below, and found
to be, so far as can be seen, sound.

Mark on Forgings.


Lloyd's

No. 1489 a
R. L. B.

W. J. Bagnall
Amidland

	STERN FRAME. <i>Post</i>	RUDDER FRAME.	STEM.
Material* - - - -	<i>Scrap iron</i>	<i>Scrap iron</i>	<i>Scrap iron</i>
How made - - - -	<i>Forged</i>	<i>Forged</i>	<i>Forged</i>
Dimensions - - - -	<i>6" x 1 3/8"</i>	<i>3 3/4" - 2 1/4"</i>	<i>6" x 1 3/8"</i>
Progress on Inspection -	<i>Smithed</i>	<i>Forged Smithed</i>	<i>Forged</i>
Dates when Inspected {	<i>Oct 14-19/89</i>	<i>Jan 9-16-20-29/90</i>	<i>Oct 14/89</i>

SKETCHES OF FRAMES SHEWING POSITION AND DESCRIPTION OF WELDS OF FORGINGS, OR PARTICULARS OF TESTS
APPLIED TO CASTINGS.

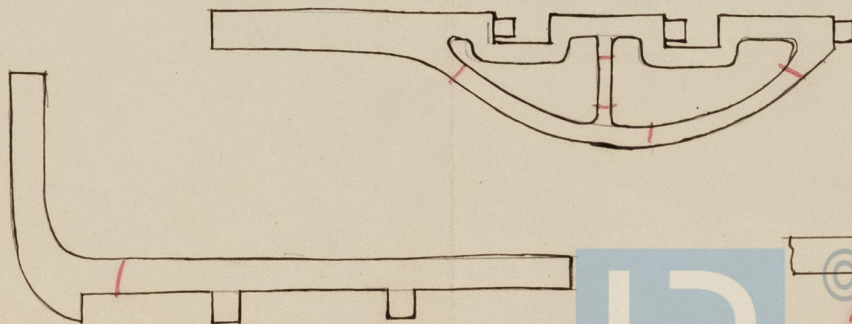

© 2021
W. J. Bagnall

Lloyd's Register
Foundation

* If of Iron, state whether scrap or puddled Iron.