


8300
 THU 15 AUG 89
 WED 21 AUG 89
 FRI 18 OCT 89
 TUE 28 JAN 90

2638
 R.A.M.
 THE FAIRFIELD SHIPBUILDING CO. LTD.
 GLASGOW

 

Note.
 Old frames or partial bulkheads fitted between lower & upper decks about every tenth frame to suit cabin arrangement.

all reversed frames to extend to forward in way of the poop.

Old frames to be left as required by the Rules

Turner Decks all for aft exclusively for accommodation of Passengers

12" Hatch beams as per Rule

12" Hatch beams as per Rule

Belongs to 7th deck

Profile
 No 348, S.S. 420' 0" x 44' 9" x 36' 0" modelled.
 Scale 1" = 10'.

THE FAIRFIELD SHIPBUILDING & ENGINEERING CO. LTD.
 7 AUG 89
 GLASGOW



S.S. Dunottar Castle "Glasgow Report 10094"

GLS 220-0068

Measure of thickness of plate of the steel work




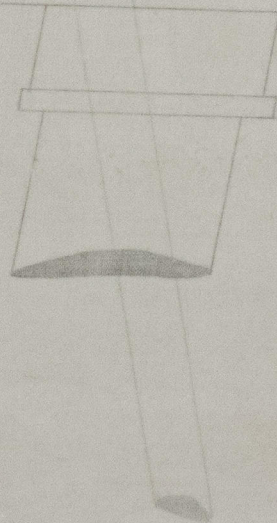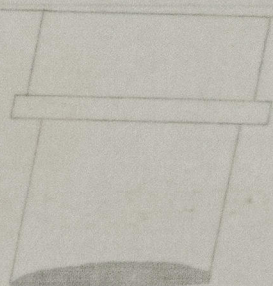

© 2021


Lloyd's Register
Foundation

0068

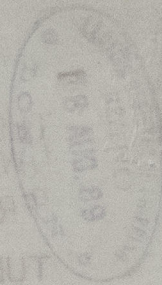

TUE 28 JAN 90
00 MAR 89
08 OCT 89
08 JUL 89
08 JUN 89
08 MAY 89

My 1st mail

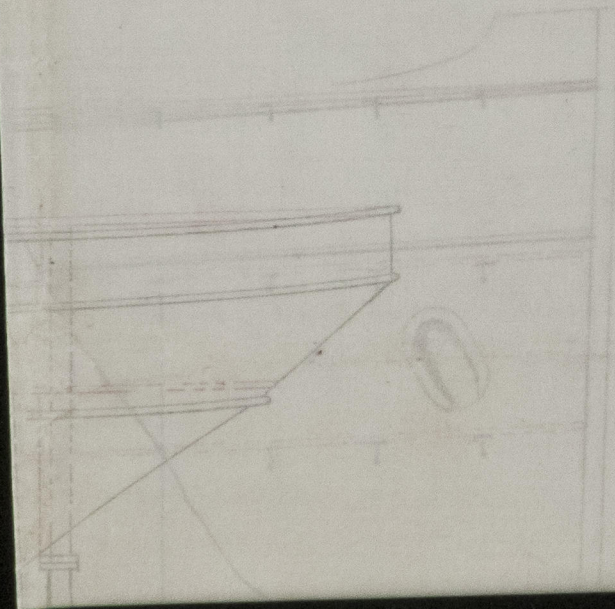

© 2021

Lloyd's Register
Foundation