



Tube surfaces $3834 \times 4 = 15336$ sq ft
 Annular firebox surfaces $620 \times 4 = \frac{2480}{}$ " "
 Total surface $4454 \times 4 = 17816$ sq ft

MA.
17-8-89

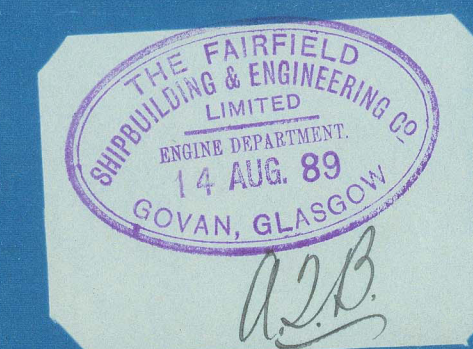

BOILERS No 348
— SCALE 1" = 1 FOOT —
WORKING PRESSURE 160 LBS

Boilers
S. S. "Dunottar Castle"
Glasgow Report
No 10094.—
Fairfield S/B Co

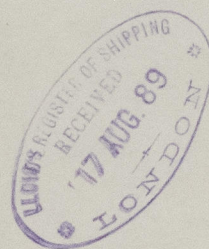

0074.

GLS220-0074



© 2021

Lloyd's Register
Foundation