

18 OCT 89


Profile

S.S. No. 348

420.0' x 49.9' x 26.0' mld.

Scale 1/4" = 100'



Note: Reverse Bars carried to Upper Deck all fore and aft.

 

SECTION THRO' ENGINE ROOM.

SCALE 1/4" INCH = ONE FOOT

SECTION THRO' BOILER ROOM.

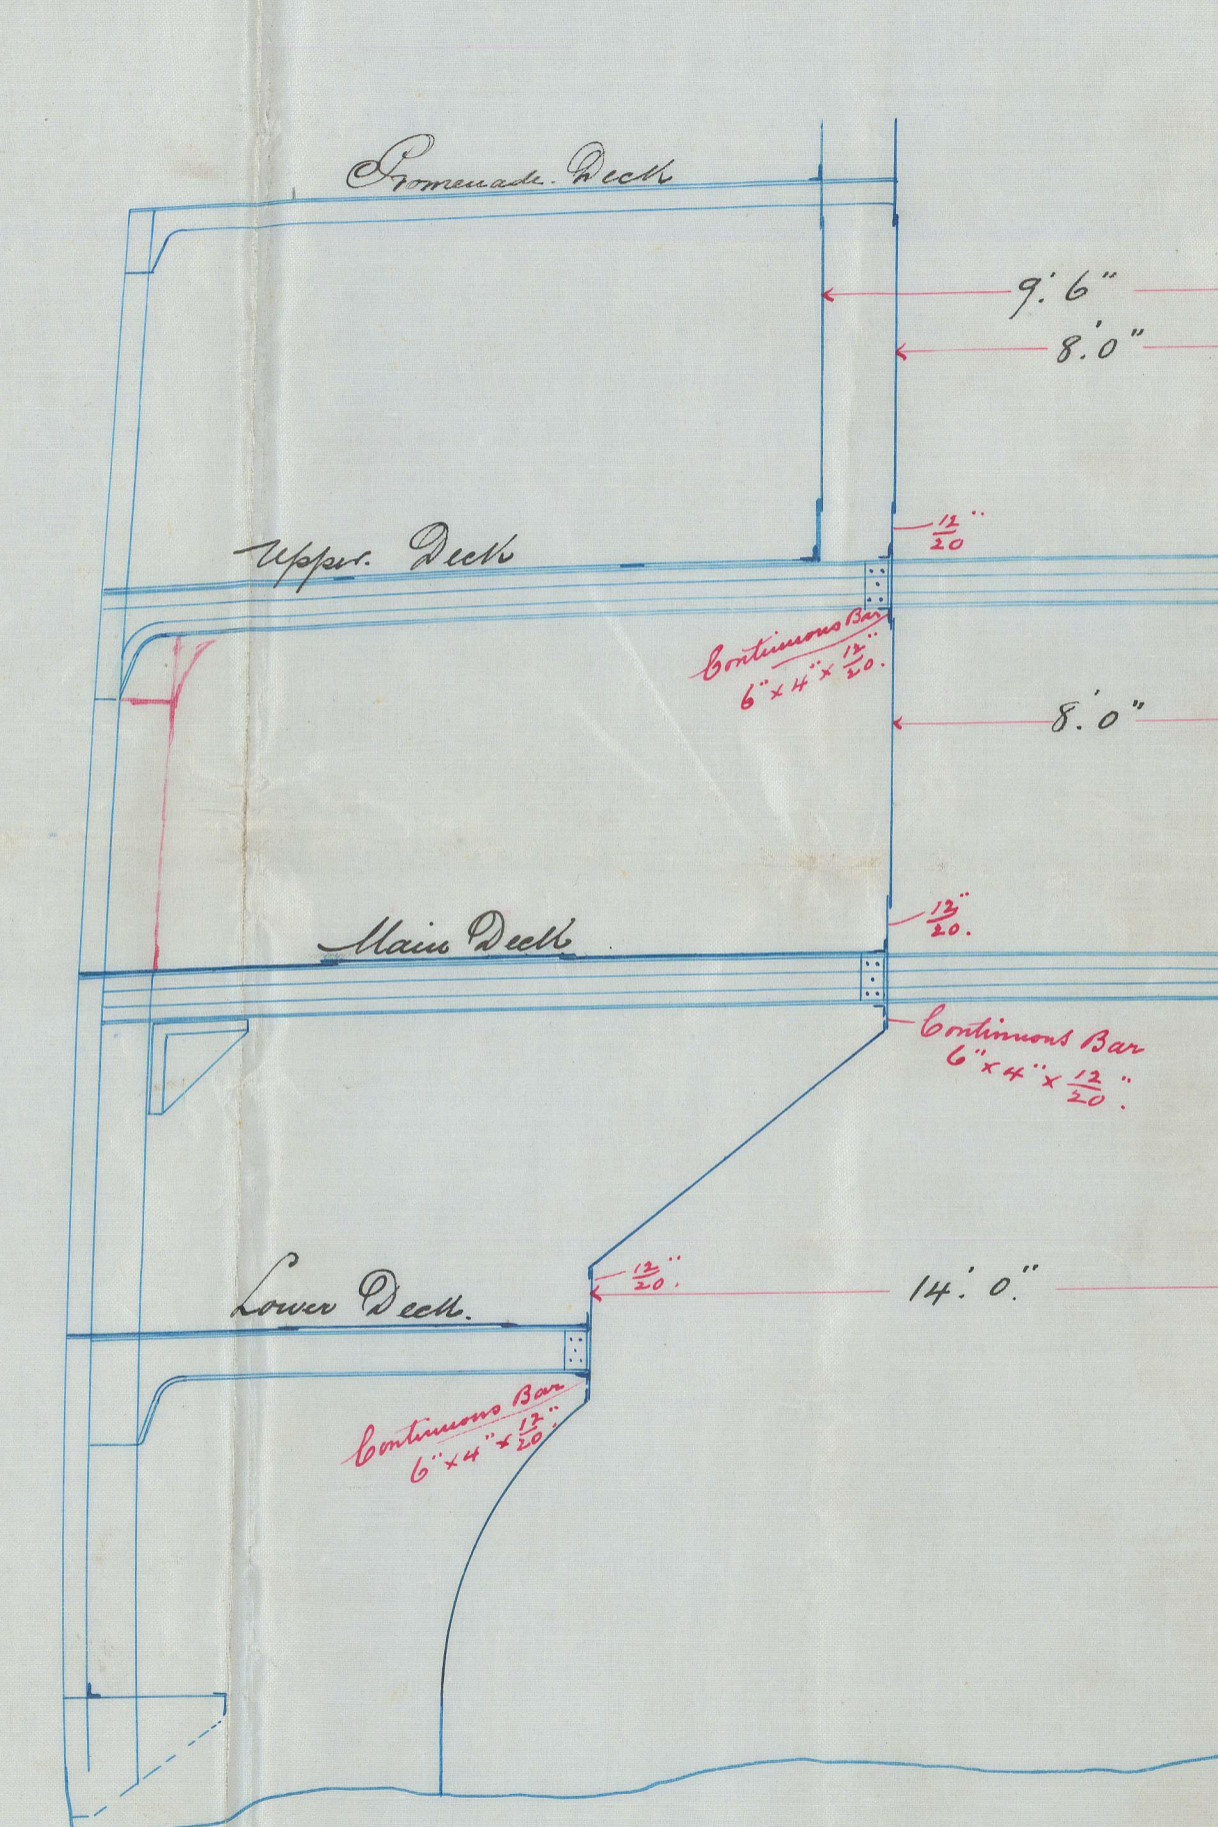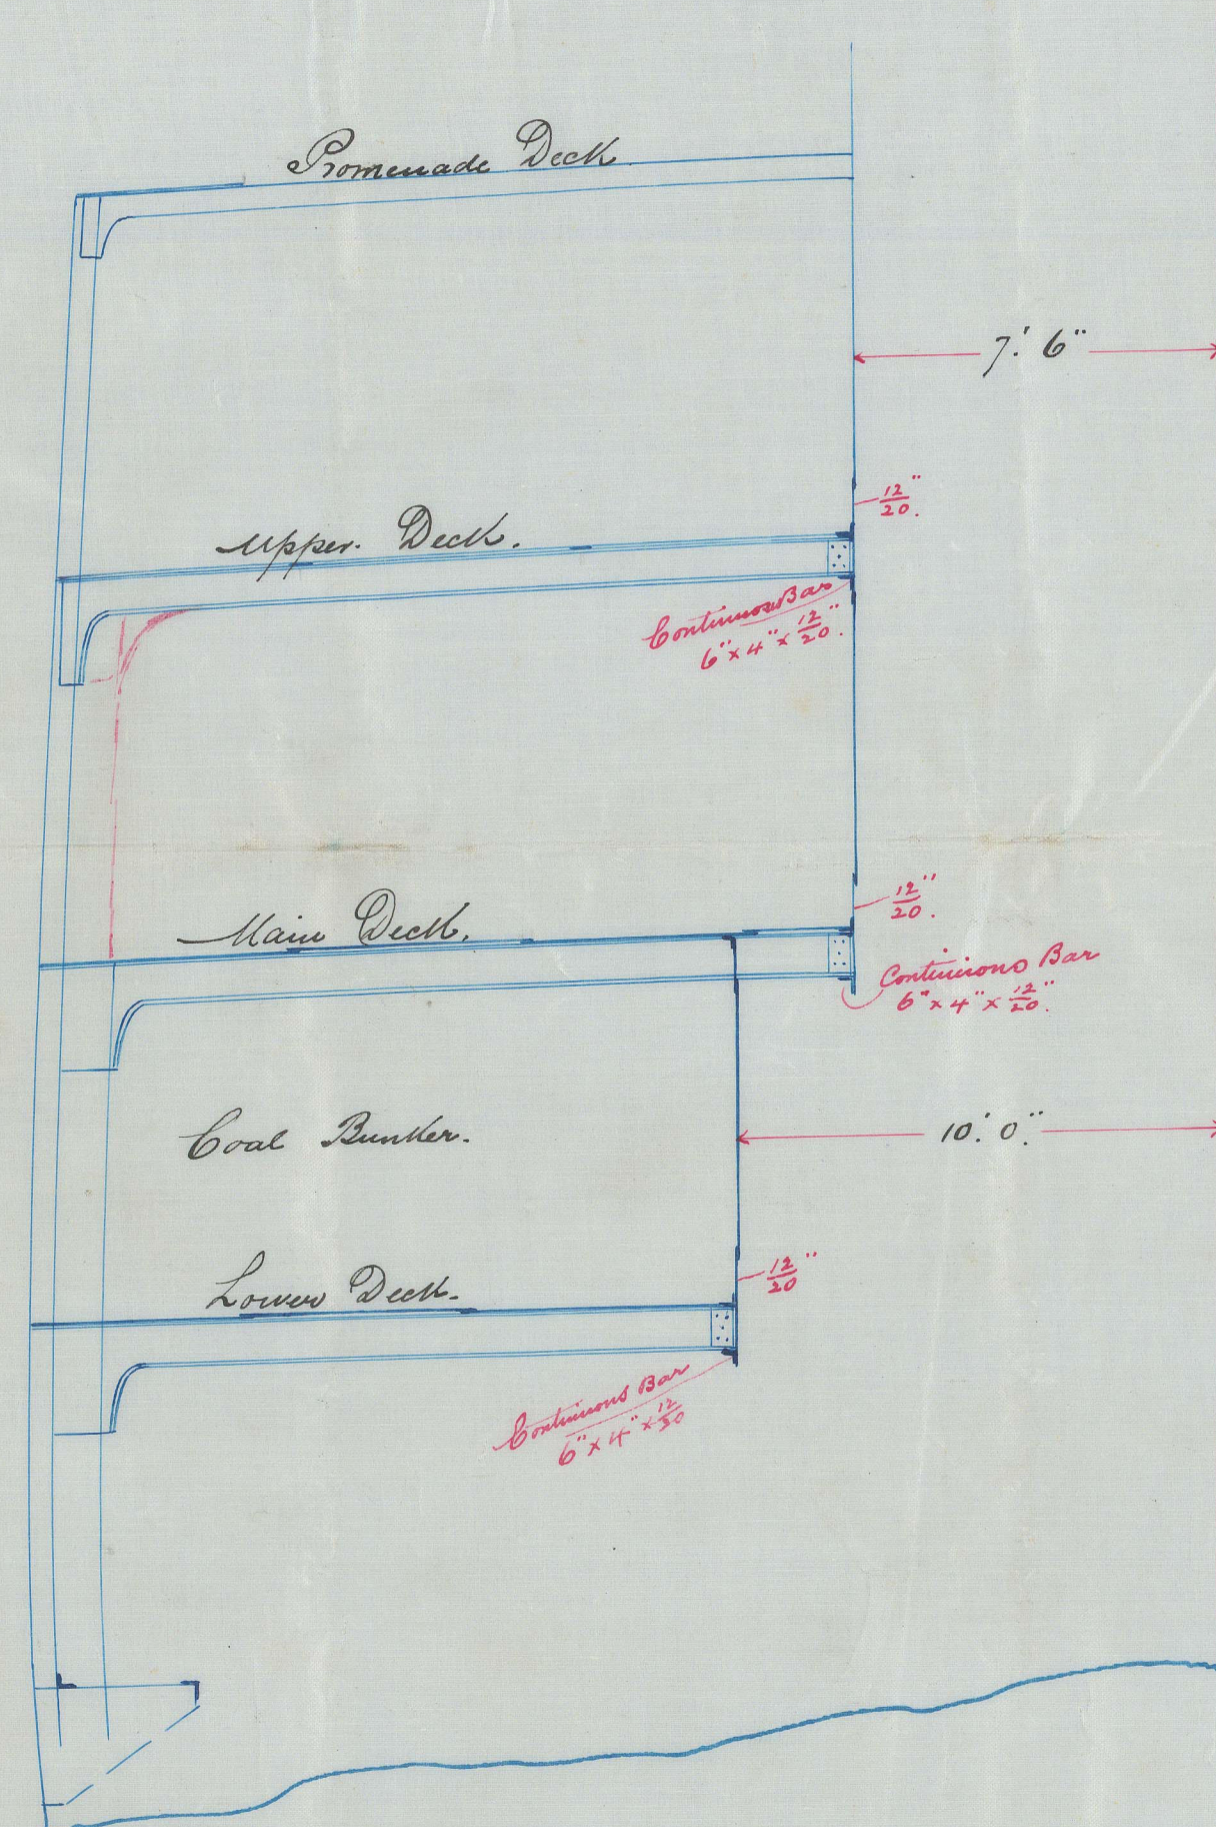


17/10/89

# S.S. "Dunotter Castle"

## Glasgow Report

### 10094.-

GLS220-0075

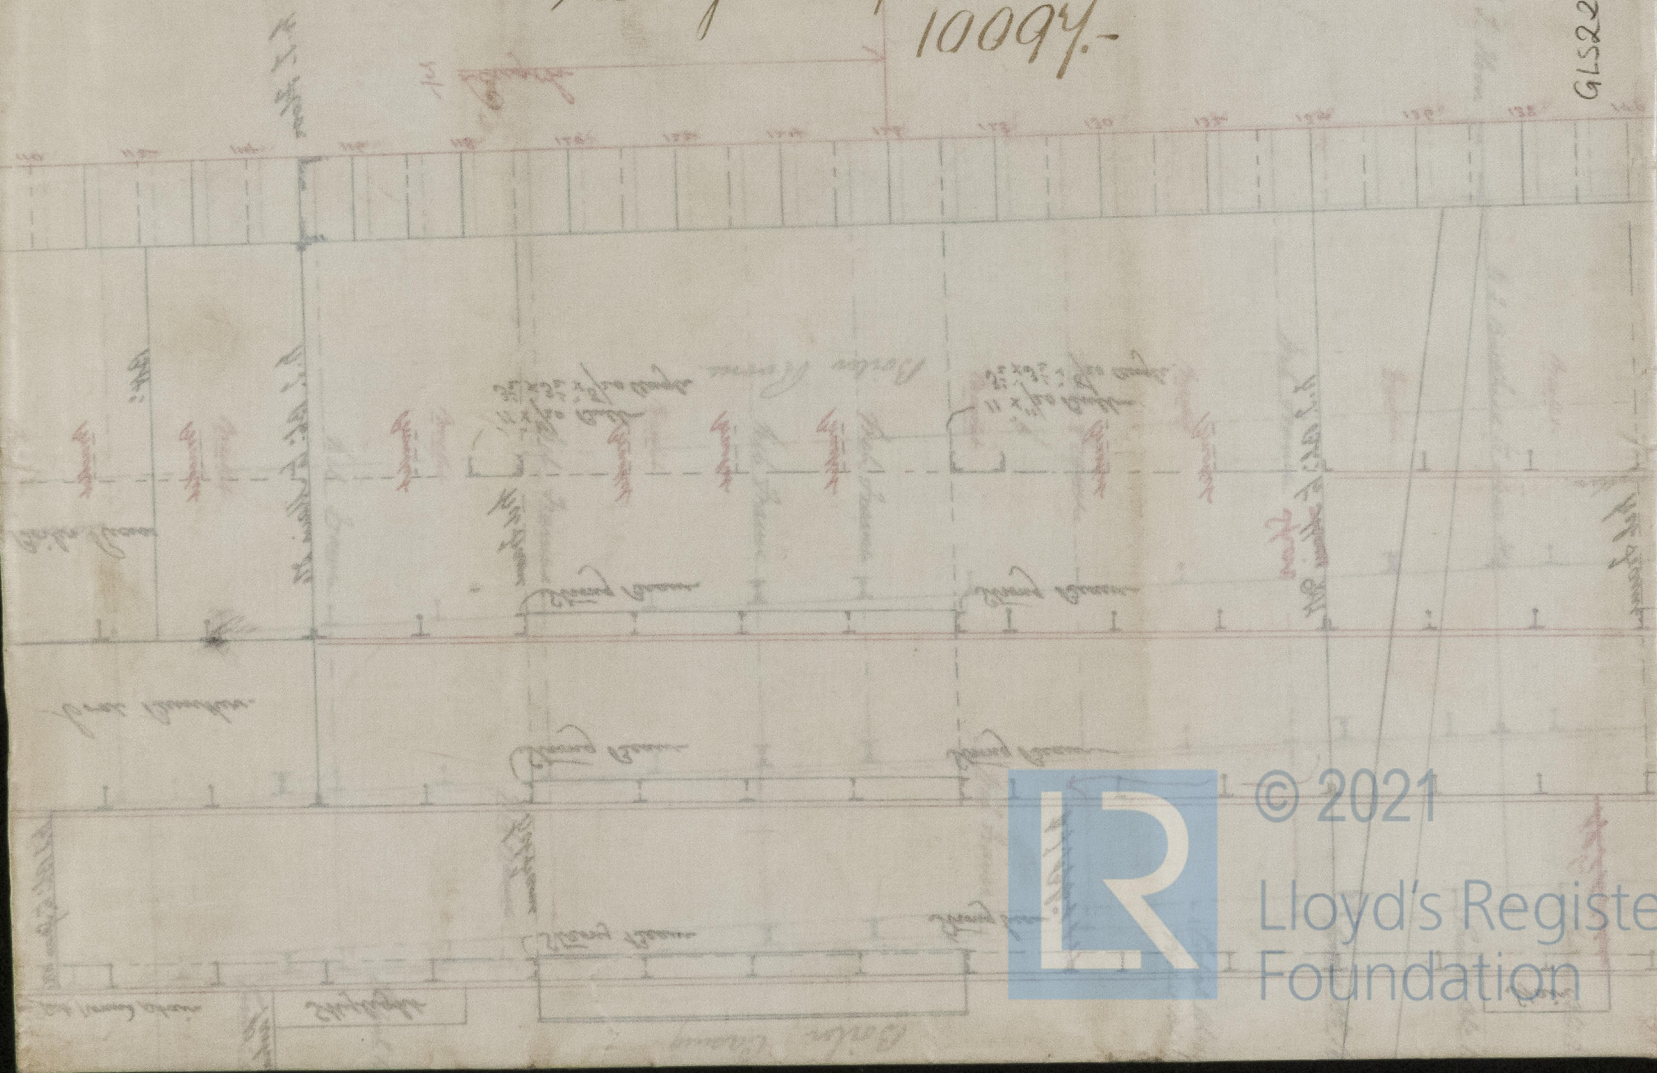

© 2021

Lloyd's Register  
Foundation