
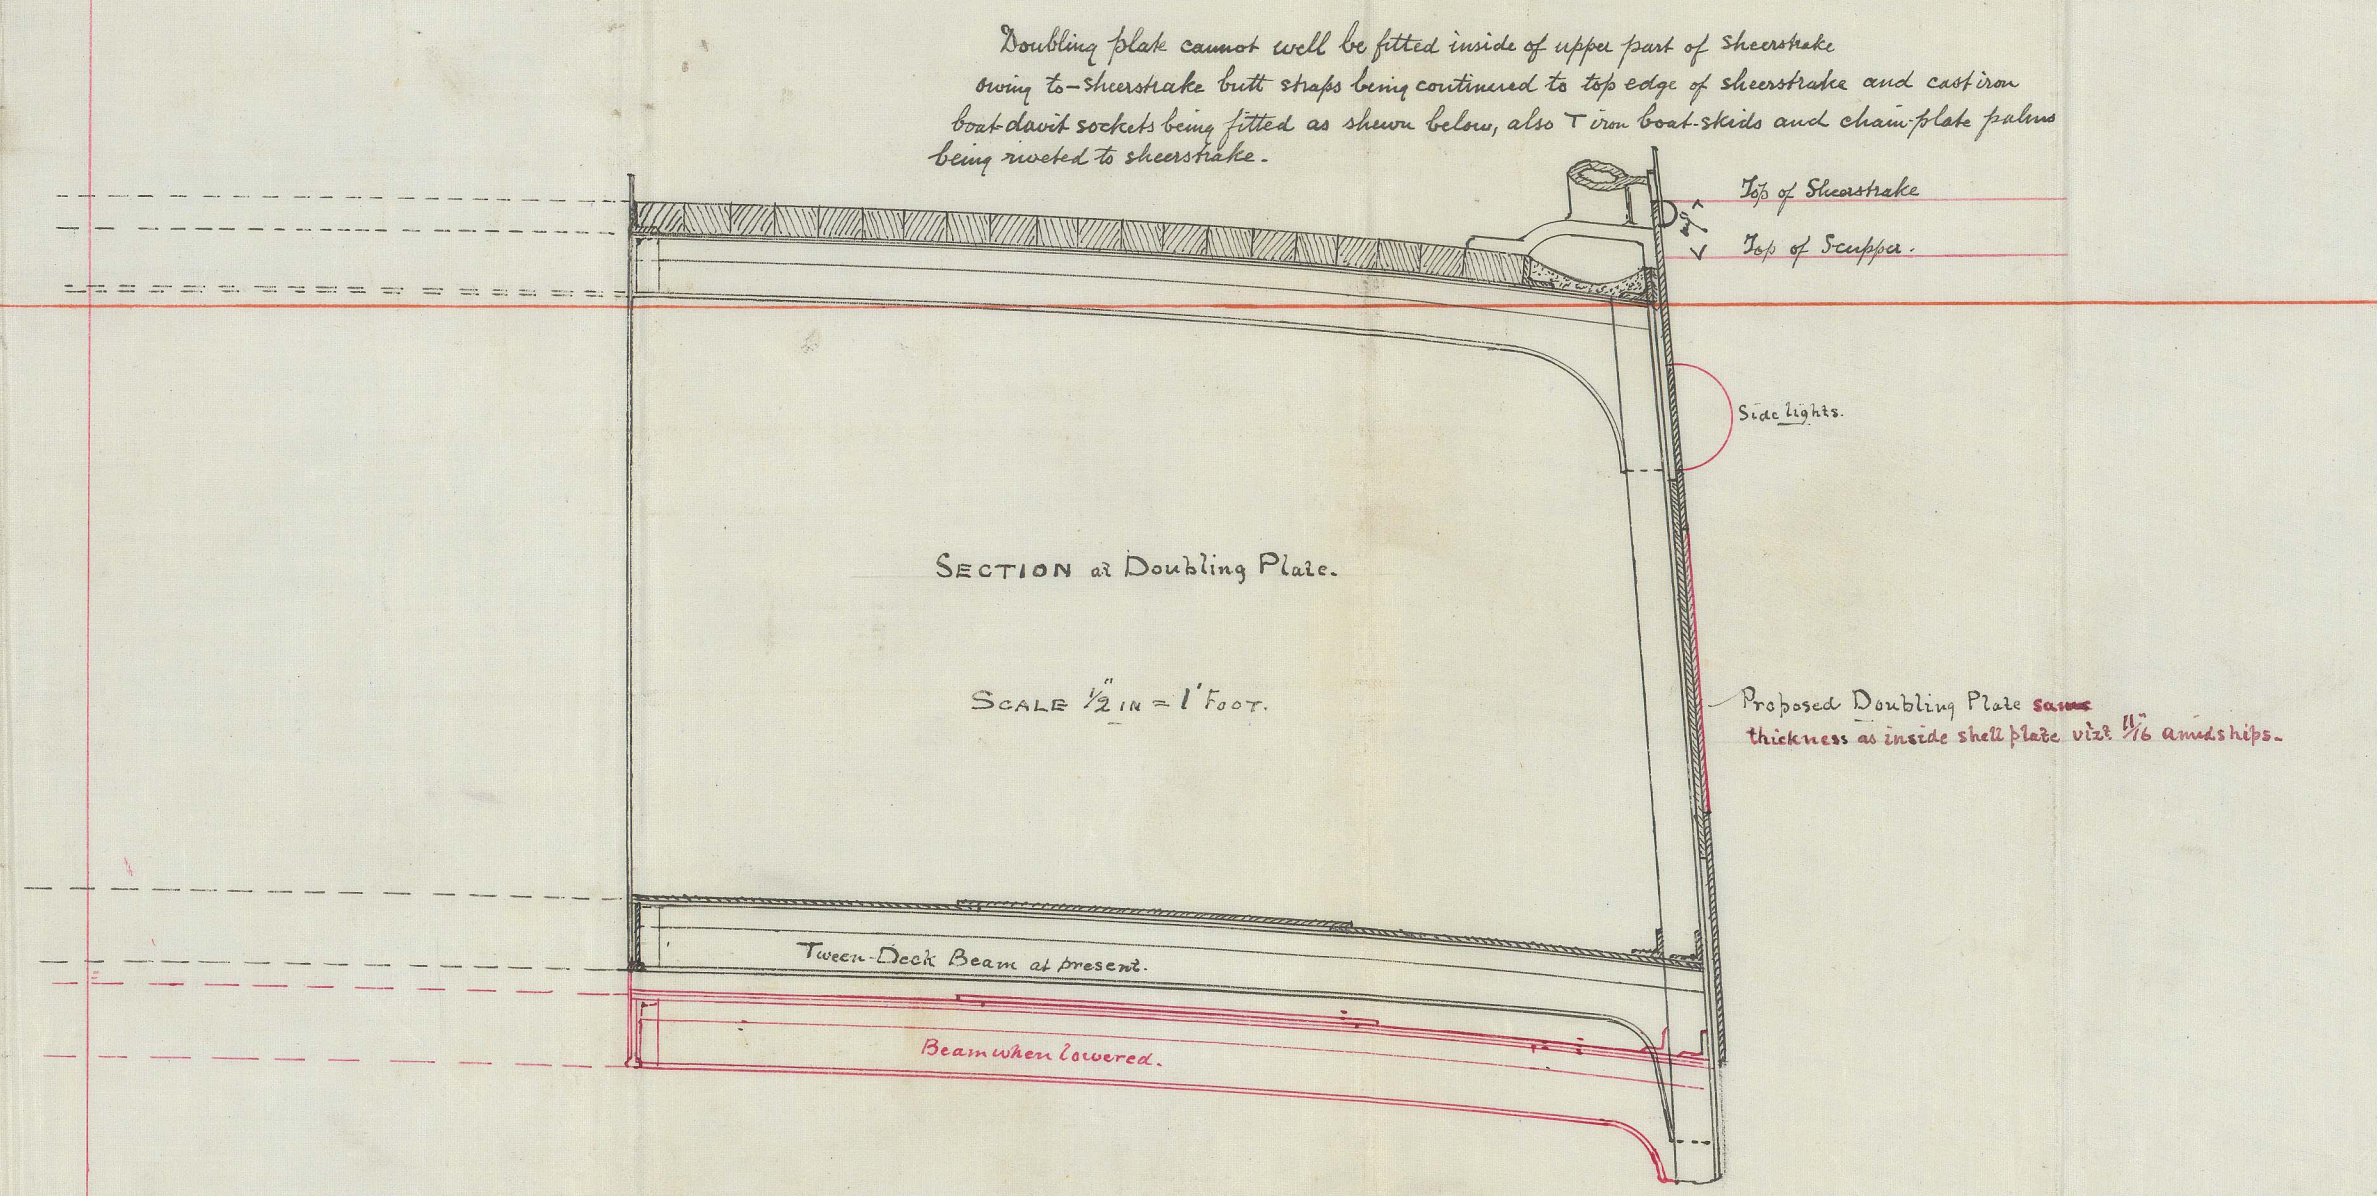
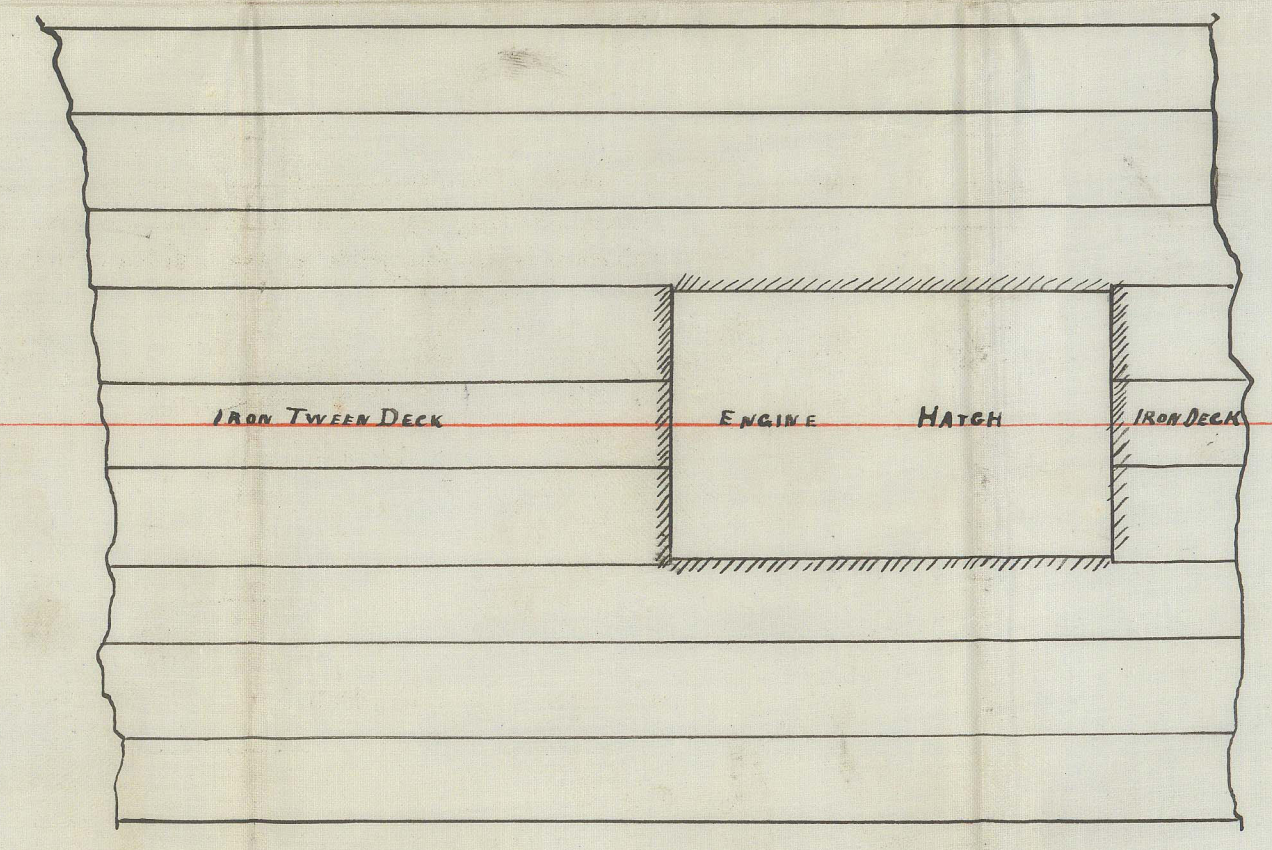


MON 28 JUL 90

CARGO CAPACITIES

Fore Peak	Upper Peak	115 Tons
	Orlop	40 "
	Lower Peak	112 "
After Peak		99 "
Fore Lower Hold		458
Main Tween Deck		478
After Tween Deck		427
Middle Tween Deck		275
After Lower Hold		730
Main Lower Hold		653
Store Room		30
Total		3477 Tons

Cargo Plan of
S.S. MERIONETHSHIRE now "Caribbee."
Scale 1/8" = One foot
Reg. N^o 1113.

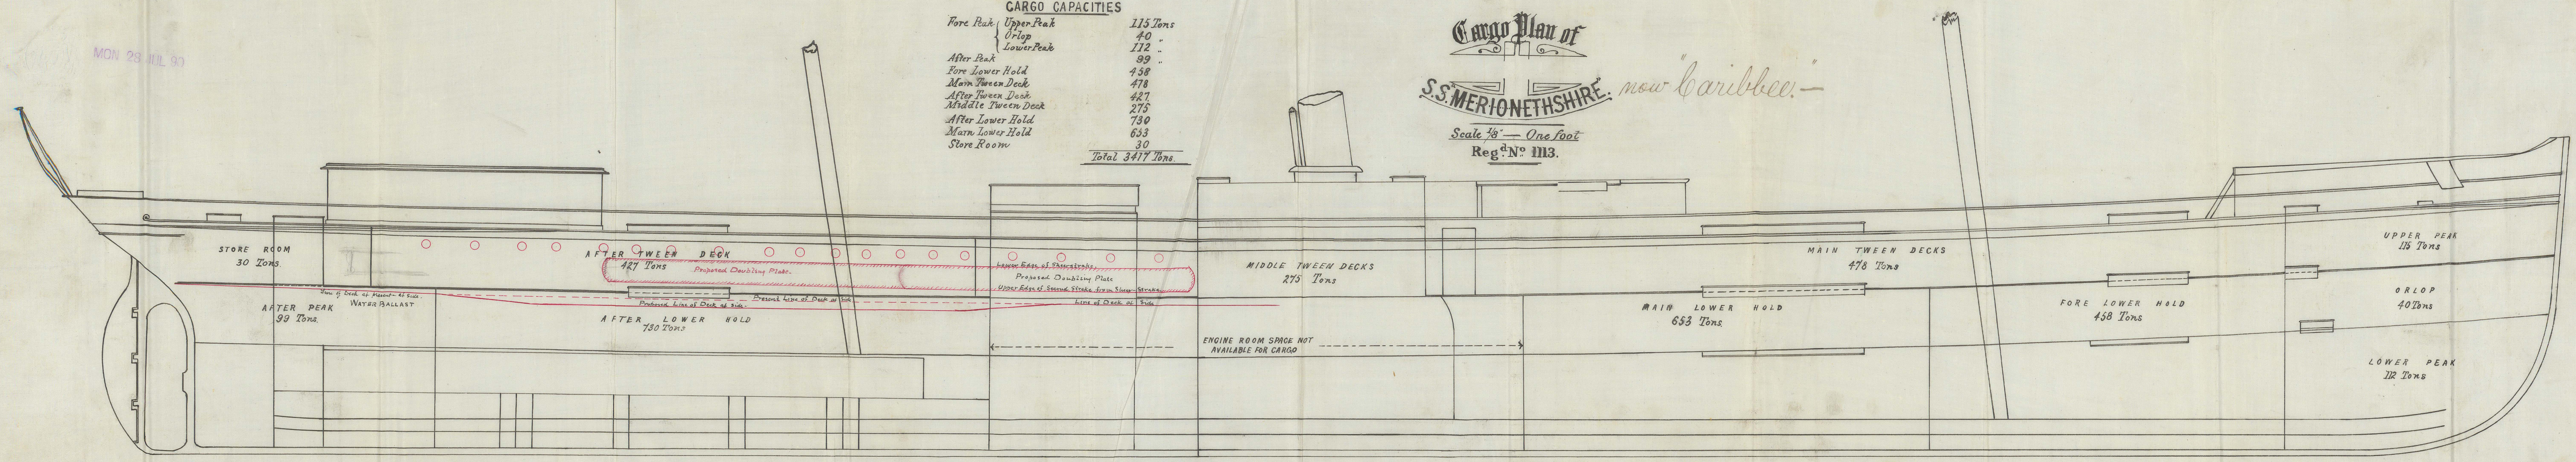

26/7/90
J.H.L.

26/7/90
J.H.L.

GLS221-0018

GLS221 - 0018

"Caribbee"

Glasgow Report

N^o 10220.—

Beam when lowered.


SCALE 1/2 in = 1 foot

SECTION A Doubling Plate.


ENGINE




© 2021

Lloyd's Register
Foundation