

Lloyd's Register of British and Foreign Shipping.

(Report on Vessel No. 10434 Port Glasgow)

S.S. "Lismore Castle,"

No. 2207

SHIP FORGINGS ~~OR CASTINGS.~~

I have to report that the undermentioned Iron or Steel Forgings or Castings, manufactured by

The Lancefield Forge Coy. of Glasgow.

for the Vessel No. 363, being built by Messrs. Barclay, Curle & Coy.

of Glasgow have been inspected by me as set forth below, and found

to be, so far as can be seen, Sound & efficient.

The words FORGINGS or CASTINGS, IRON or STEEL, should be struck out as may be required.

Mark on Forgings.

Lloyd's
No 2207
F.C.


Frank Cook.

Glasgow.
28/6/90

	STERN FRAME.	RUDDER FRAME.	STEM.
Material*	/	Scrap iron.	/
How made		Forged.	
Dimensions		9 1/2	
Progress on Inspection		Forging & smithing	
Dates when Inspected		22.27.30/11/89.11/12/89 9.14.16.22/1/90.4.28/2/90	

SKETCHES OF FRAMES SHEWING POSITION AND DESCRIPTION OF WELDS OF FORGINGS, OR PARTICULARS OF TESTS APPLIED TO CASTINGS.

7.19.22.26.28.31/3/90.23.25/4/90
21.24.28/5/90.19.28/6/90

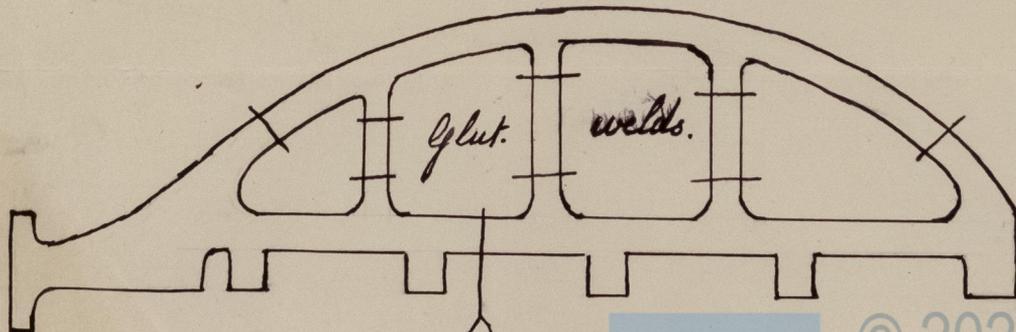

Scarp. Weld.



© 2021

Lloyd's Register
Foundation

* If of Iron, state whether scrap or puddled Iron.