



Lbr. 24. 90  
 1888  
 1889  
 1890  
 1891  
 1892  
 1893  
 1894  
 1895  
 1896  
 1897  
 1898  
 1899  
 1900



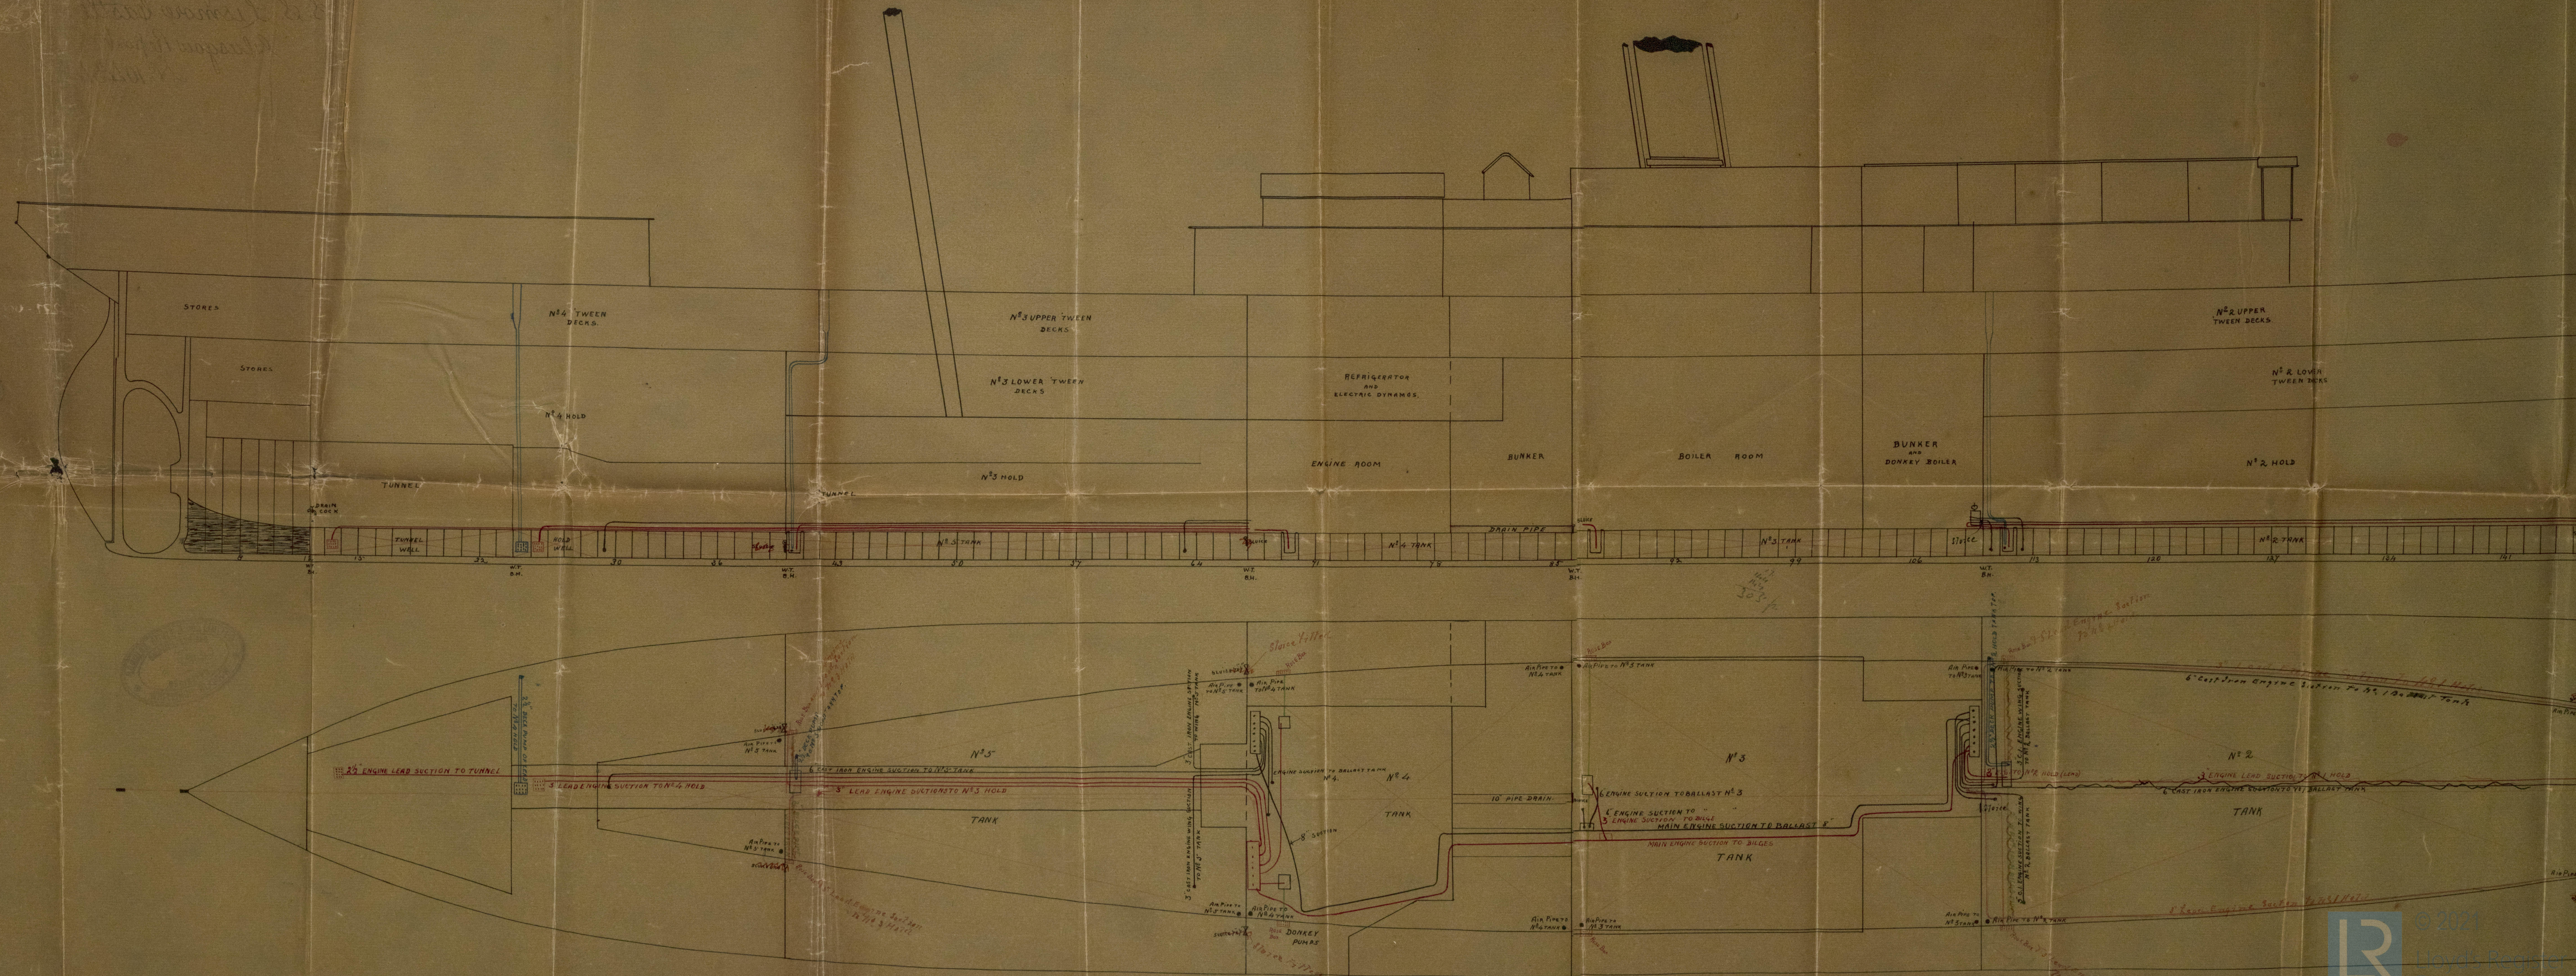


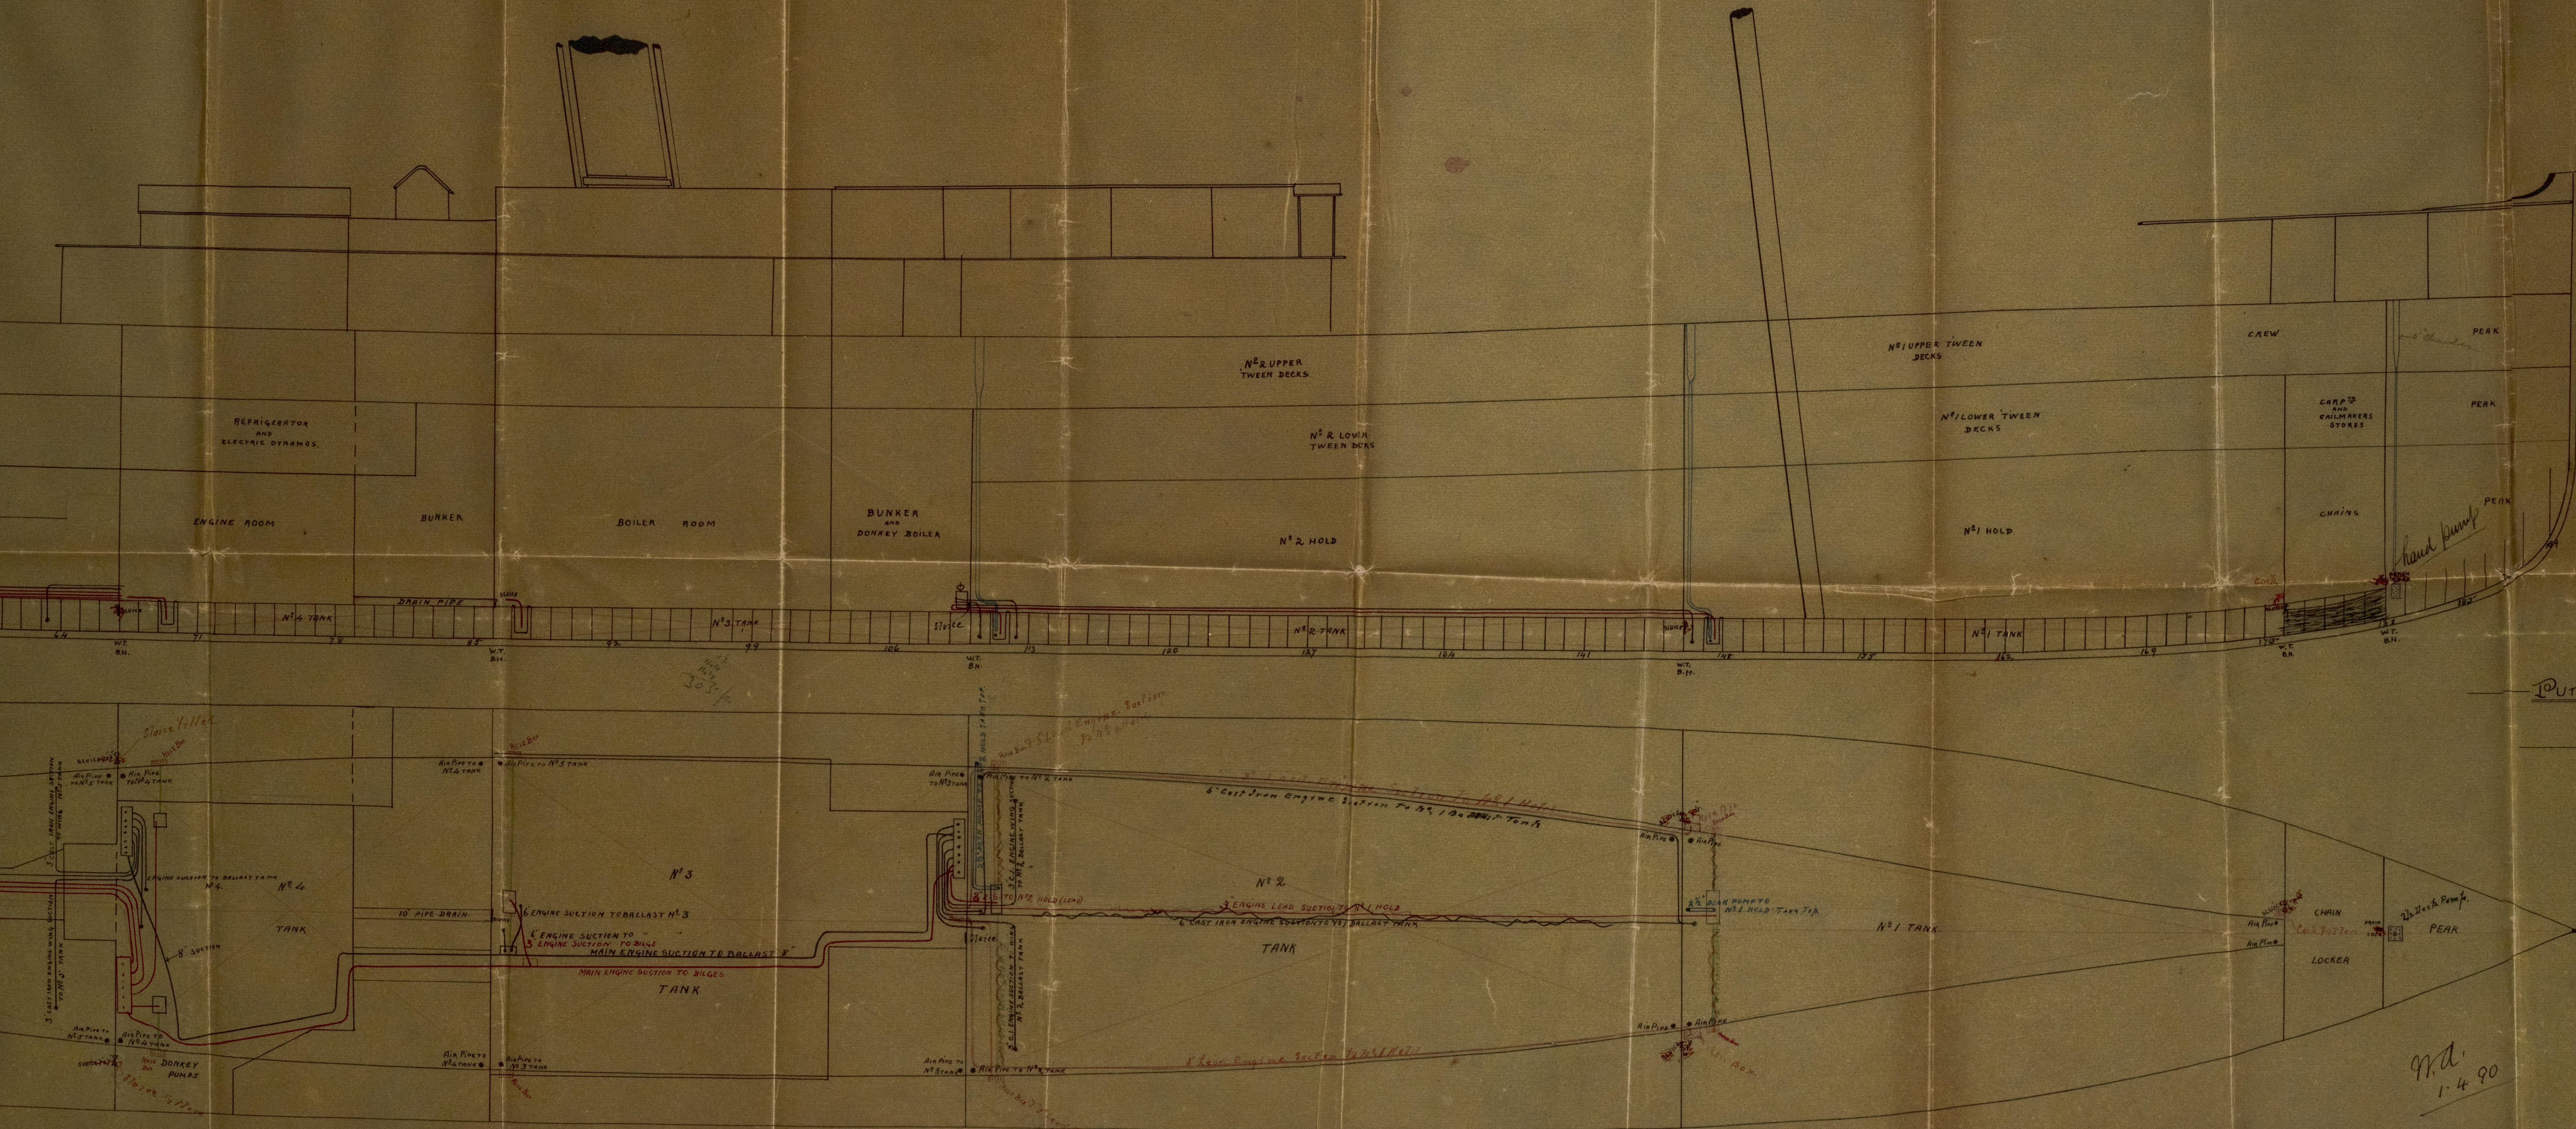

Pumping Arrangement

S.S. No. 362-3

SCALE 1/8" = 1 FOOT

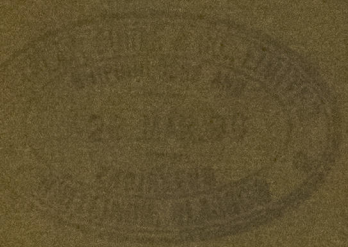

Read by Lloyd's for Mr. Hearley  
 Letter of 17th Dec 1890  
 He returned by Mr. Hearley, also  
 asking that the bottom of the ship be repaired

M.A.  
 1.4.90



S. S. "Dume Castle"  
Glasgow Report 10267  
S. S. "Lismore Castle"  
Glasgow Report  
No. 10434-

STORES

STORES

GL5222-0006-



© 2021

Lloyd's Register  
Foundation