



— S. S. No 362-3 —

— SECTION AT FRAME No 112 —

— SCALE  $\frac{1}{2}$ " —

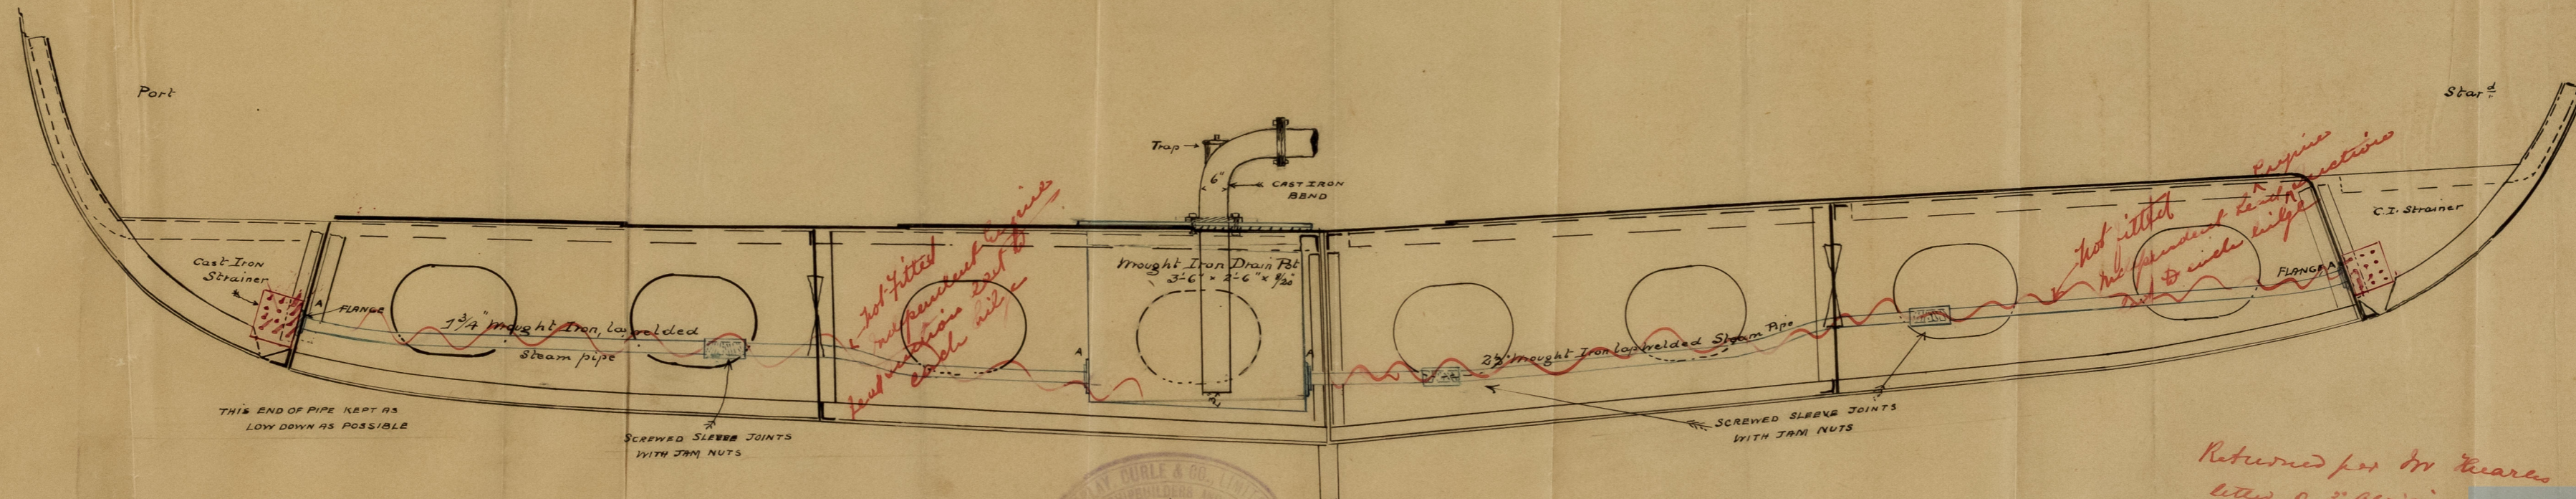

Returned for Mr. Kearns  
letter of 3<sup>rd</sup> April 90

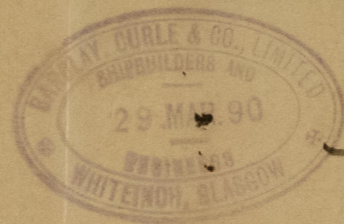

© 2021  
Lloyd's Register  
Foundation


GLS222-0007


GLS222-0007



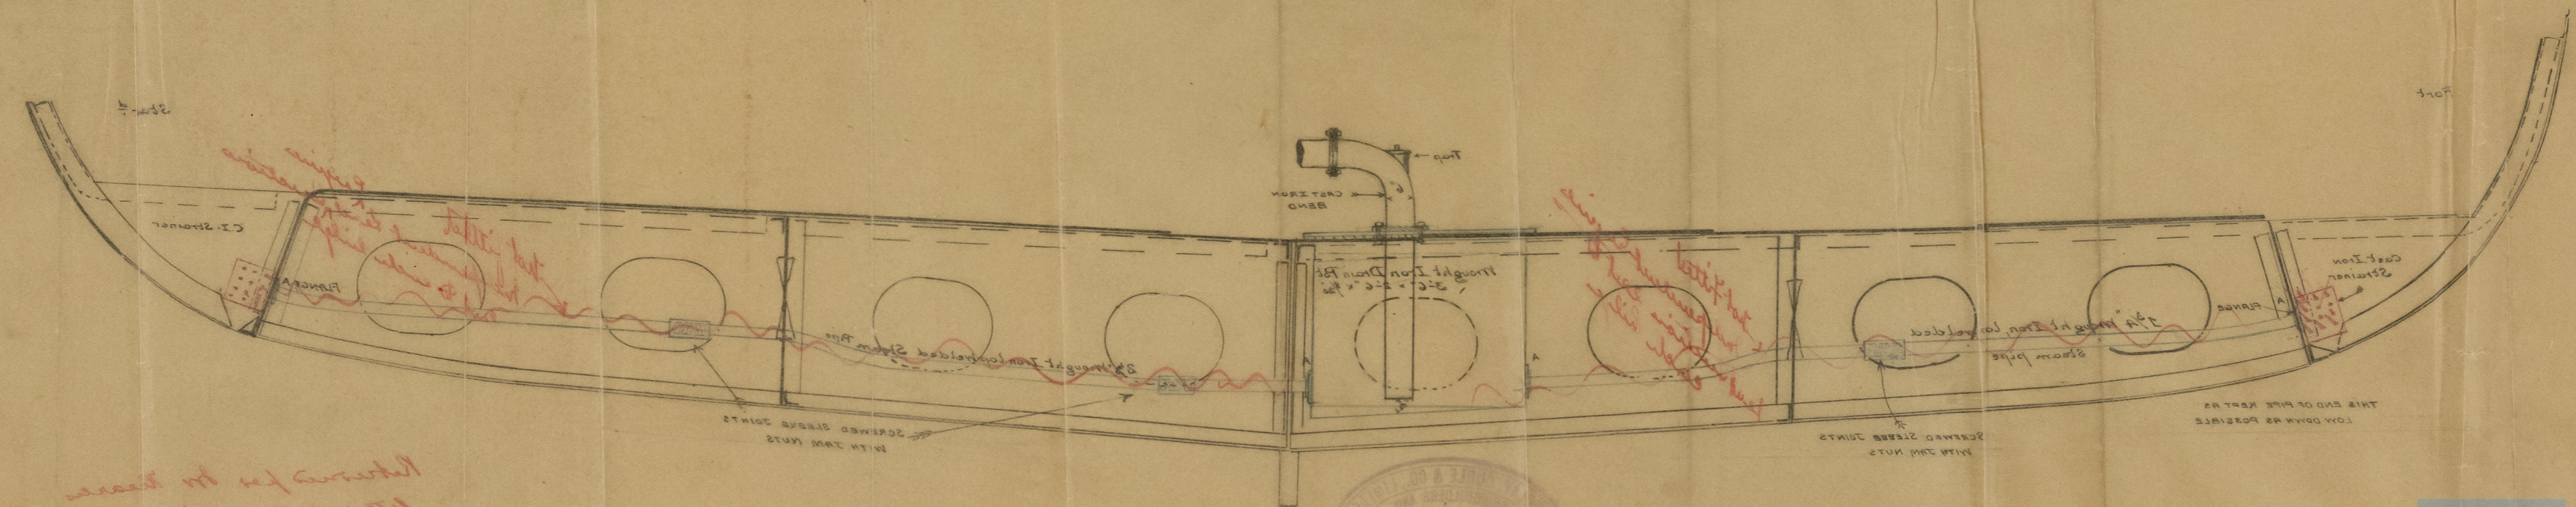


GLS222-0007