



1/4 24. 11. 90

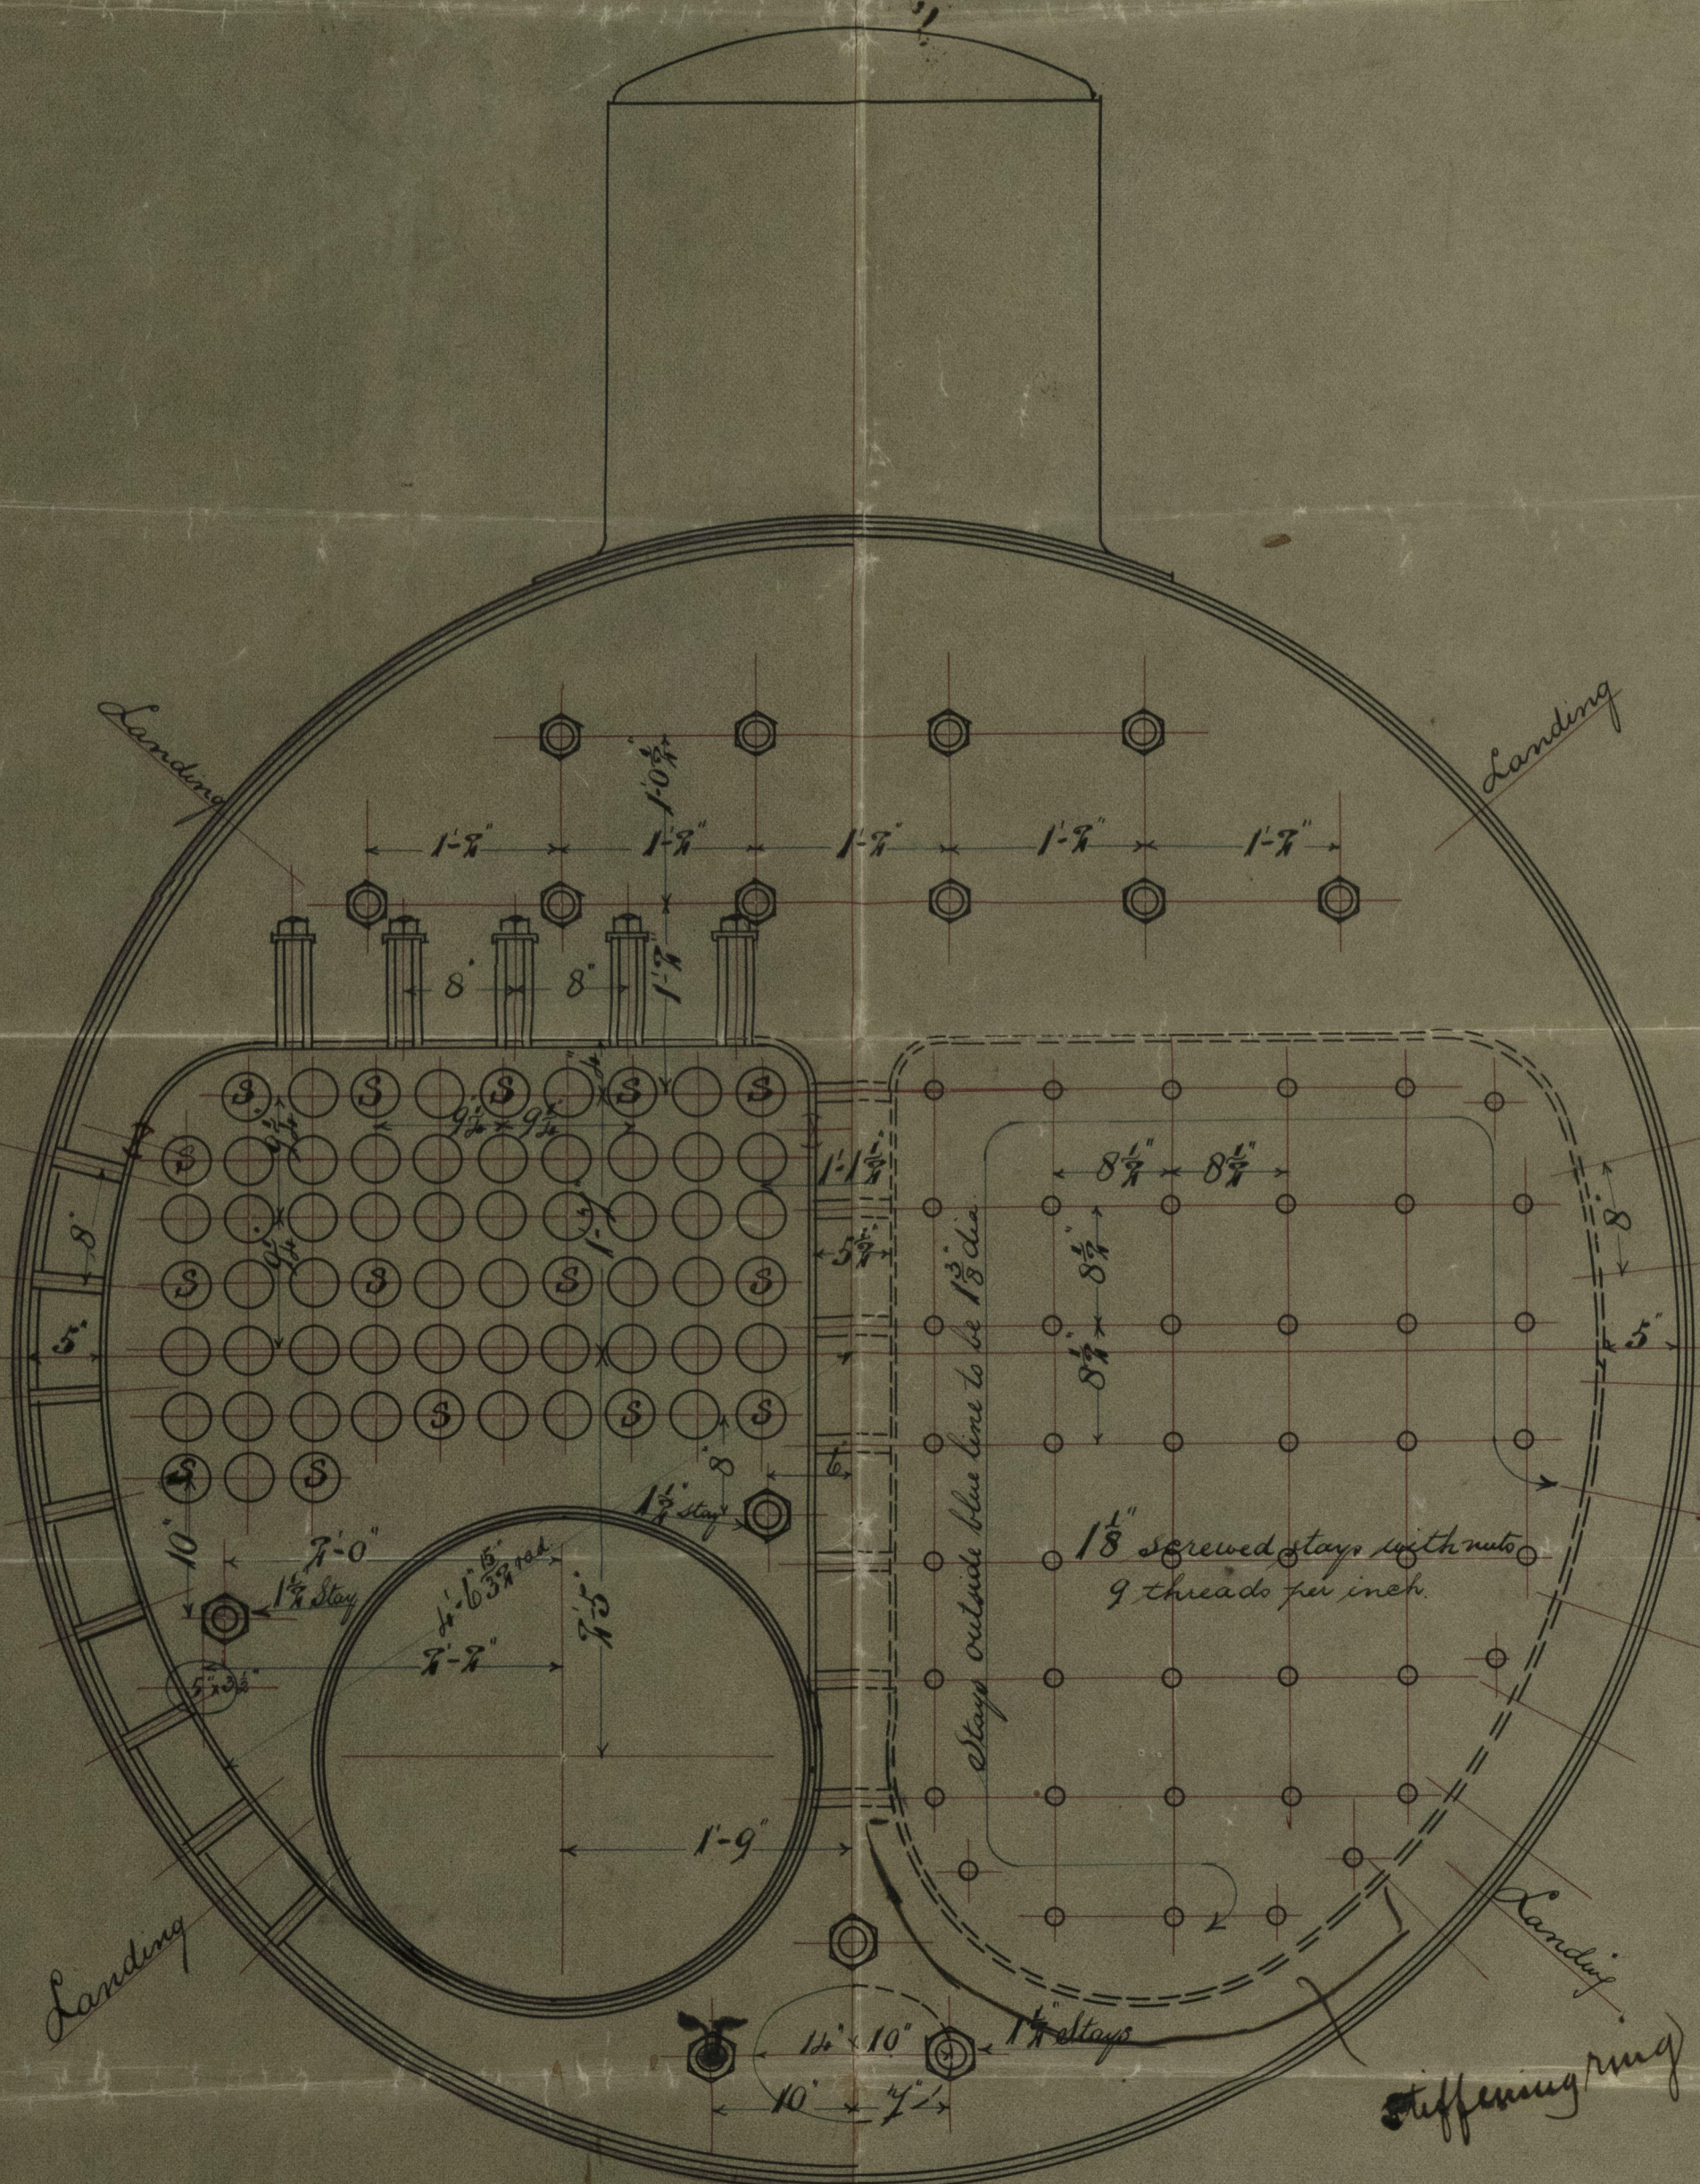

Boiler for 1/2 "Paradox"
10'-0" dia x 10'-0" long working pressure 10 lbs per sq"
Scale - 1 inch = 1 foot
To pass Lloyds

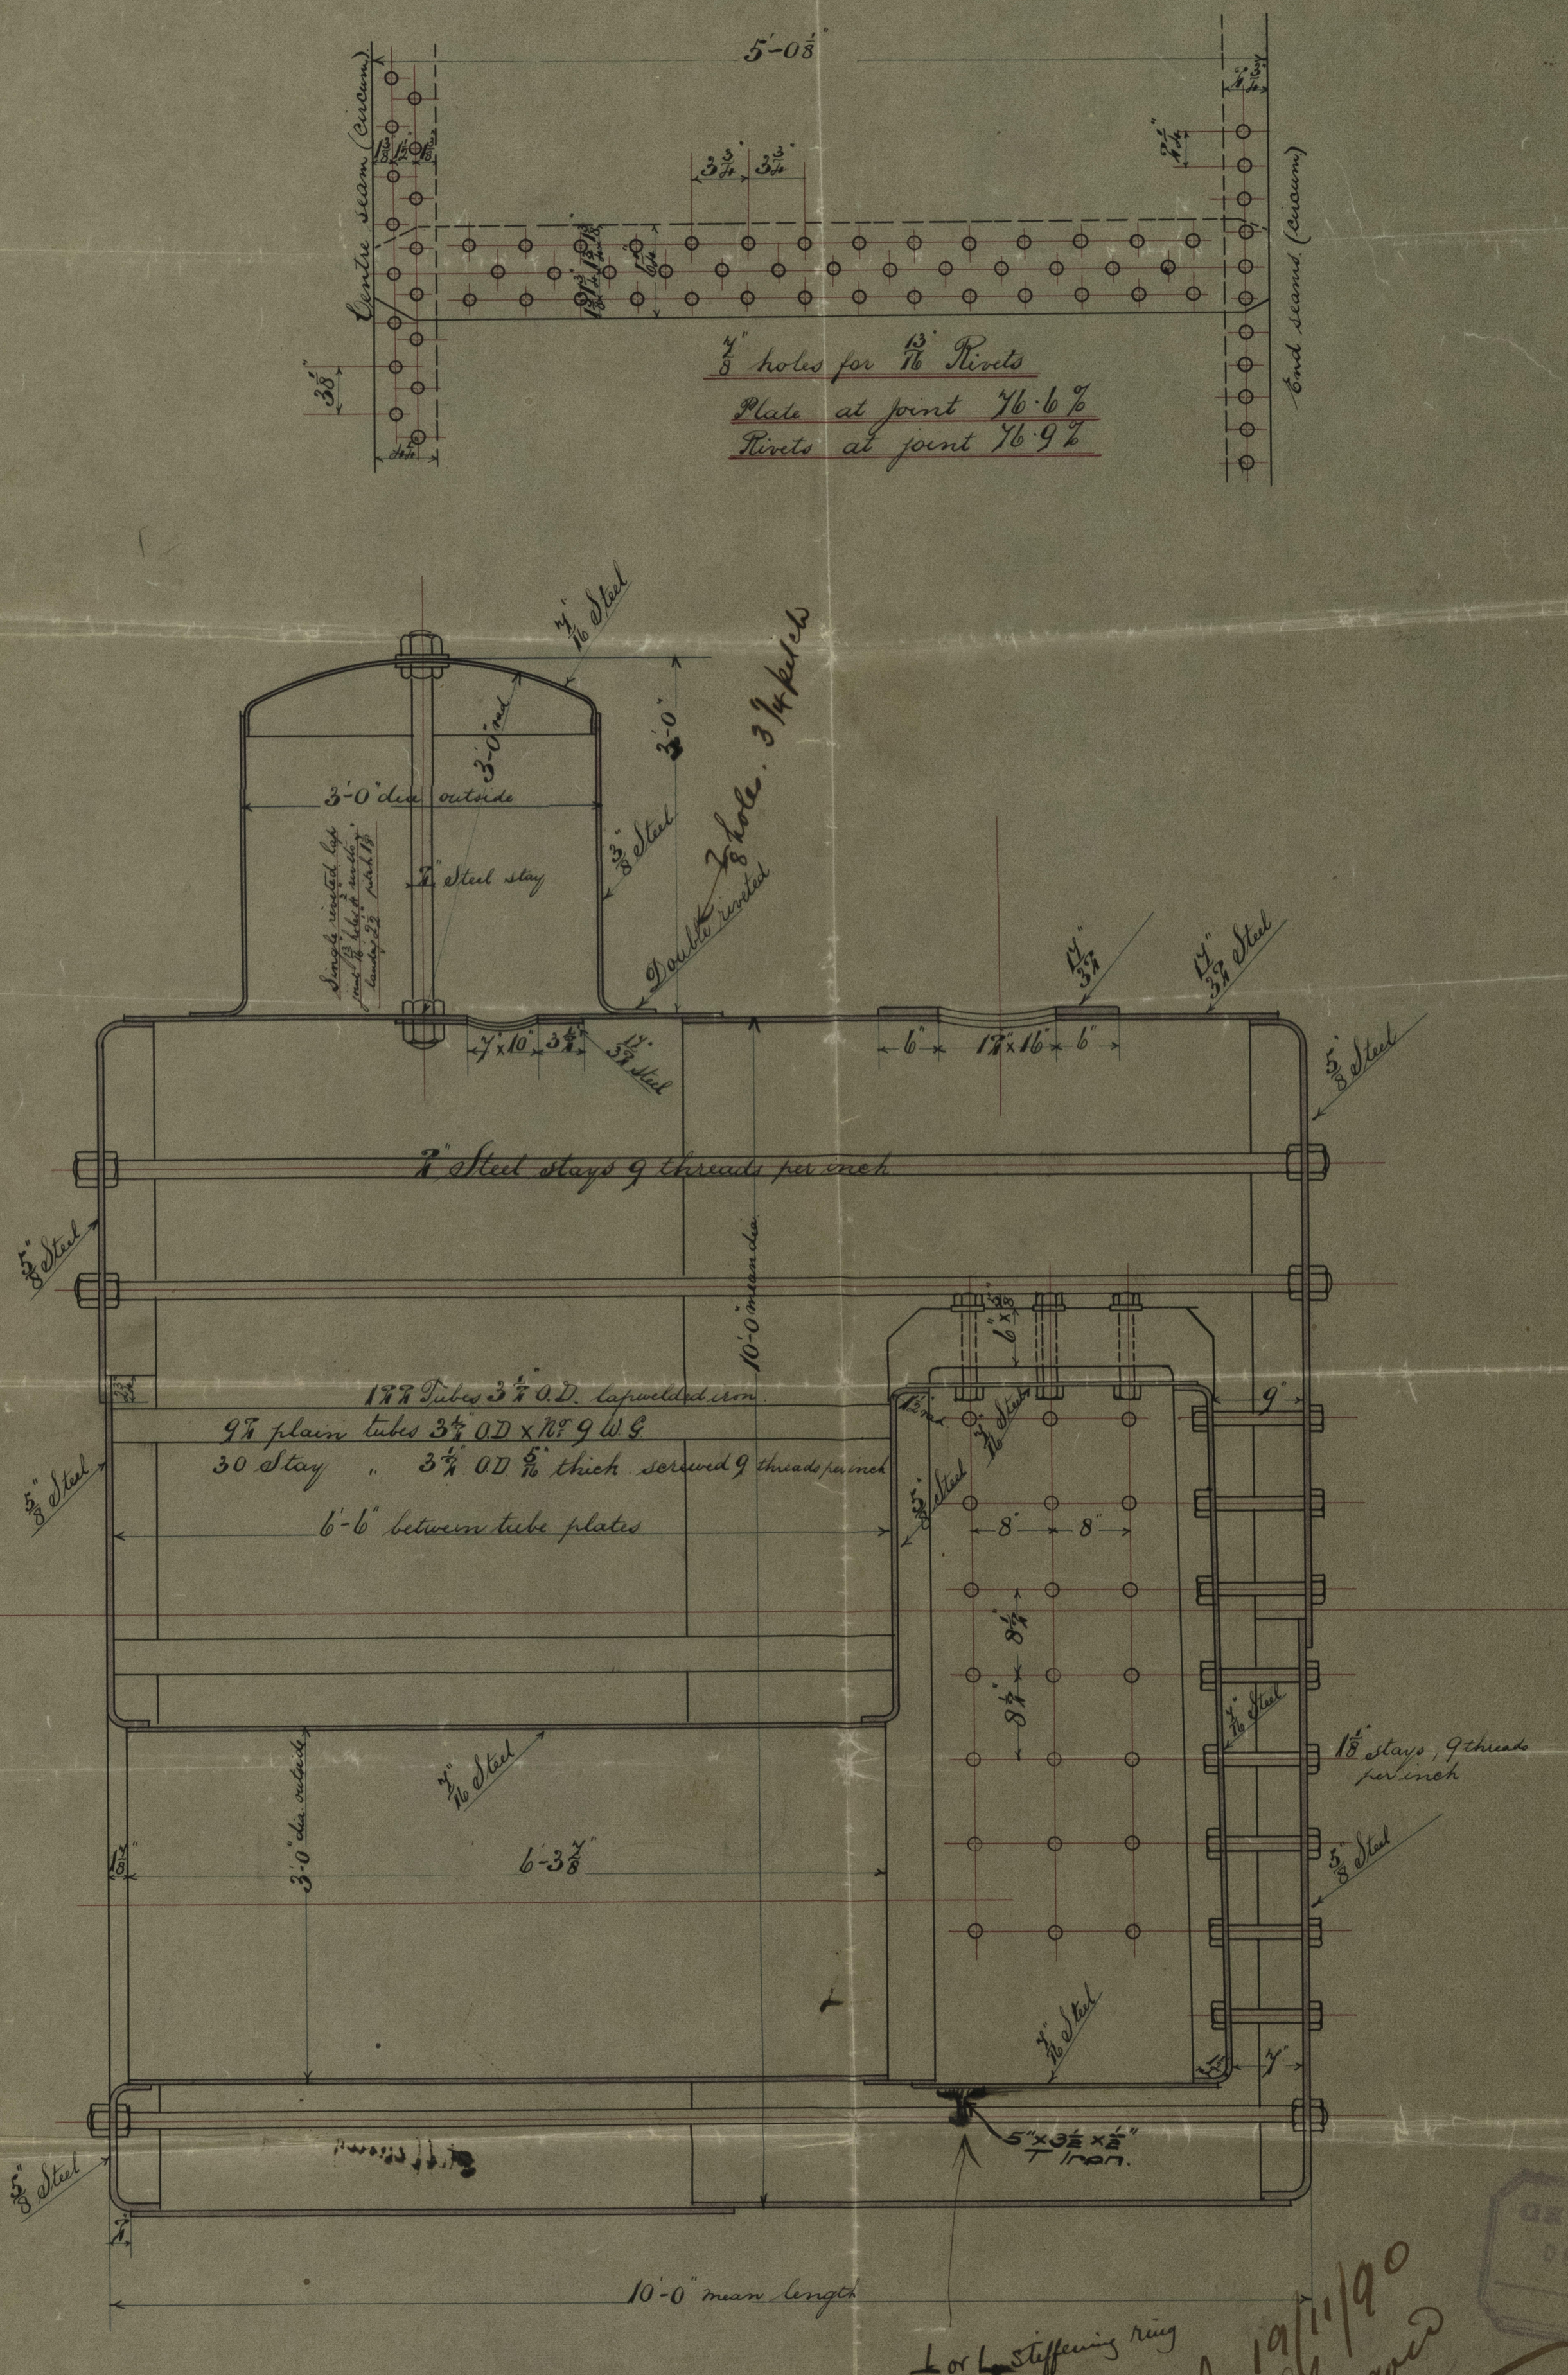

MOORE PARK BOILER WORKS
 30/10/90
 LINDSAY BURNET & CO
 Drawing No. 1274
 HELEN STREET, GOVAN, N.B. GLASGOW

J.T.M.
 21/11/90



19/11/90
 Glasgow

Bailer

^{for}
S. S. Paradox
Glasgow Report
No 10543.-

For
S. S. Paradox
Glasgow Report
No 10543.-

9/11/10
S. S. Paradox
Glasgow Report
No 10543.-

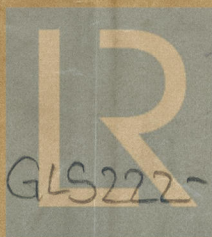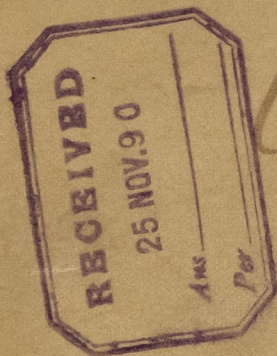

© 2021

Lloyd's Register
Foundation

GLS222-0103