


Wrote to Prof. B. B.
Tracy was well
- E. D. O. H.




PROMENADE DECK

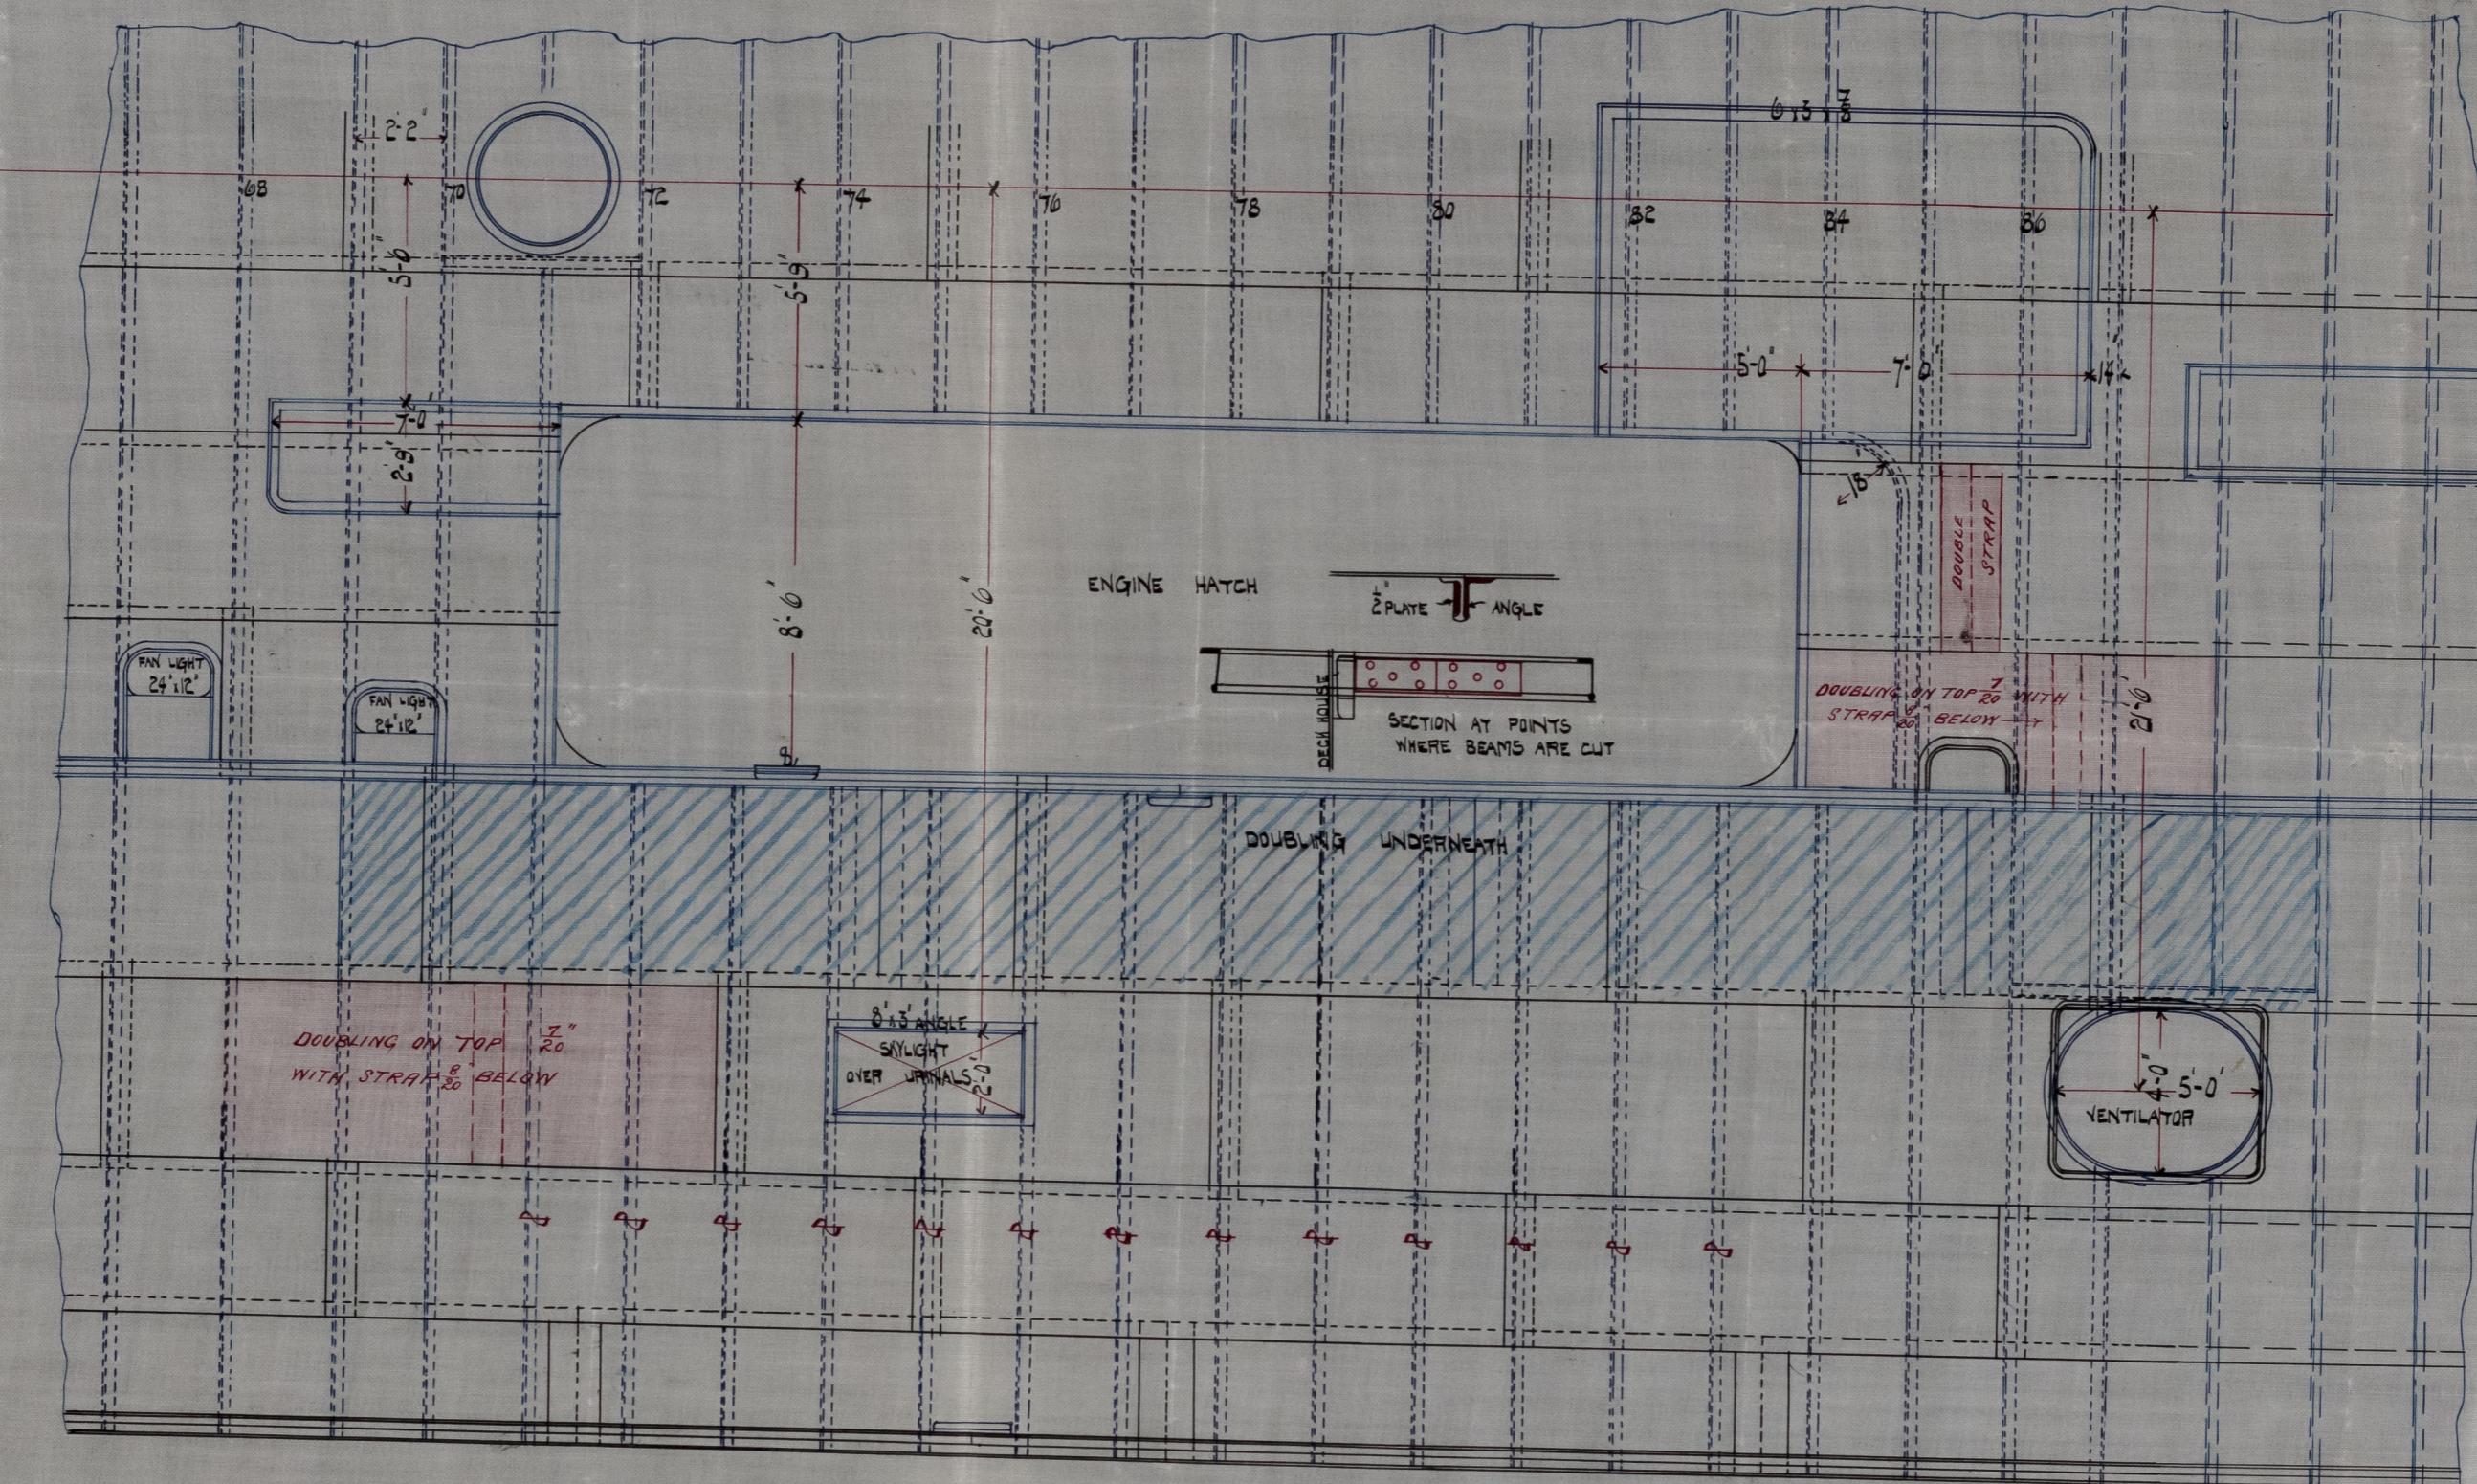

GLS222-0218

S.S. "City of Paris"
Glasgow Report
No. 10663.-

GLS 222-0218

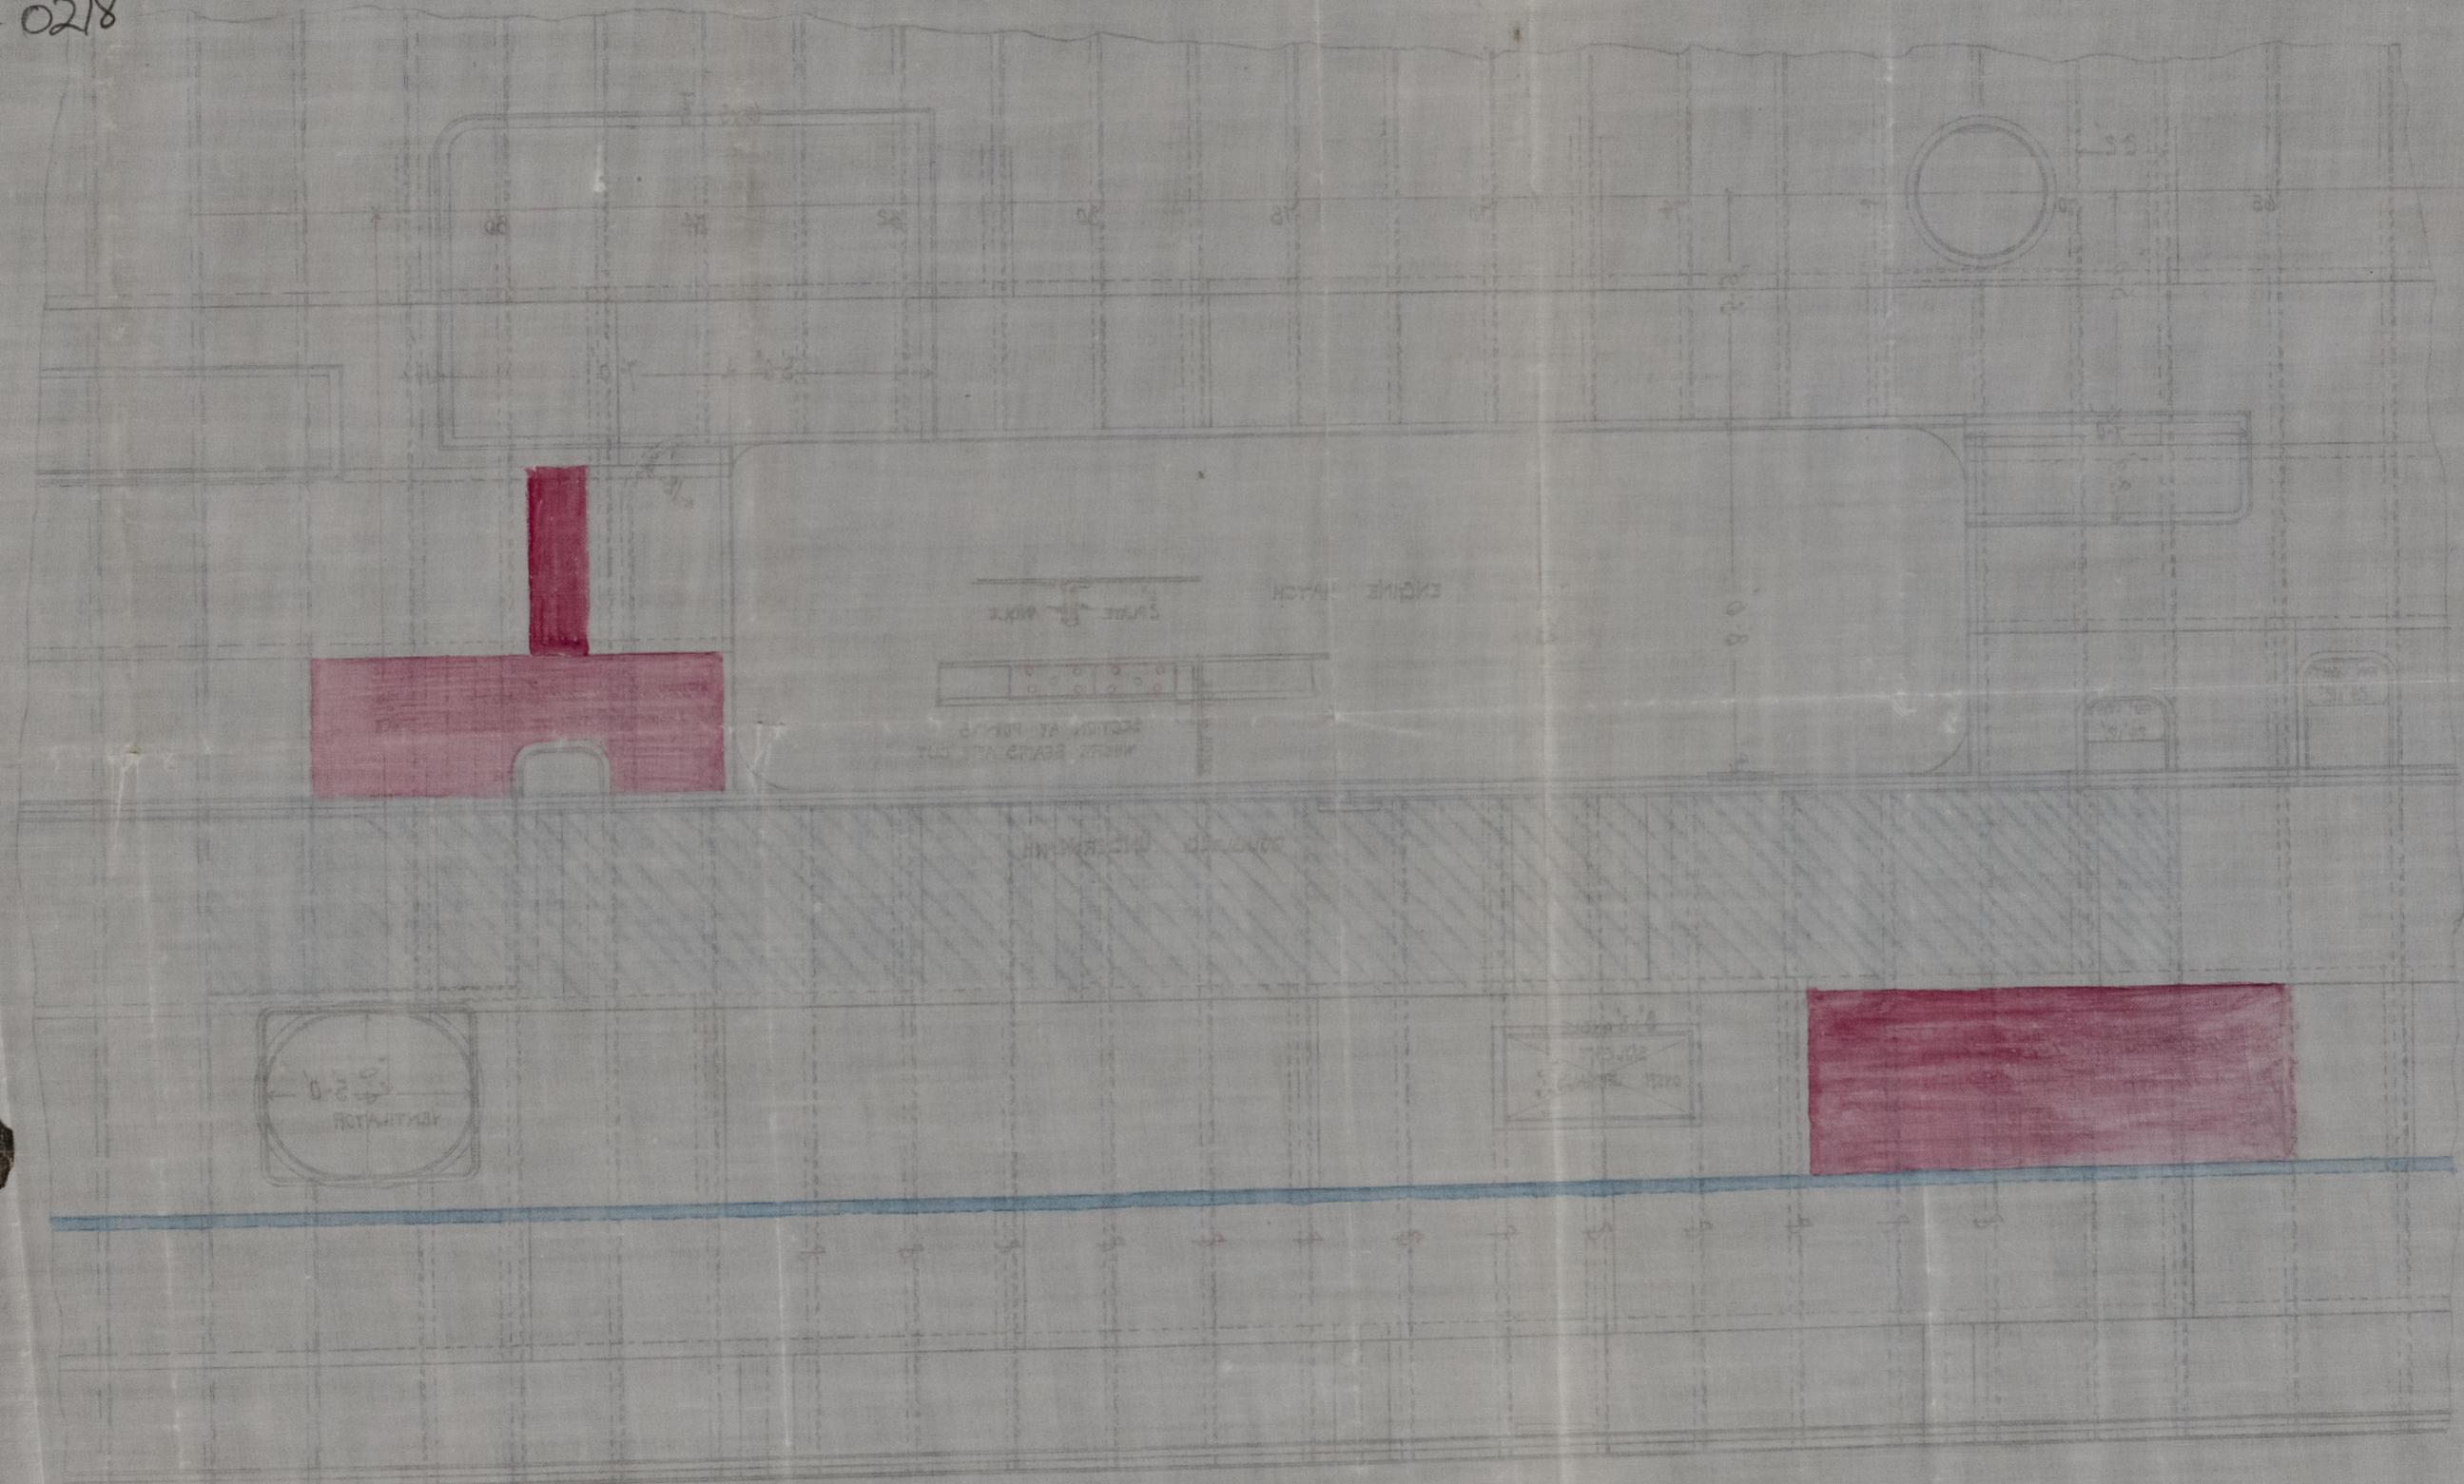

© 2021
Lloyd's Register
Foundation