


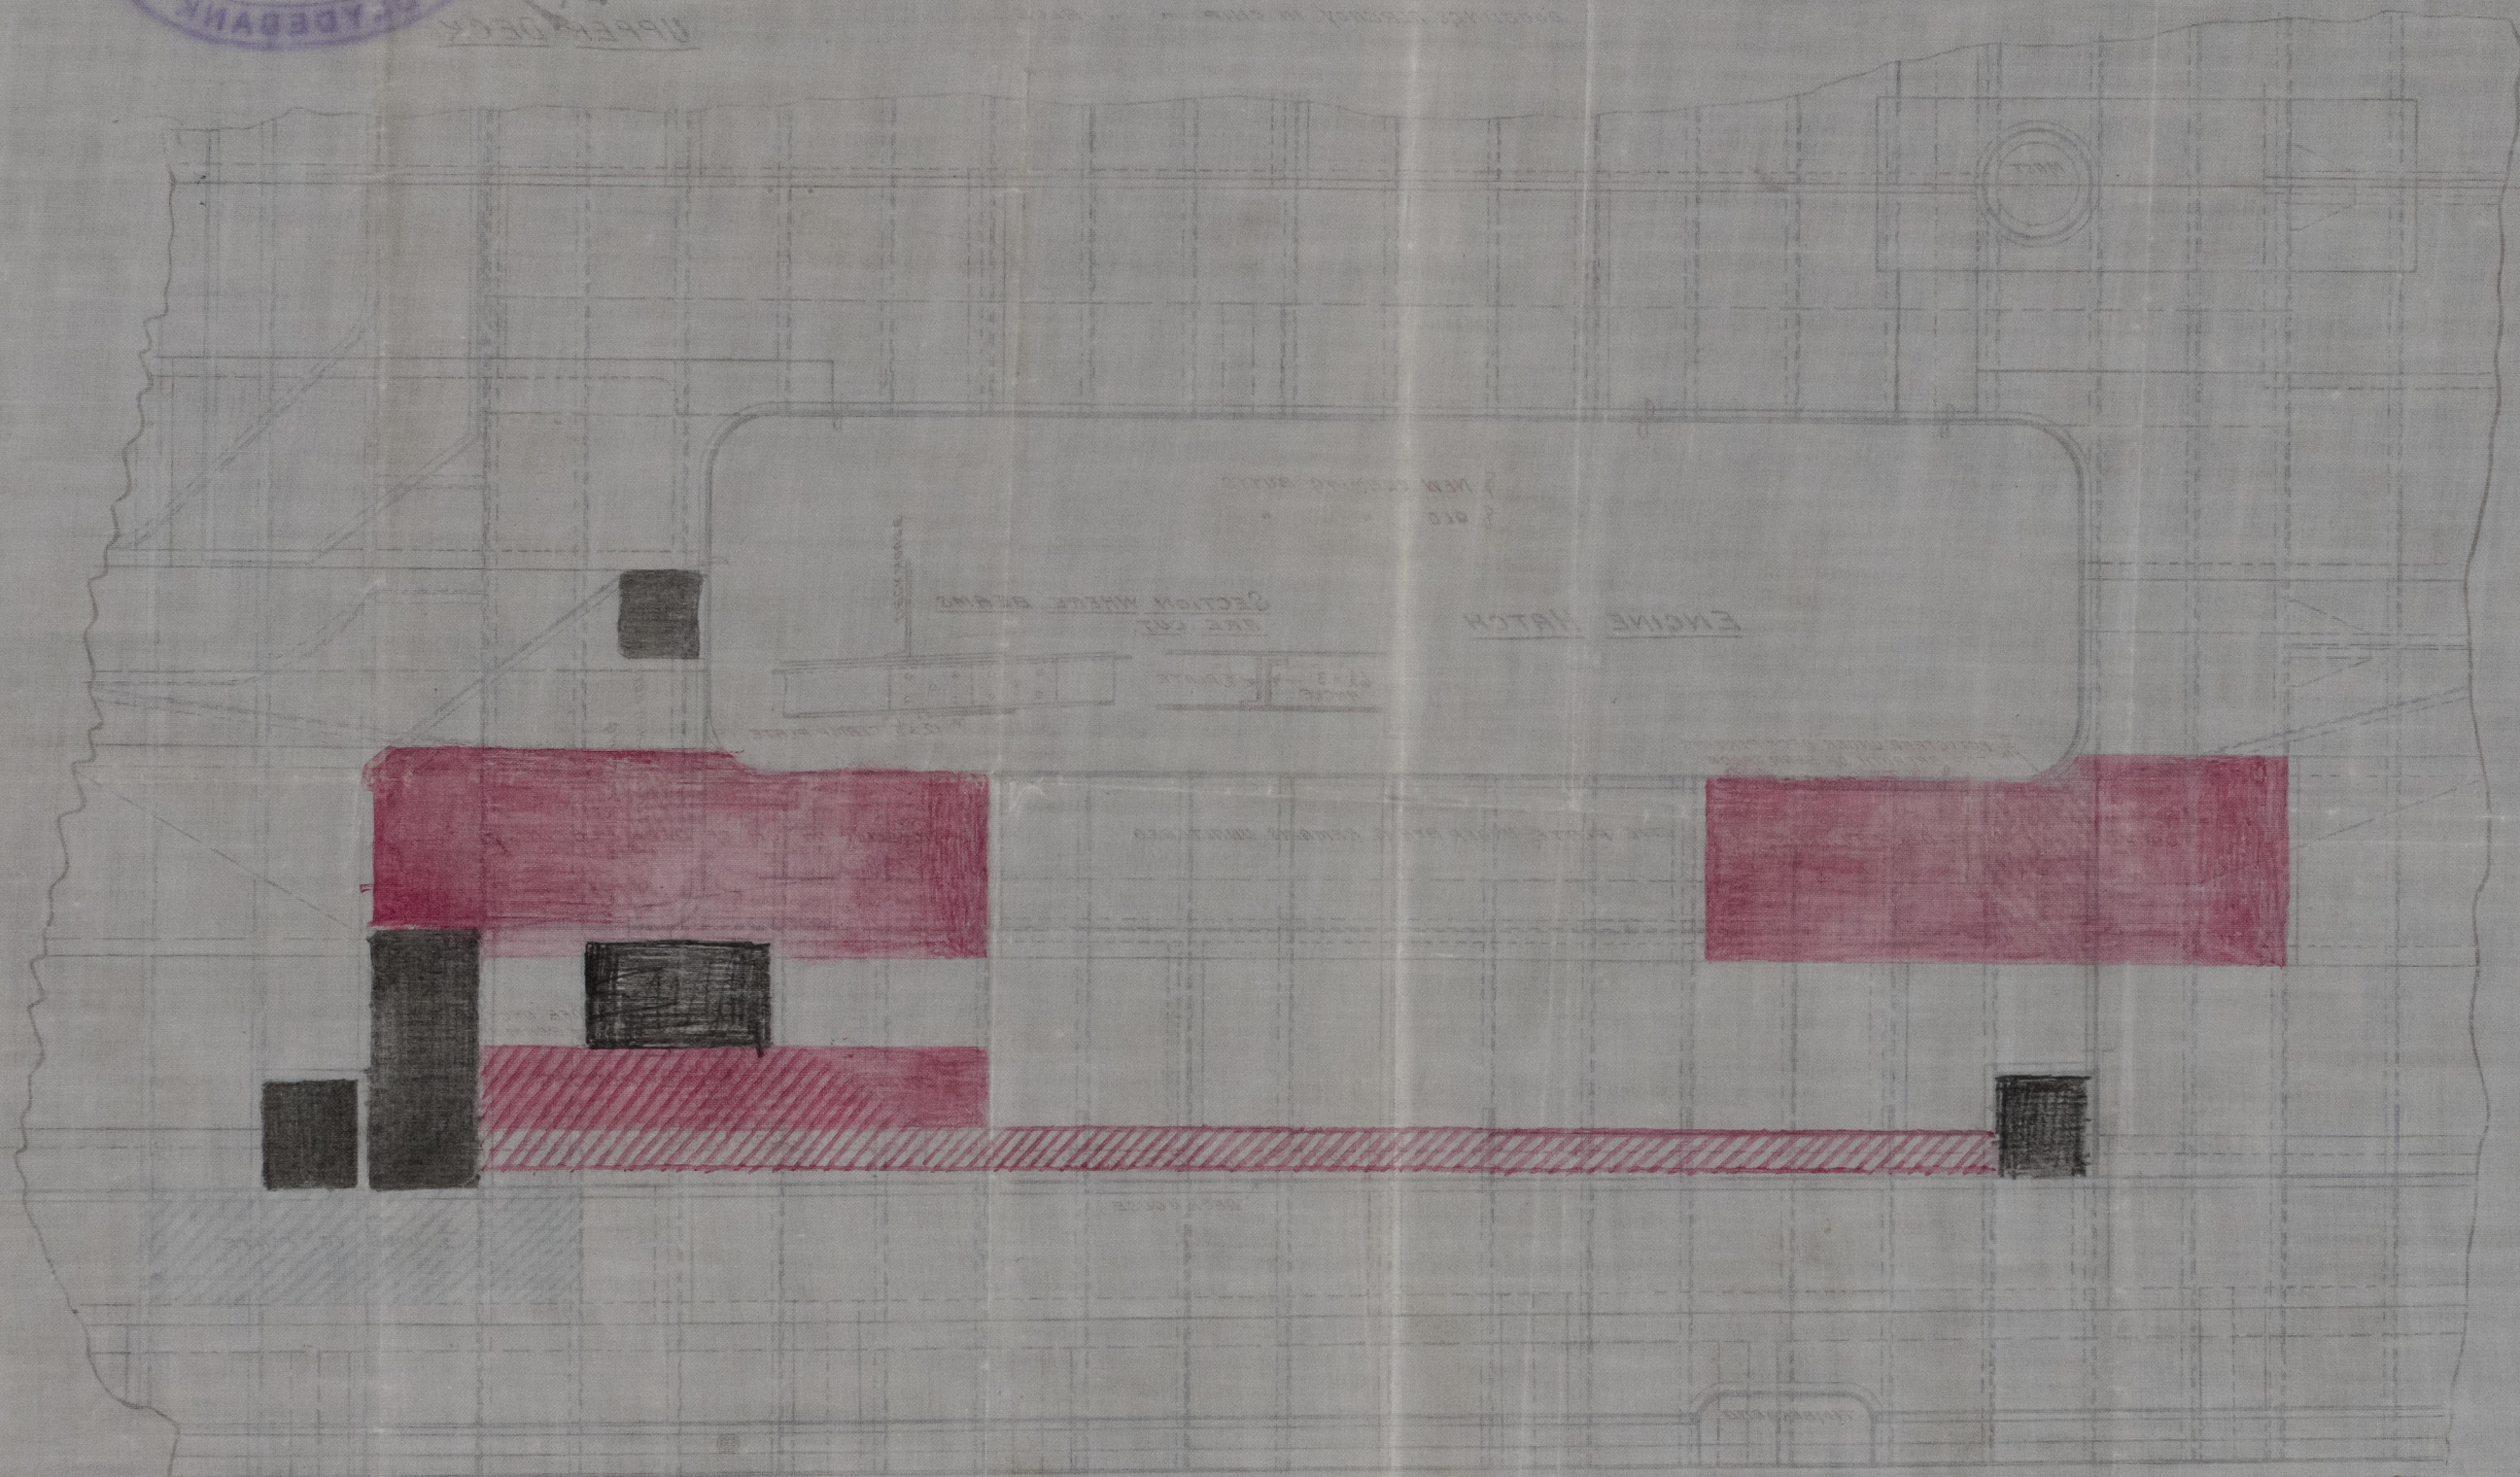



S.S. City of Paris  
Glasgow Report  
No. 10663.

GLS222-0219



10/12/22



© 2021

Lloyd's Register  
Foundation