


ms

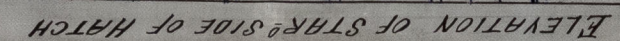


7th Plate

UPPER DECK





S.S. "City of Paris"  
Glasgow Report  
No 10663.-

GLS222-0220

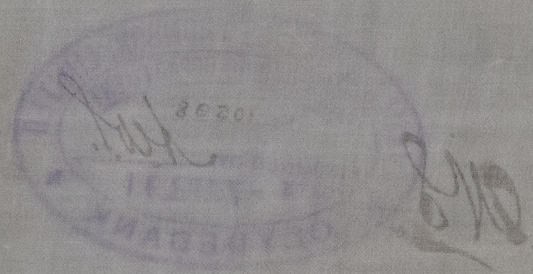

MAIN DECK

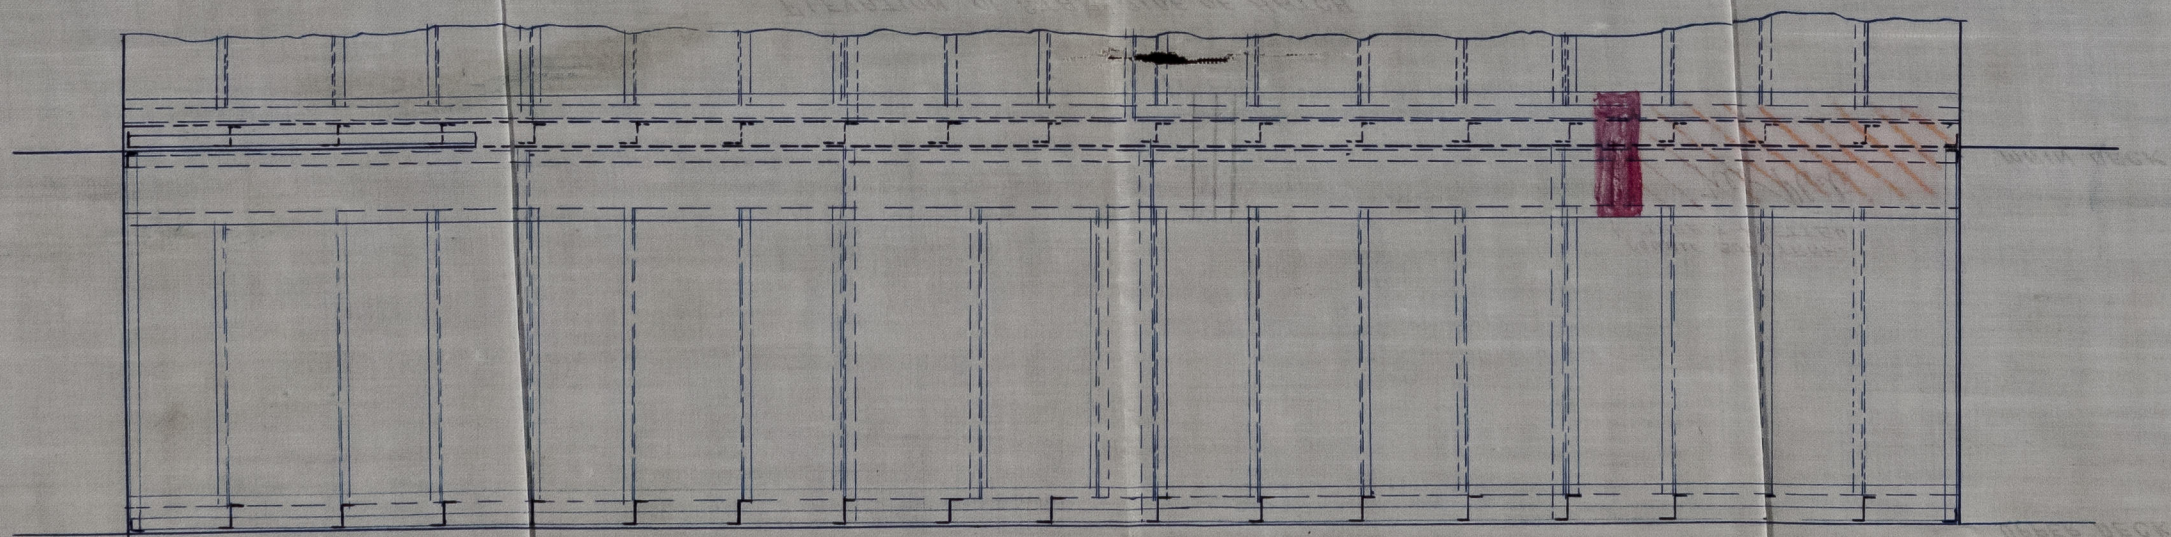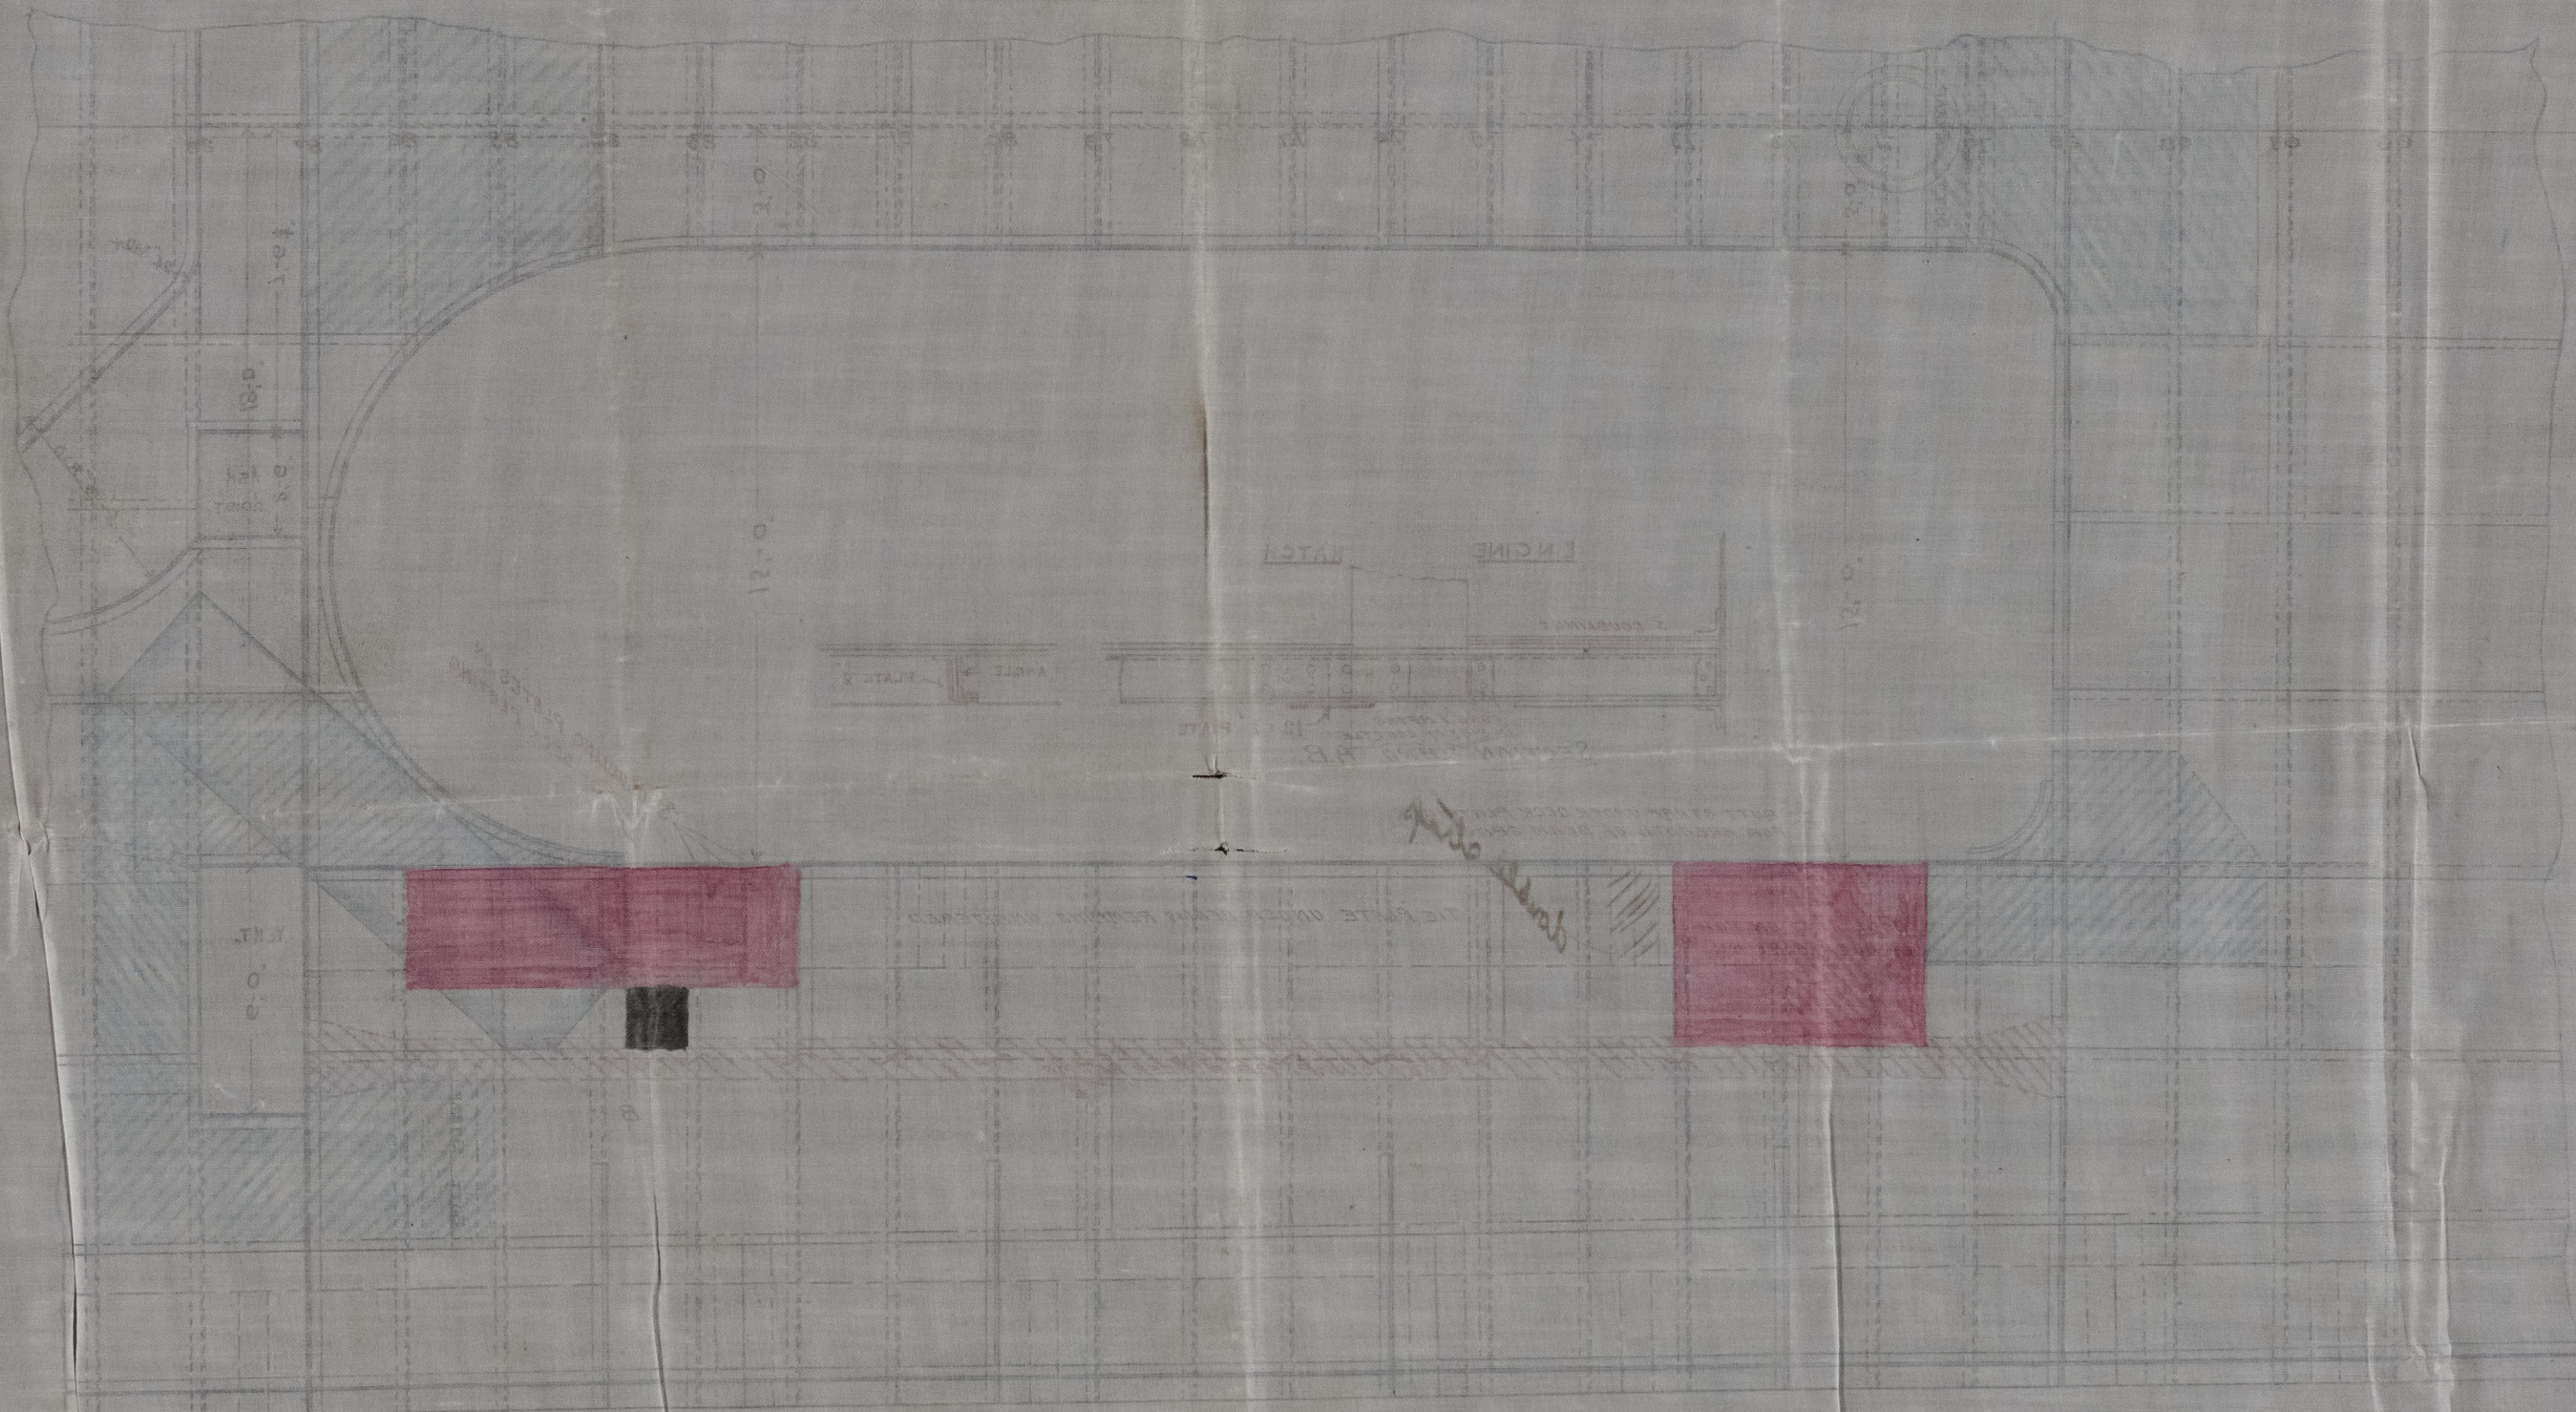

10/12/23



© 2021

Lloyd's Register  
Foundation