


15.1.91.


S. S. Borghese.


Scale $\frac{1}{2}$ Inch = 1 Foot.

Section in way of ordinary floor.

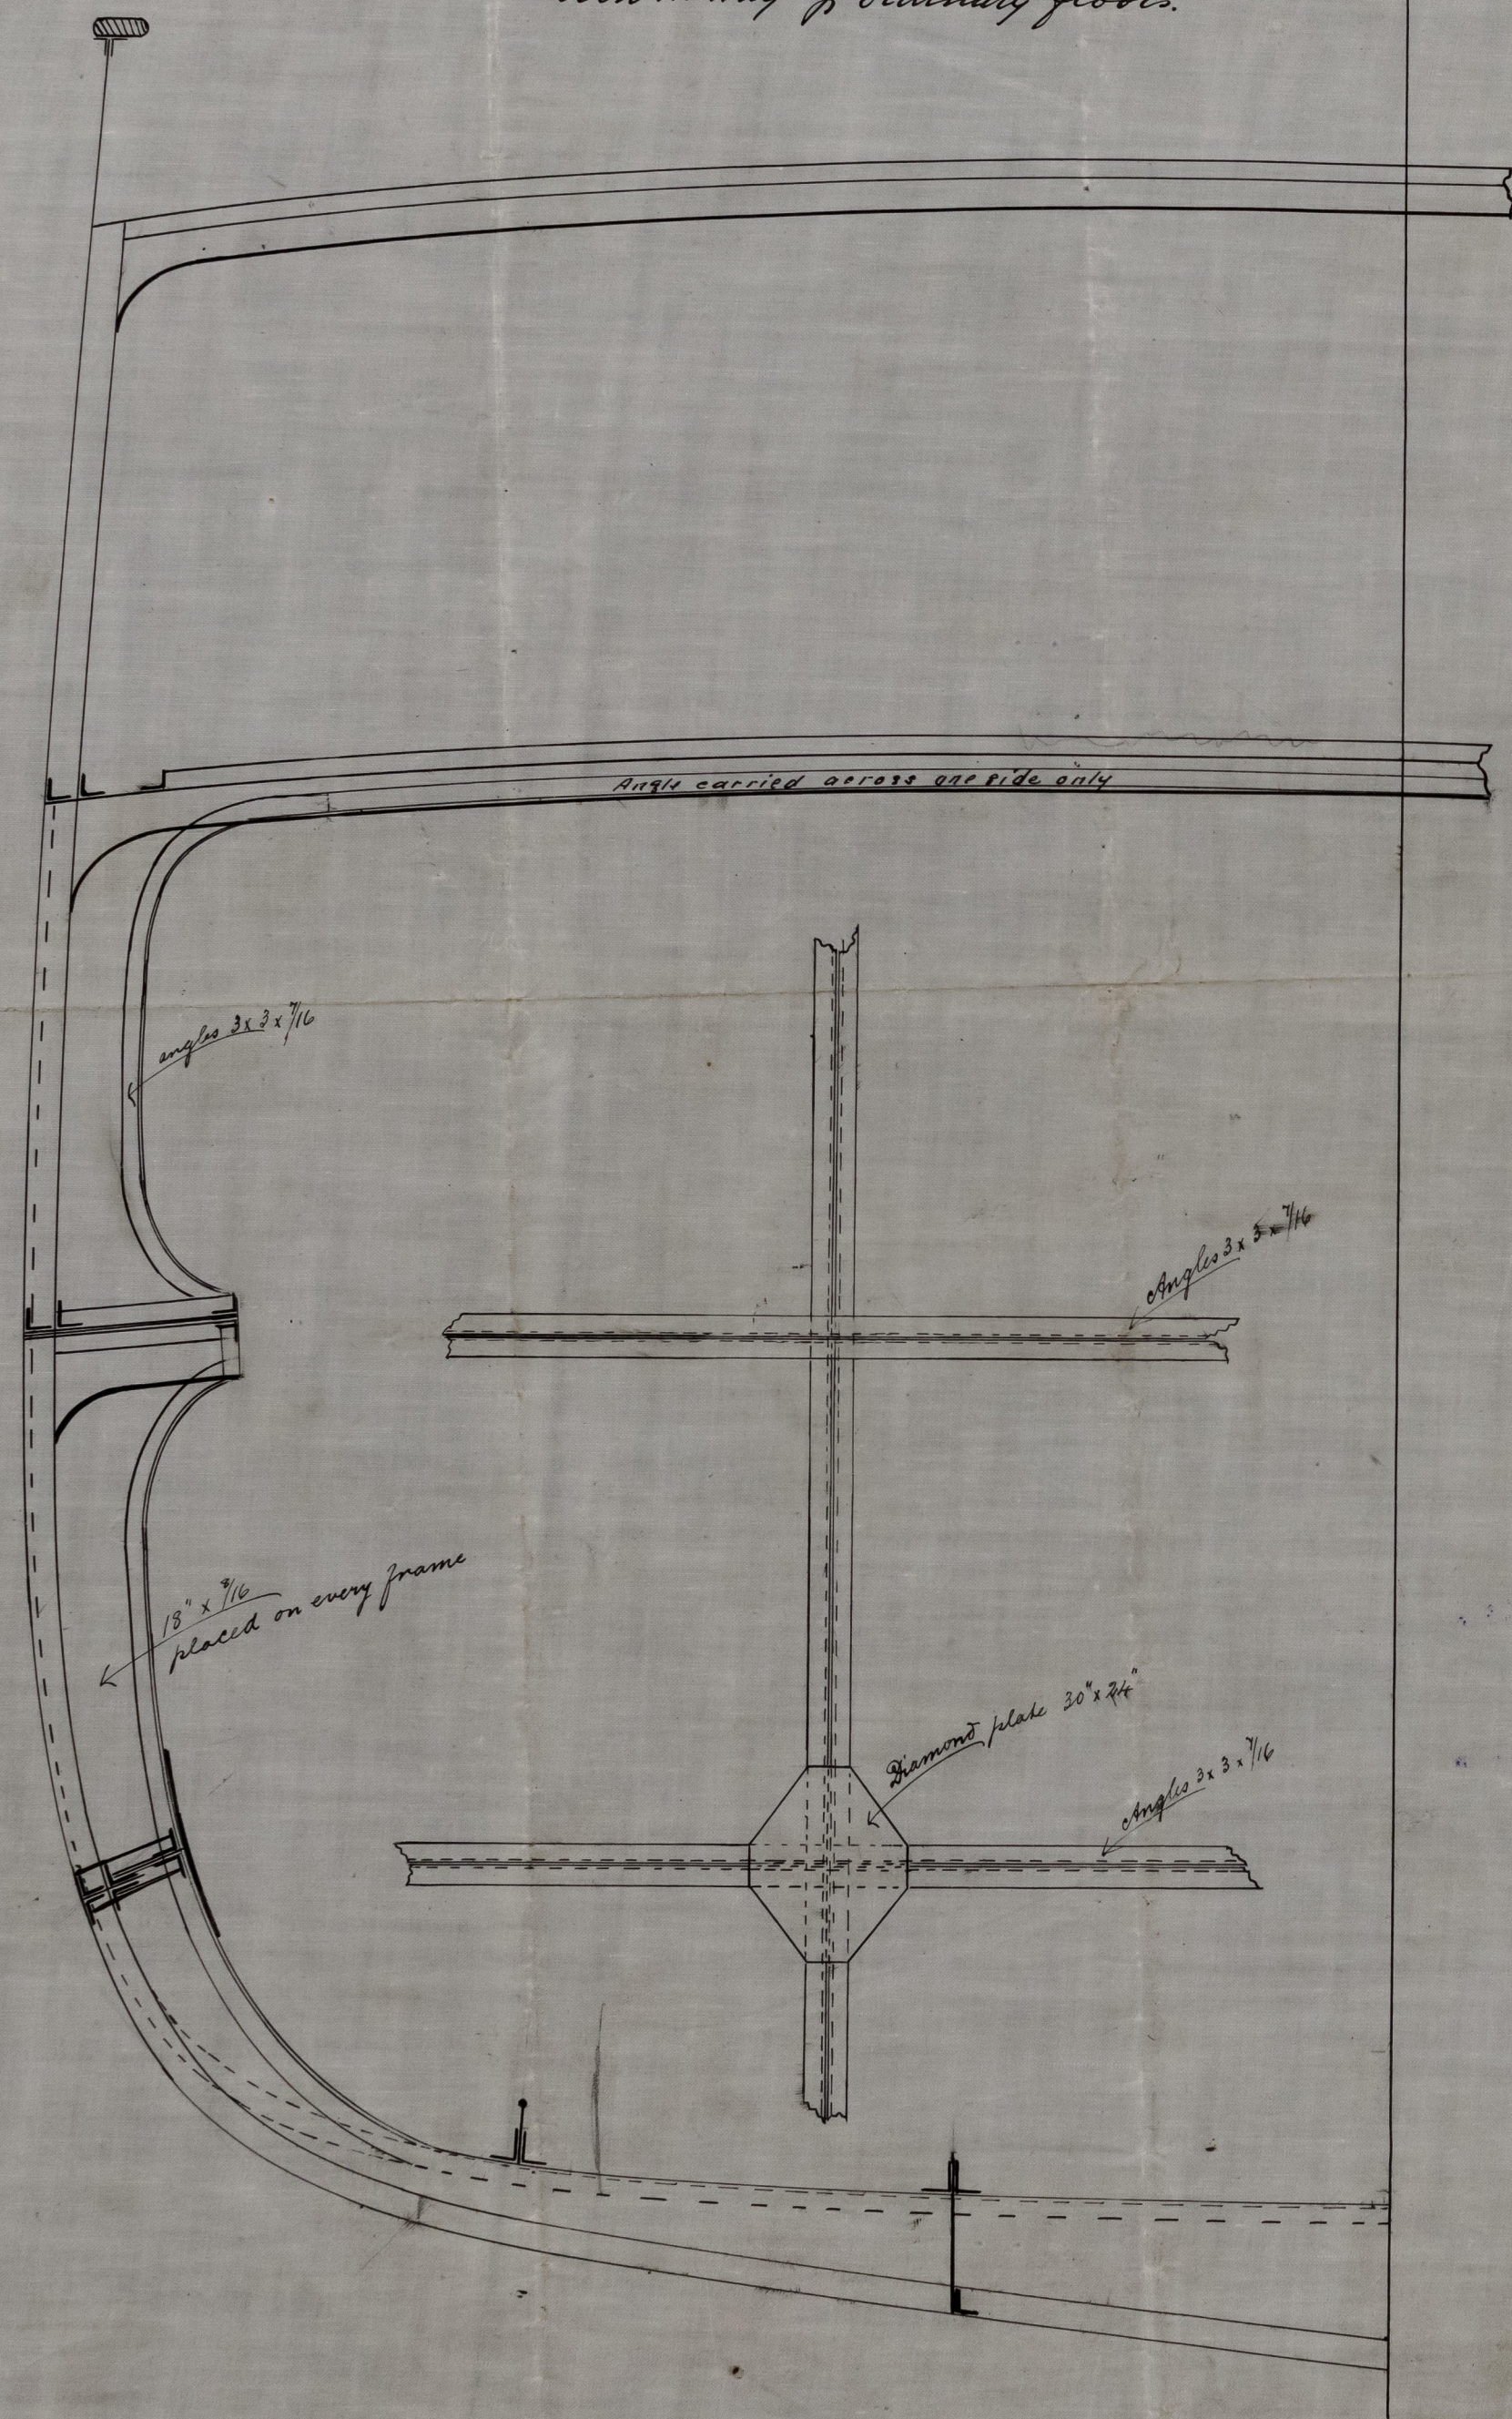

Section in way of Tank

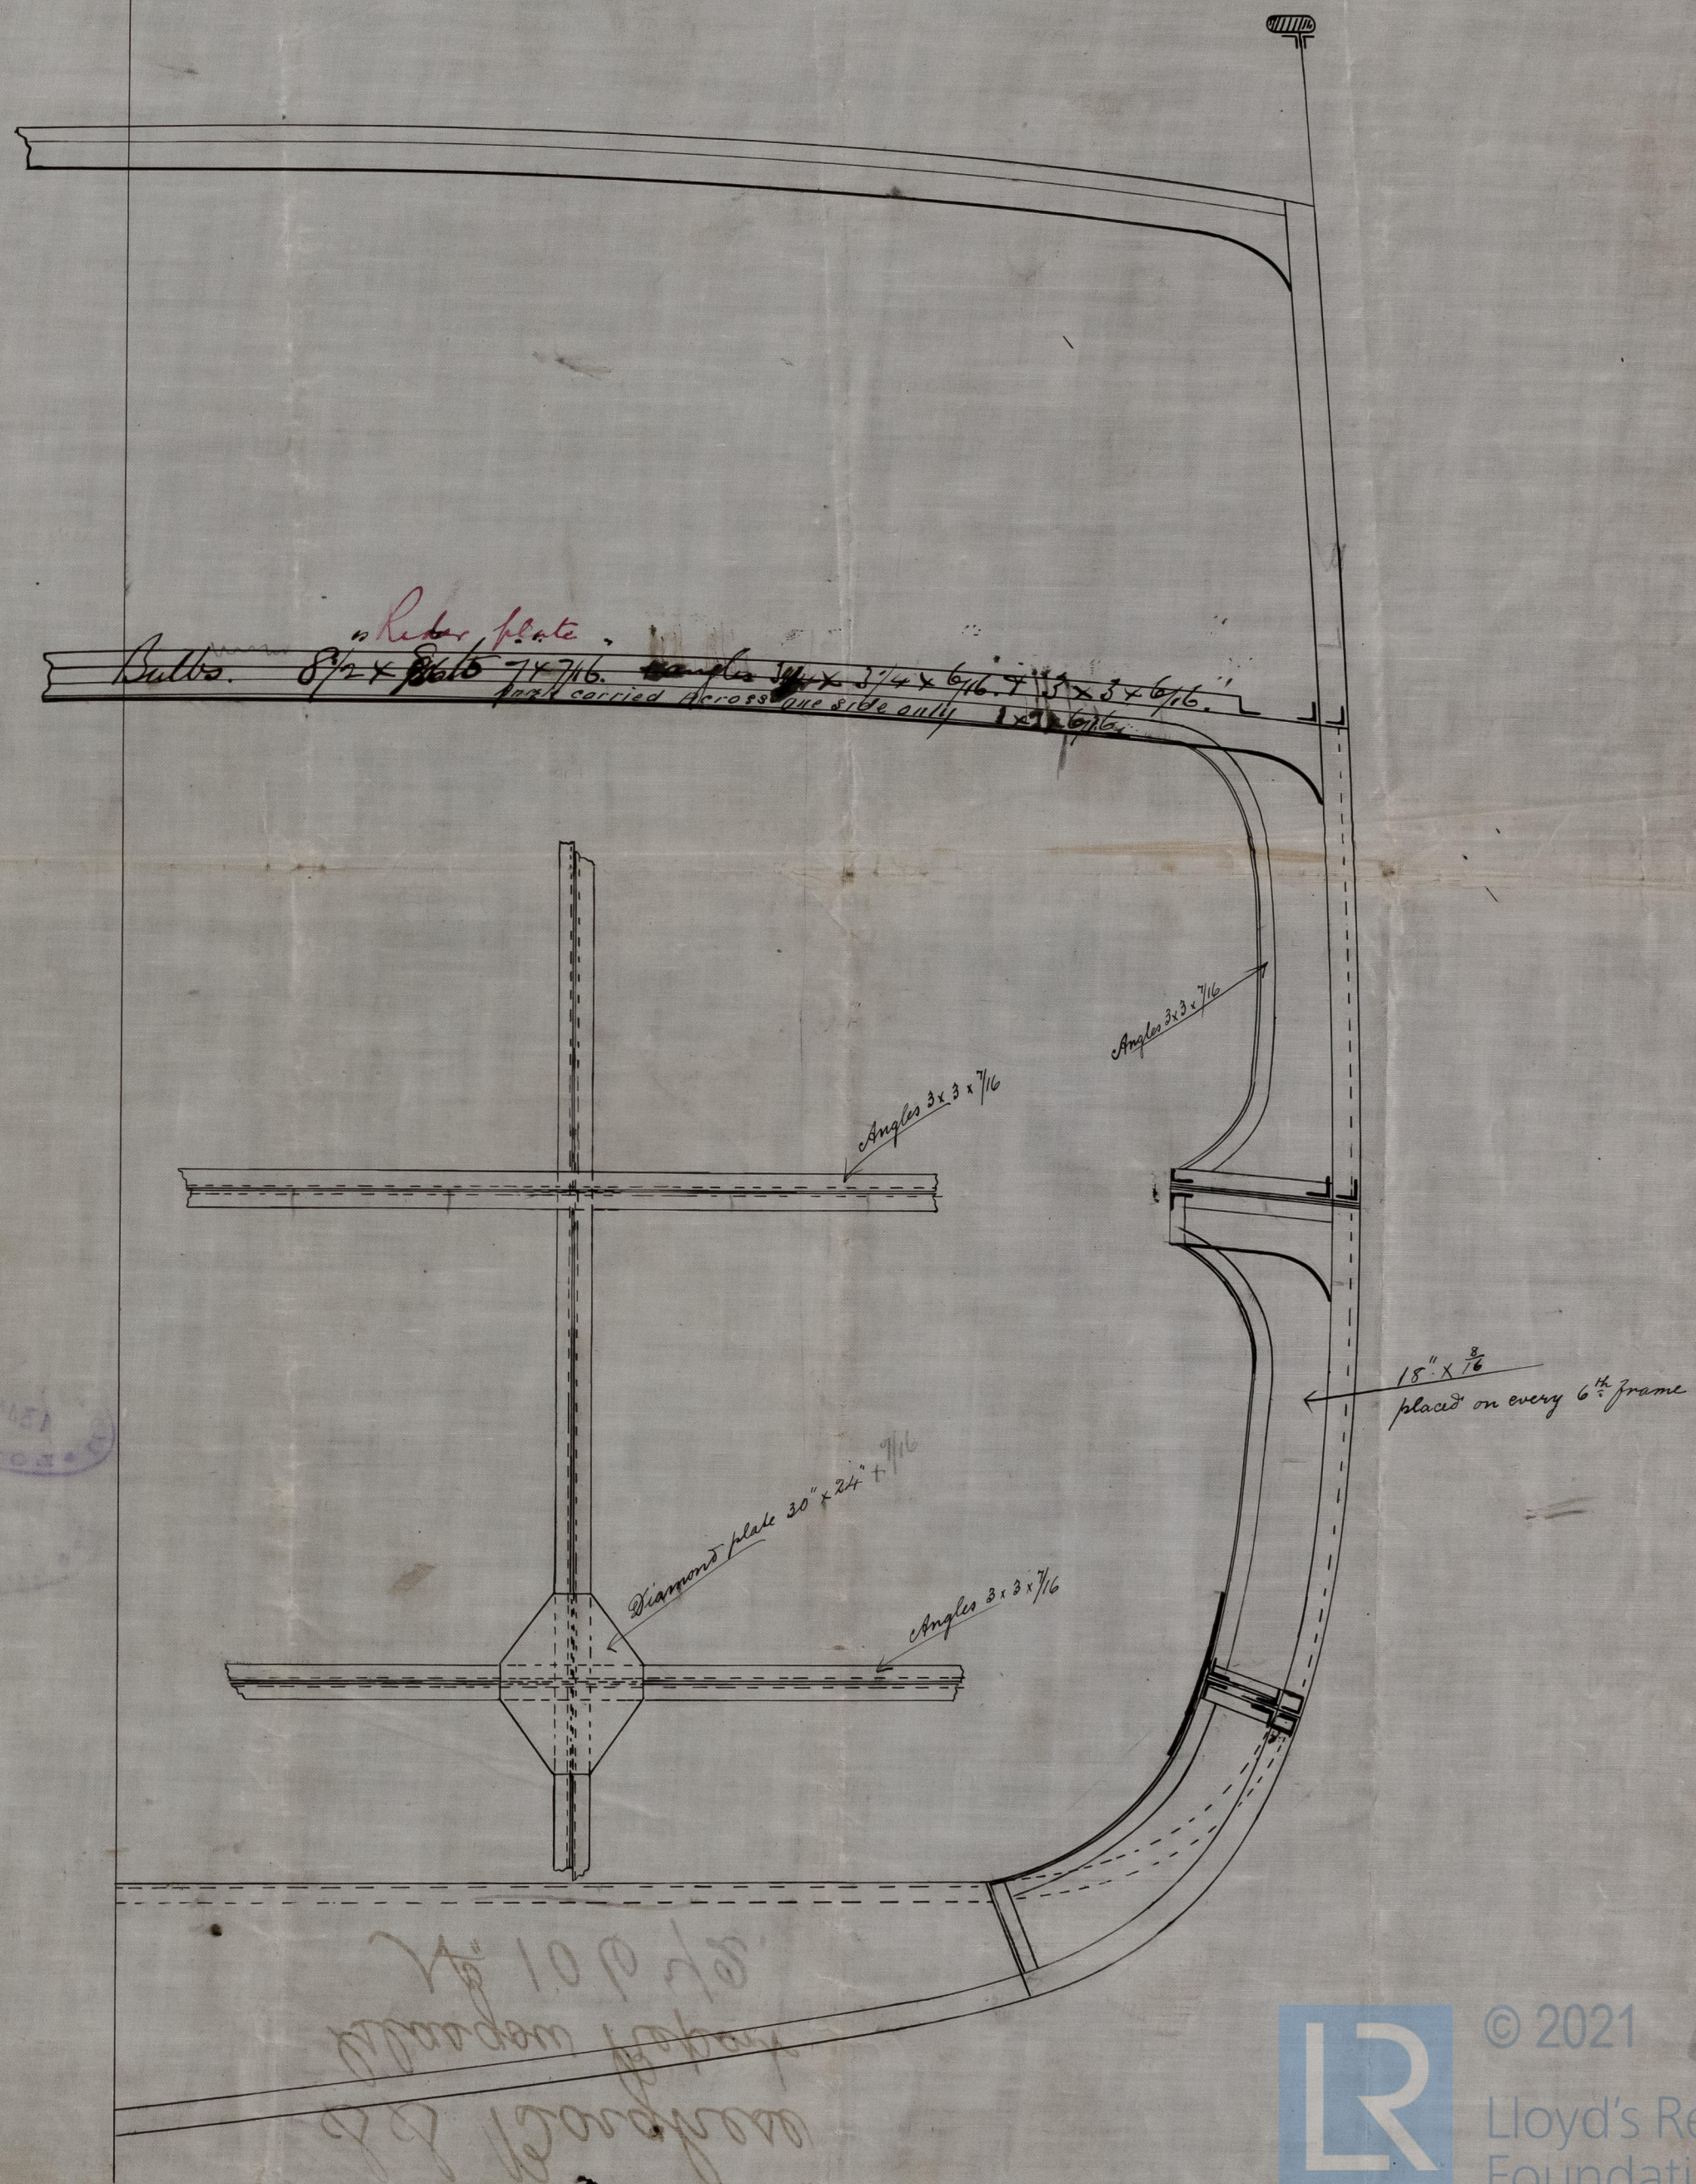

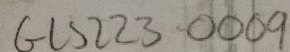

Lloyd's Register
Foundation