


 10/20 - 10/20 - 10/20

THU 4 SEP 90

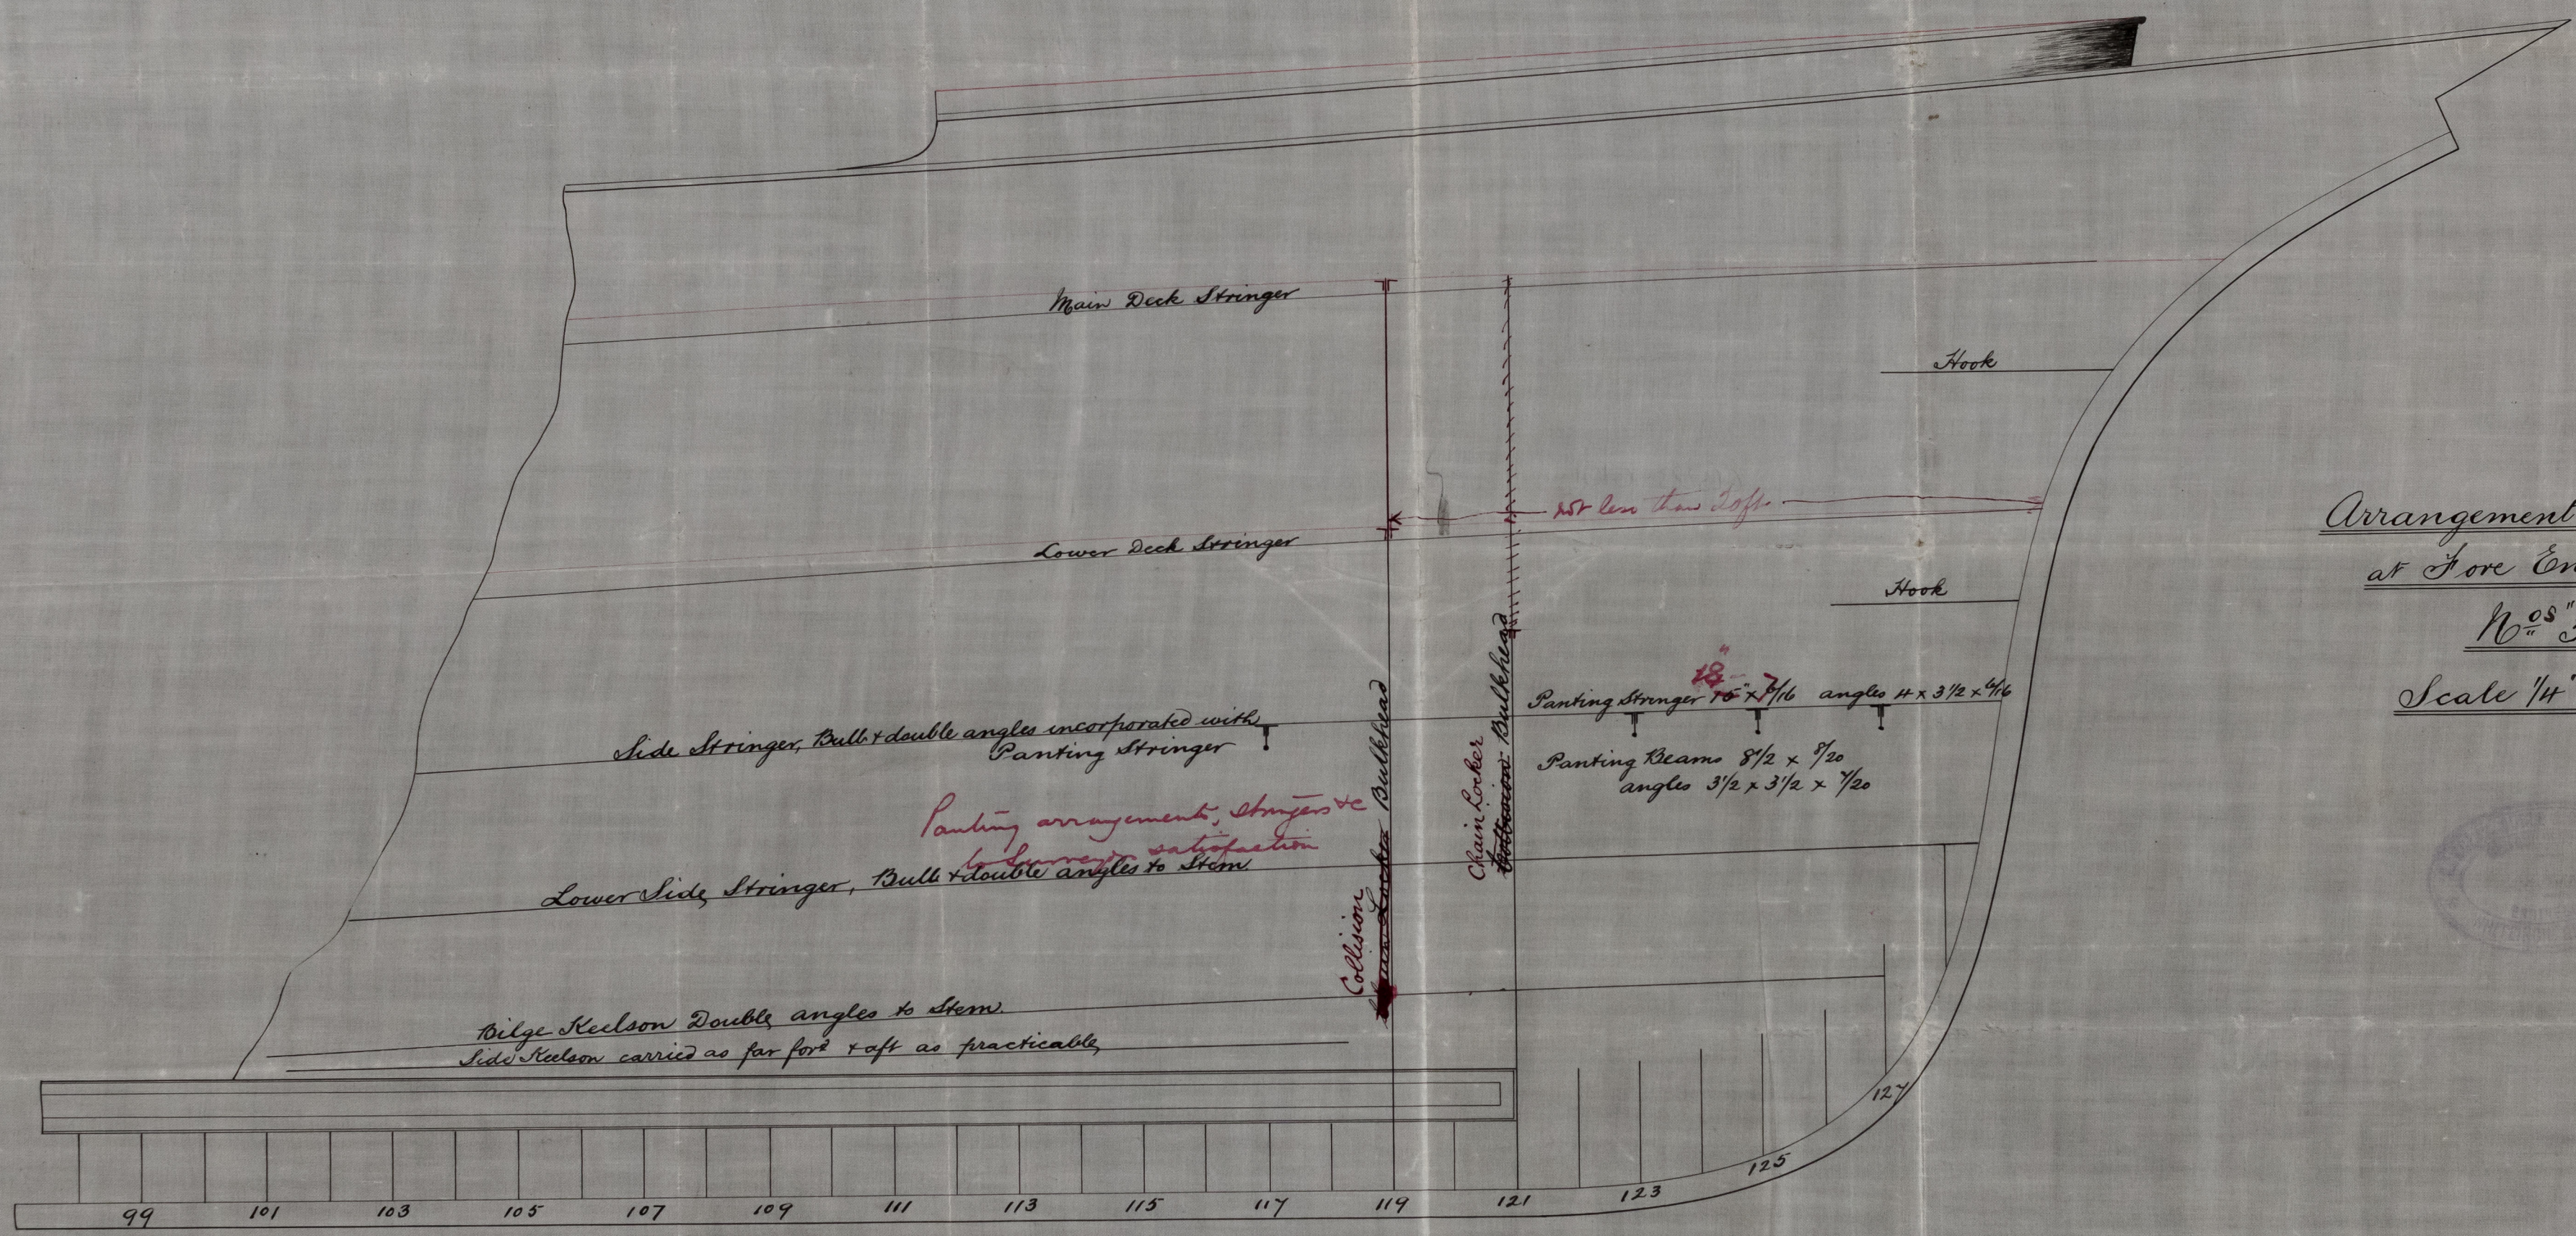

Arrangement of Keelsons &c  
 at Fore End of Ship.  
 No. 368 & 369  
 Scale 1/4" = 1 Foot.



Ship "Mount Stewart" Glasgow Report No 10645.-  
" Cromdale " — do — " 10456.-

Arrangement of Section &c



© 2021

Lloyd's Register  
Foundation