


MON 10 NOV 90

Amended
Main Deck Plan shewing arrangement of Diagonals &c.
For Ship No 368-9.
Scale $\frac{1}{8}$ " = 1 foot.

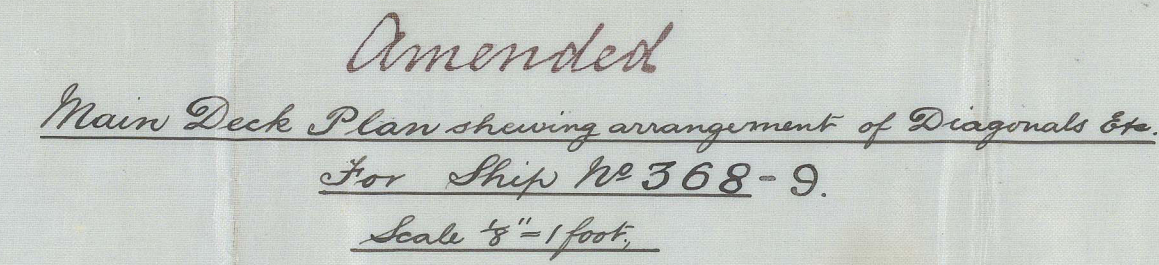


J. L.
Dec. 4. 11. 90

90 LR © 2021
Lloyd's Register
Foundation

NOV 10 1890

Ship "Mount Stewart" Glasgow Report No 10645.-
" Cromdale " do " 10456.-

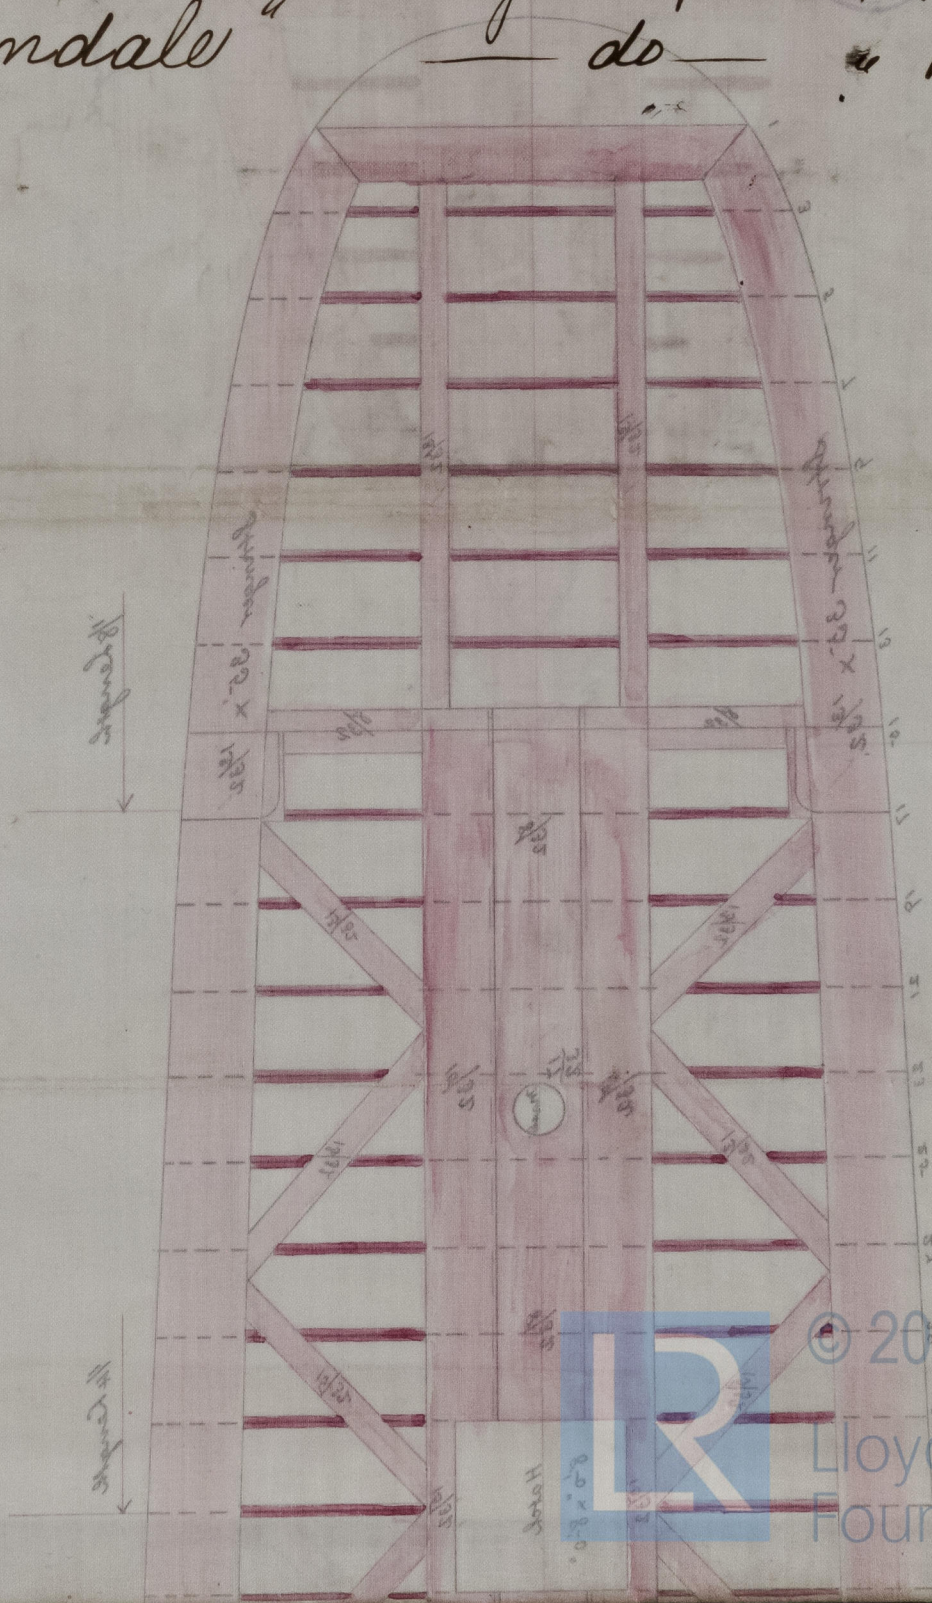

© 2021

Lloyd's Register
Foundation

615223-0103