

Lloyd's Register of British and Foreign Shipping.

(Report on Vessel No. *10456* Port *Glasgow*)*Ship "Gromdale."*No. *2919*SHIP FORGINGS ~~OR CASTINGS~~I have to report that the undermentioned Iron ~~or Steel~~ Forgings ~~or Castings~~, manufactured by*Messrs Barclay Curle & Co* of *Glasgow*
for the Vessel No. *1369*, being built by *Them*of _____ have been inspected by me as set forth below, and found
to be, so far as can be seen, *Sound & efficient*

Mark on Forgings.

Lloyd's


No. *2919*

W.H.

*William Hamilton**Glasgow*
1/5/91

	STERN FRAME.	RUDDER FRAME.	STEM.
Material* - - - -	/	<i>Scrap iron</i>	/
How made - - - -		<i>Forged</i>	
Dimensions - - - -		<i>7 to 3½</i>	
Progress on Inspection -		<i>Forging & smithing</i>	
Dates when Inspected		<i>26/3/91. 4. 9. 15. 21. 27. 30/4/91</i>	

SKETCHES OF FRAMES SHEWING POSITION AND DESCRIPTION OF WELDS OF FORGINGS, OR PARTICULARS OF TESTS APPLIED TO CASTINGS.

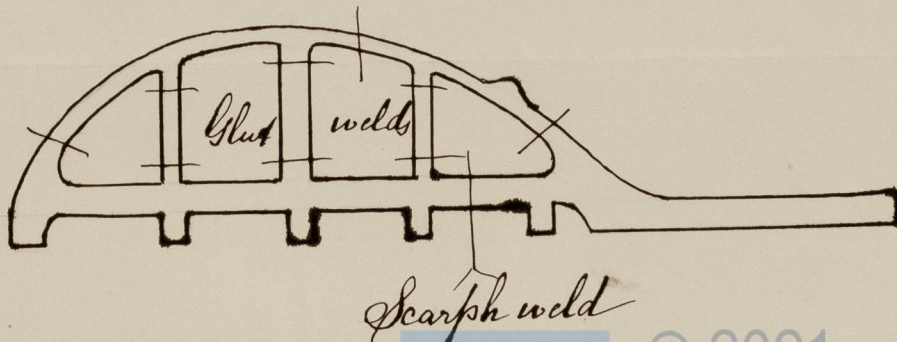

© 2021

Lloyd's Register
Foundation