


1.5.91.

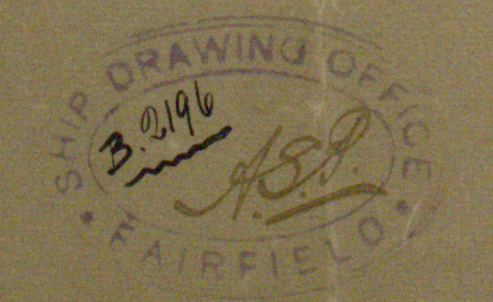

L.L. "Hawarden Castle".
 Profile showing Watertight Bulkheads.
 Scale 1/4" = 1'.



Proposed 1/4" Watertight Bulkhead.
 Room for Docking
 Water.
 1/4" Bulkhead to be removed to side.
 1/4" Bulkhead to be removed to side.
 1/4" Bulkhead to be removed to side.

✓ Here web frames were not fitted, as some of the
 lower deck beams were removed.
 * a portion of this bulkhead is left at the side of the
 web forming a web frame



William L. Sharpe


S. S. Hawarden Castle

Glasgow Report

No 10810.

GL5223-0204

18.7.1

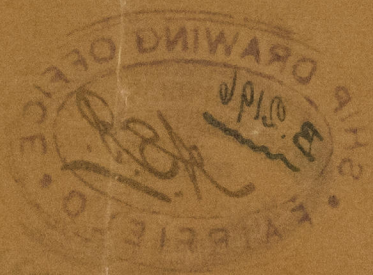

© 2021

Lloyd's Register
Foundation