

Lloyd's Register of British and Foreign Shipping.

(Report on Vessel No. 10912 Port Glasgow
S. S. "Picheer".)No. 3094 SHIP FORGINGS ~~OR CASTINGS.~~

The words FORGINGS or CASTINGS, IRON or STEEL, should be struck out as may be required.

I have to report that the undermentioned Iron ~~or Steel~~ Forgings ~~or Castings~~, manufactuerd by
Messrs. Wm. Denny & Bros. of Dumbarton
 for the Vessel No. 456, being built by Messrs. Wm. Denny & Bros.
 of Dumbarton have been inspected by me as set forth below, and found
 to be, so far as can be seen, Sound & efficient.

Mark on Forgings.


Lloyd's
 No. 3094
FC

Frank Cook.

Glasgow,
2/7/91

	STERN FRAME.	RUDDER FRAME.	STEM.
Material* - - - -	/	Scrap Iron.	/
How made - - - -		Forged.	
Dimensions - - - -		4" to 2 1/4" dia	
Progress on Inspection -		Forging & Smithing	
Dates when Inspected		14/16.21/4/91.19/5/91.23/6/91. 2/7/91.	

SKETCHES OF FRAMES SHEWING POSITION AND DESCRIPTION OF WELDS OF FORGINGS, OR PARTICULARS OF TESTS
 APPLIED TO CASTINGS.

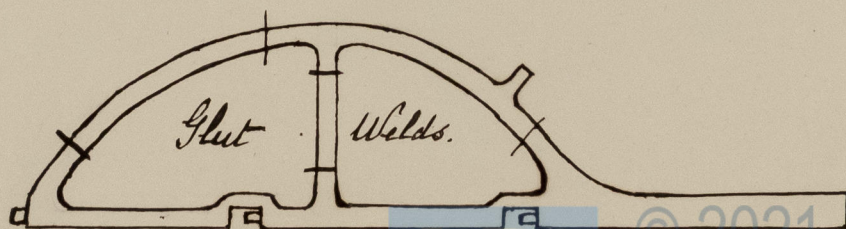

* If of Iron, state whether scrap or puddled Iron.