


PUMPING ARRANGEMENT


S. S. Nos. 456 & 457

SCALE 1/4" INCH = 1 FOOT

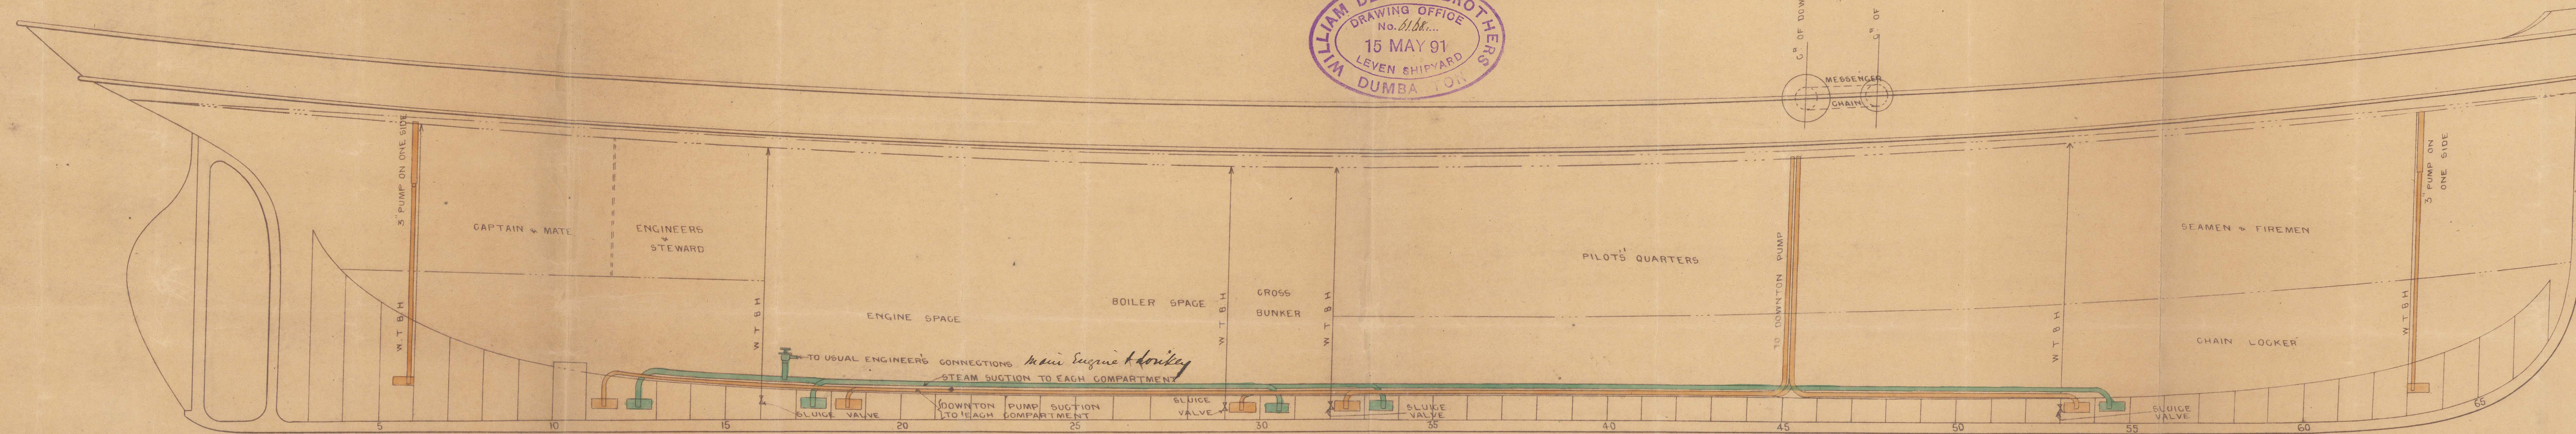

also Pulge system & separate donkey system

*J. M.
27/5/91*

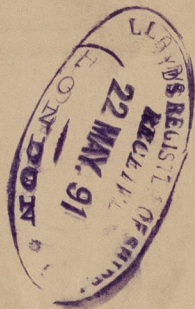

S.S. "Pioneer" Glasgow Report A^o 10912.-
S.S. Guide ——— " ——— 10962.-



© 2021

Lloyd's Register
Foundation

GLS224-0186