


16.3.91
2.4.91.

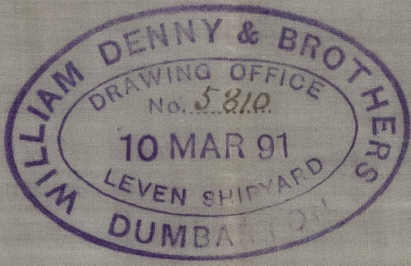


MIDSHIP SECTION S.S. N^{OS} 456 & 457 DIMENSIONS 114' x 21' x 12'3" MLD.

TO CLASS 100 A.I. AT LLOYDS.

SCALE 1/4" = 1 FOOT

TO BE BUILT OF STEEL

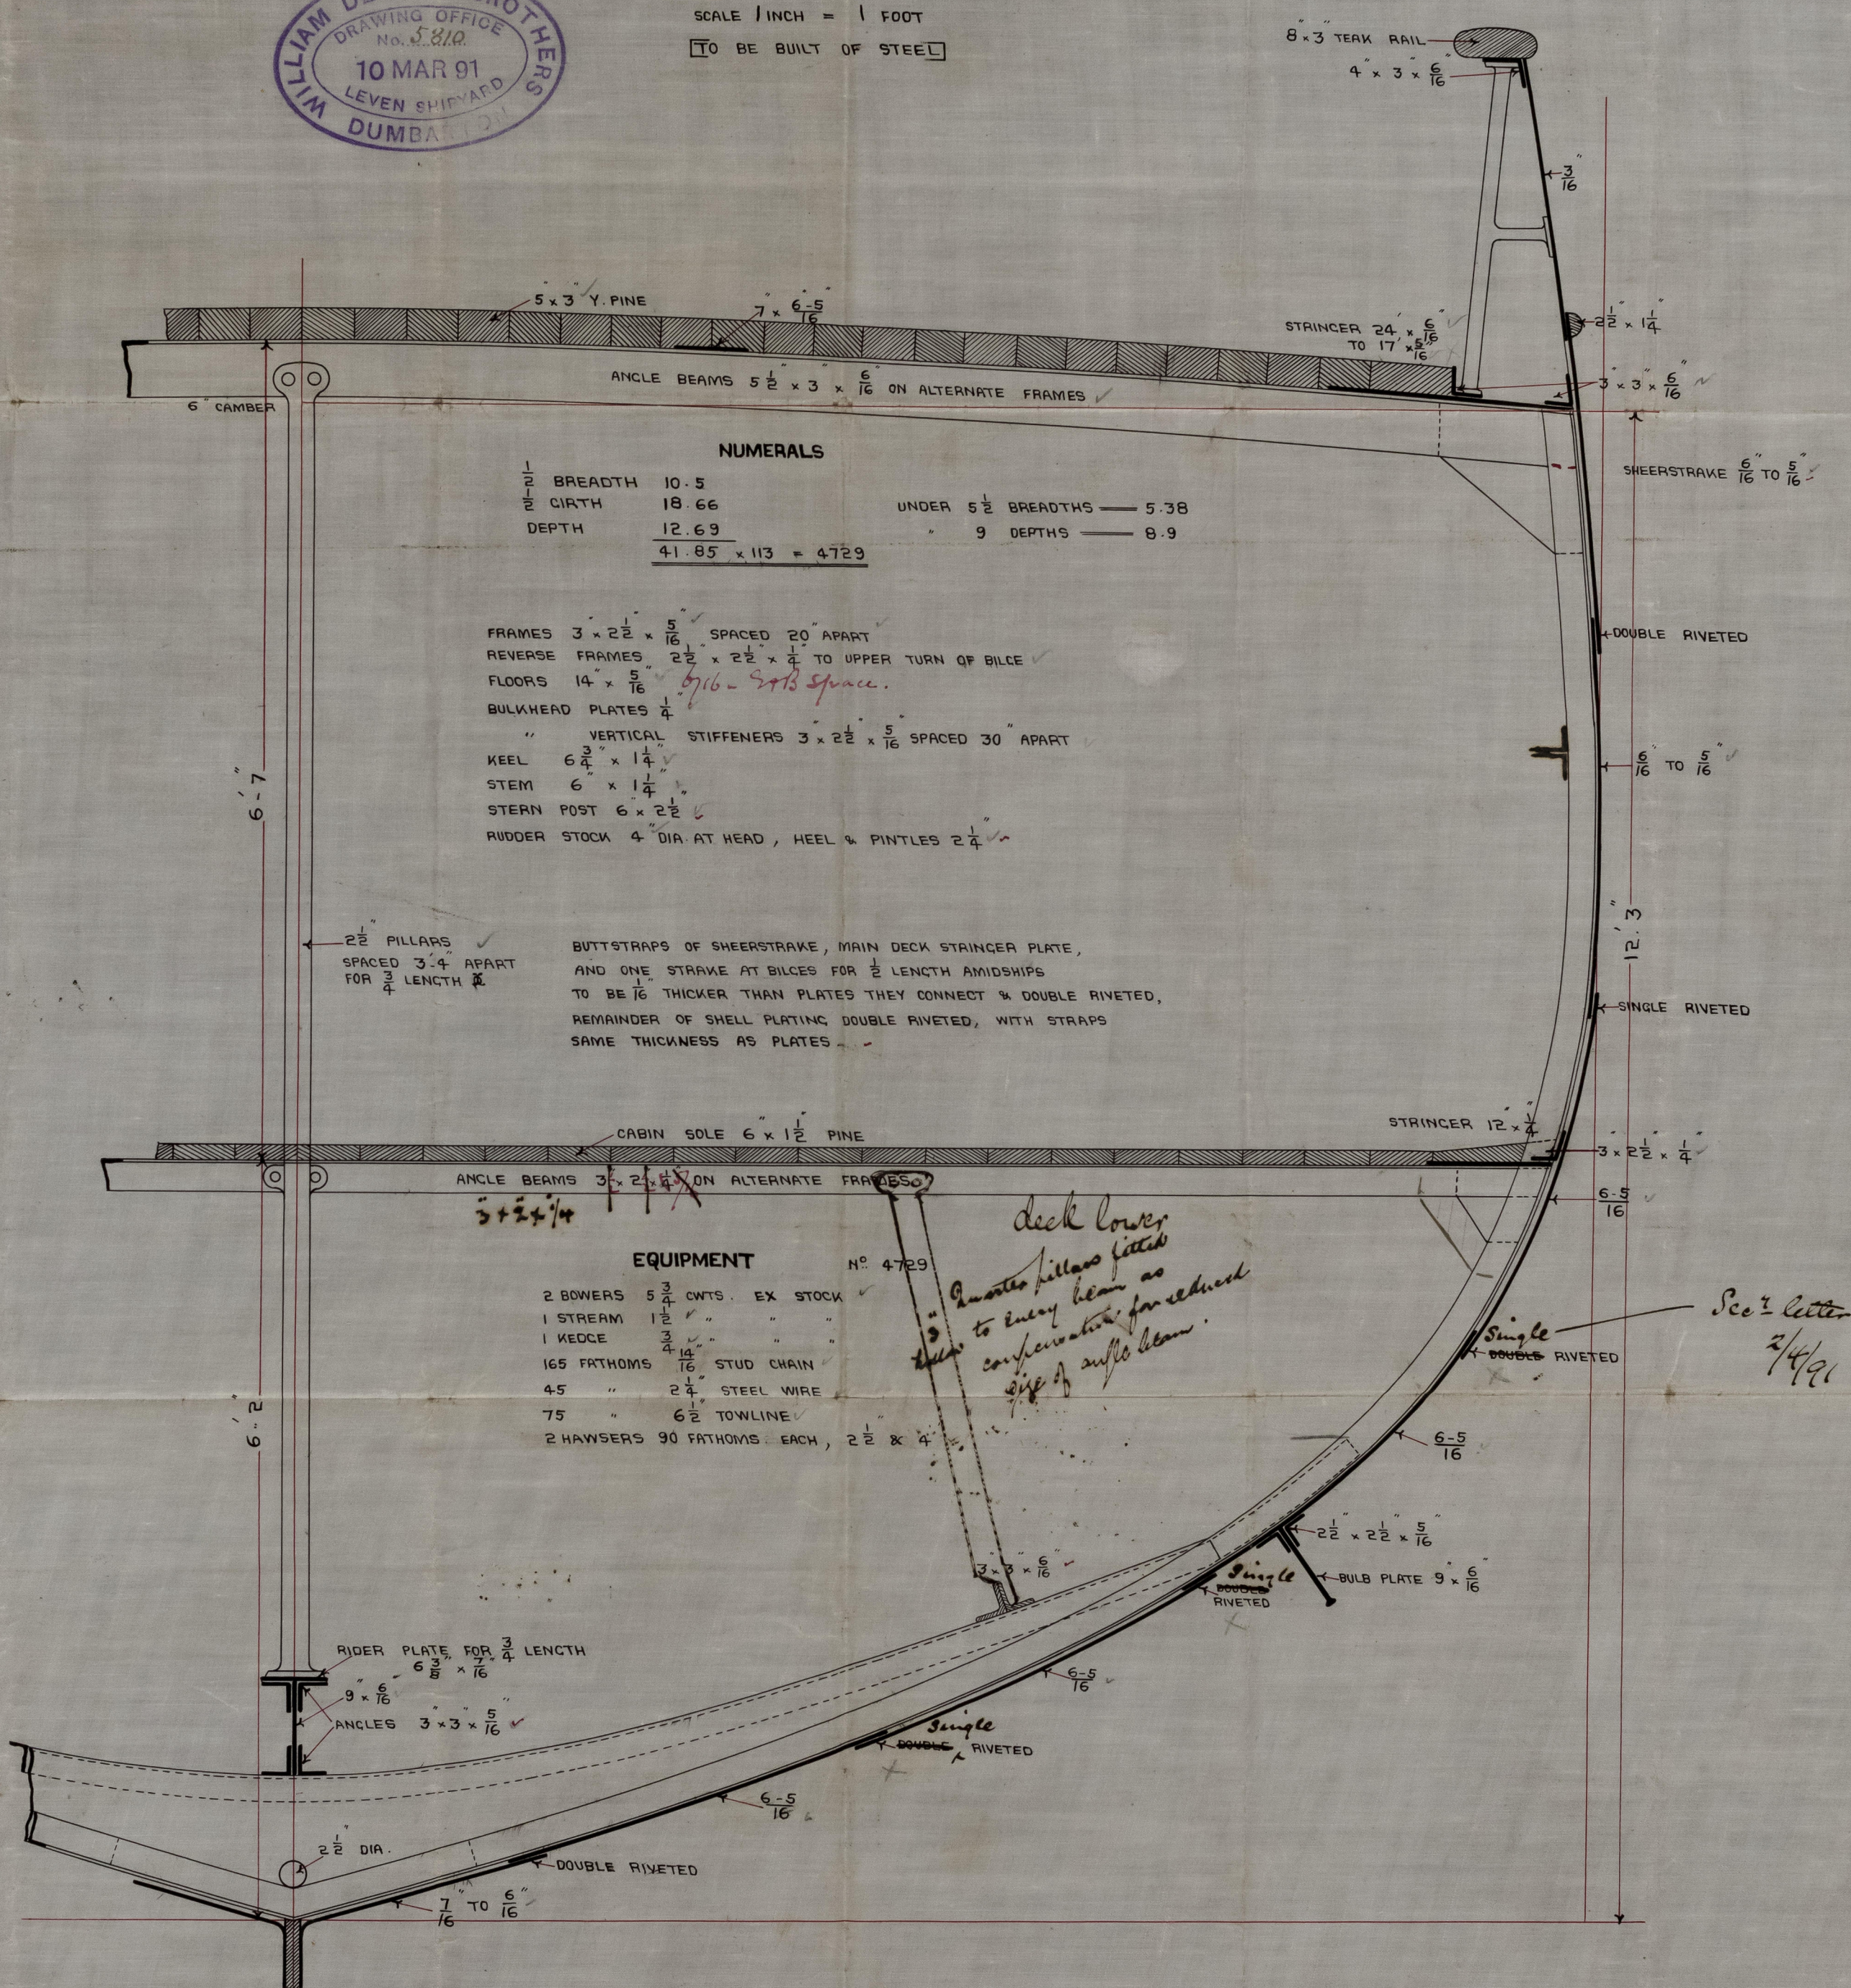

18m
14/3/91

S. S. "Pioneer" Glasgow Report No. 10912.



*12.5
12.5
12.5
12.5*



DIMENSIONS
TO BE BUILT
SCALE 1 INCH =
TO CLASS 100 A

22 Nos 42

WIDESHIP

© 2021

Lloyd's Register
Foundation

665224-0188

12 65 TOWLINE