

# Lloyd's Register of British and Foreign Shipping.

(Report on Vessel No. 10962 Port Glasgow)

S.S. Guide.

## No. 3095 SHIP FORGINGS ~~OR CASTINGS.~~

The words FORGINGS or CASTINGS, IRON or STEEL, should be struck out as may be required.

I have to report that the undermentioned ~~Iron or Steel Forgings or Castings~~, manufactuerd by Messrs William Denny & Bros of Dumbarton for the Vessel No. 457, being built by Them of \_\_\_\_\_ have been inspected by me as set forth below, and found to be, so far as can be seen, Sound & efficient

Mark on Forgings.

Lloyd's

No. 3095

W.H.



William Hamilton

Glasgow

12/8/91

|                          | STERN FRAME. | RUDDER FRAME.   | STEM. |
|--------------------------|--------------|---|-------|
| Material* - - - -        |              | <u>Scrap steel</u>                                      |       |
| How made - - - -         |              | <u>Forged</u>   |       |
| Dimensions - - - -       |              | <u>14 dia</u>   |       |
| Progress on Inspection - |              | <u>Forging &amp; smithing</u>                           |       |
| Dates when Inspected     |              | <u>9.12.12, 29/6/91, 2. 6/7/91</u><br><u>3. 11/8/91</u> |       |

SKETCHES OF FRAMES SHEWING POSITION AND DESCRIPTION OF WELDS OF FORGINGS, OR PARTICULARS OF TESTS APPLIED TO CASTINGS.

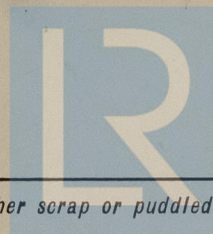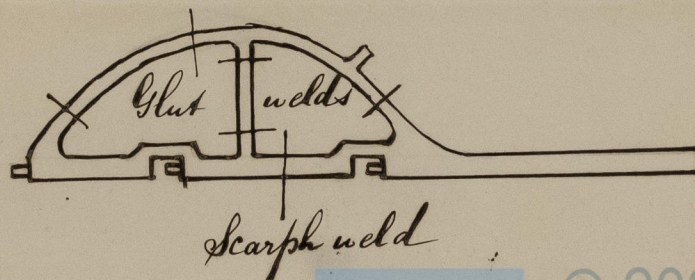

© 2021

Lloyd's Register  
Foundation