


6/4/91.

67252-0031

— STEEL SAILING BARQUE —

— N° 3365 —

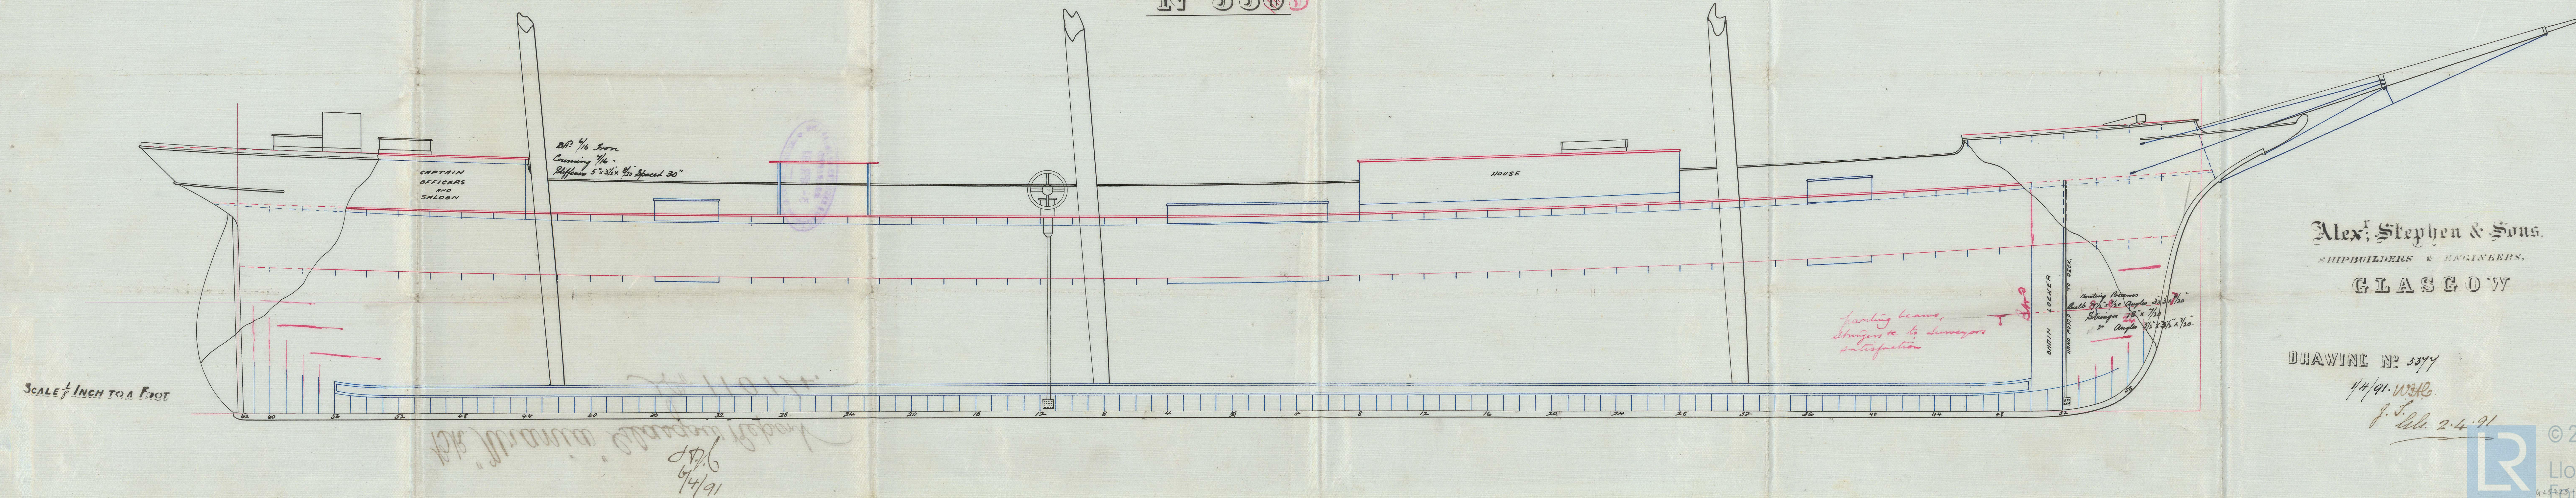


Alex. Stephen & Sons.
SHIPBUILDERS & ENGINEERS.
GLASGOW

DRAWING N° 5377
1/4/91. W.H.C.
J. L. 2.4.91

2/2/01
24/0

24700N
240
OFFICERS
WILLIAM

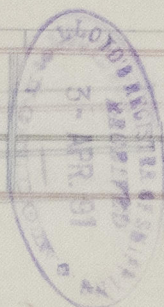

Lloyd's Register
Foundation

GLS225-0031