

Lloyd's Register of British and Foreign Shipping.

(Report on Vessel No. 11014 Port Glasgow
Bk. "Urania".)No. 3159 SHIP FORGINGS ~~OR CASTINGS.~~

The words FORGINGS or CASTINGS, IRON or STEEL, should be struck out as may be required.

I have to report that the undermentioned Iron ~~or Steel~~ Forgings ~~or Castings~~, manufactuerd by
Messrs Alex^r & Stephen & Sons of Glasgow
 for the Vessel No. 335, being built by Them
 of _____ have been inspected by me as set forth below, and found
 to be, so far as can be seen, Sound & efficient

Mark on Forgings.

Lloyd's


No. 3159

W. H.

William HamiltonGlasgow
7/8/91

	STERN FRAME.	RUDDER FRAME.	STEM.
Material* - - - -	/	Scrap iron	/
How made - - - -		Forged	
Dimensions - - - -		6 3/4 to 3 1/2	
Progress on Inspection -		Forging & smithing	
Dates when Inspected {		13/21. 6/27/91. 8/6/91. 8/7/91 6/8/91	

SKETCHES OF FRAMES SHEWING POSITION AND DESCRIPTION OF WELDS OF FORGINGS, OR PARTICULARS OF TESTS
 APPLIED TO CASTINGS.

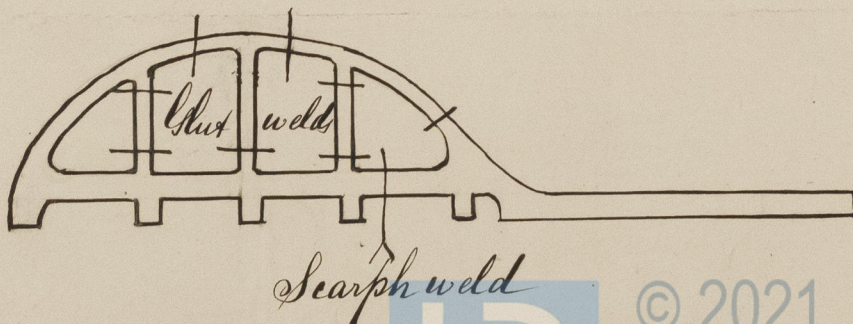

© 2021

Lloyd's Register
Foundation