

Lloyd's Register of British and Foreign Shipping.

(Report on Vessel No. 11014 Port Glasgow
Bk. "Urania")

No. 3159 SHIP FORGINGS ~~OR CASTINGS~~.

The words FORGINGS or CASTINGS, IRON or STEEL, should be struck out as may be required.

I have to report that the undermentioned Iron ~~or Steel~~ Forgings ~~or Castings~~, manufactured by Messrs Alex^d Stephen & Sons of Glasgow for the Vessel No. 335, being built by Them of _____ have been inspected by me as set forth below, and found to be, so far as can be seen, Sound & efficient



Mark on Forgings.

Lloyd's
No. 3159
W.H.

William Hamilton
Glasgow

	STERN FRAME.	RUDDER FRAME.	STEM. & Keel bars
Material*	<u>Scrap iron</u>	/	<u>Scrap iron</u>
How made	<u>Forged</u>		<u>Forged</u>
Dimensions	<u>7 1/2 x 3</u>		<u>9 x 2 1/2 to 9 1/2 x 2 1/2</u>
Progress on Inspection	<u>Forging & Smithing</u>		<u>Forging</u>
Dates when Inspected	<u>27/4/91. 4. 7. 11/5/91</u>		<u>20. 27/4/91. 4. 7. 11. 13. 21/5/91</u> <u>8/6/91</u>

SKETCHES OF FRAMES SHEWING POSITION AND DESCRIPTION OF WELDS OF FORGINGS, OR PARTICULARS OF TESTS APPLIED TO CASTINGS.

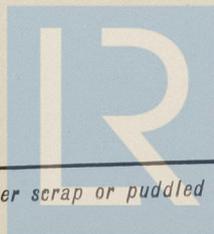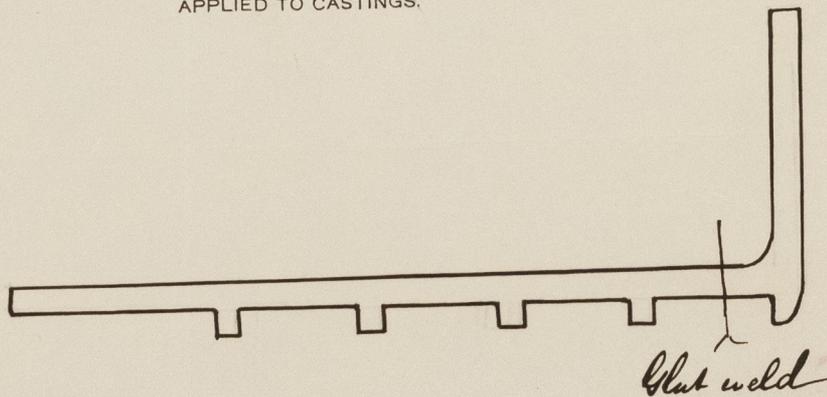

© 2021

Lloyd's Register
Foundation