


"Hood" modified
 Glasgow Harbor
 11/10/91


— 11° 358 —
 — Profile Showing Alterations Made in S.S. Northway Castle —
 — Scale 1/8 inch = one foot —

6/10/91

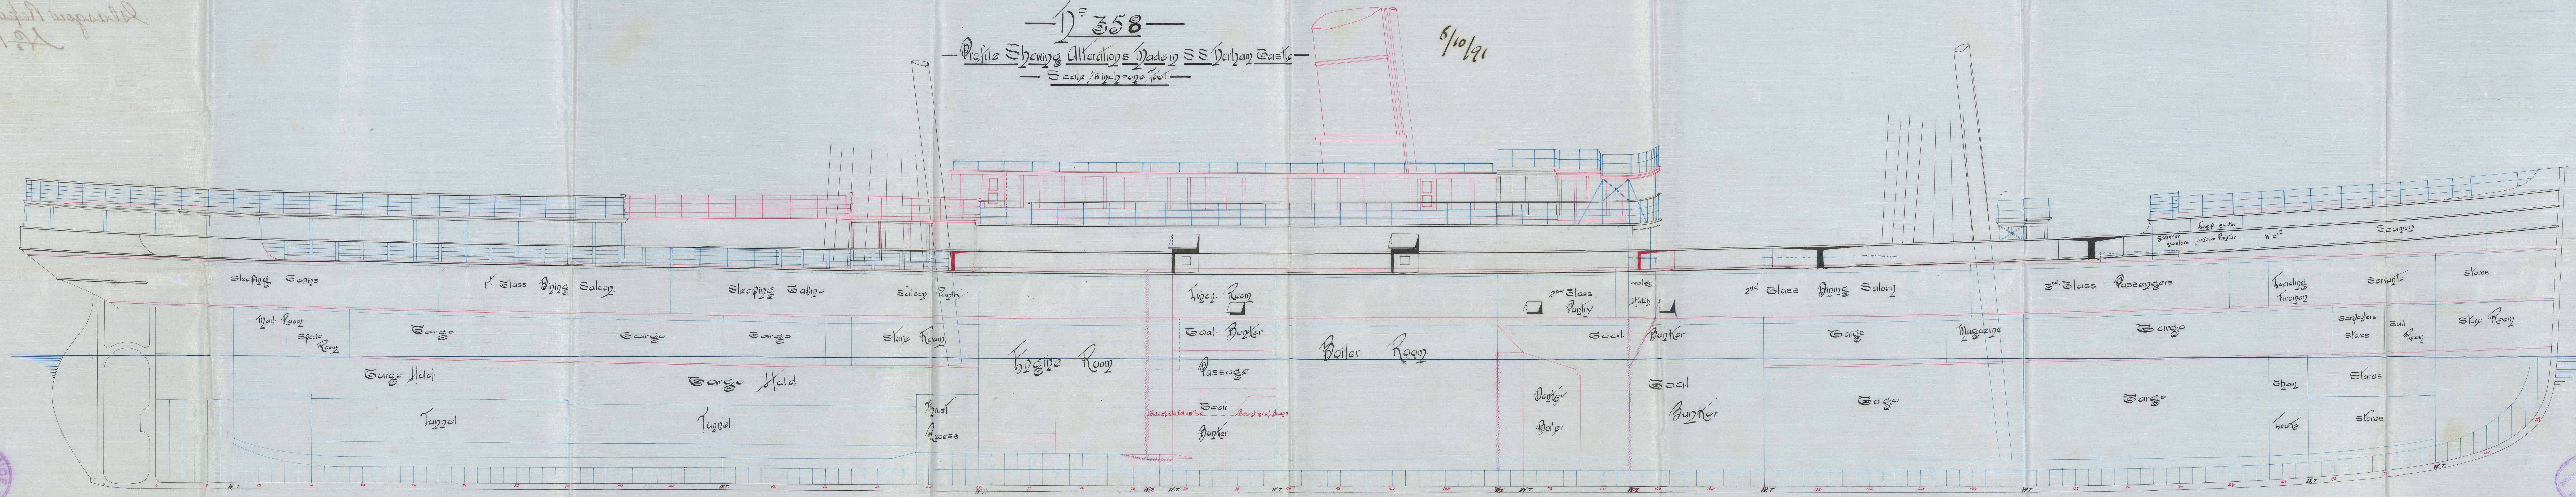

J. Hume
 6/10/91

S.S. "Norham Castle"
Glasgow Report
No 11015. —

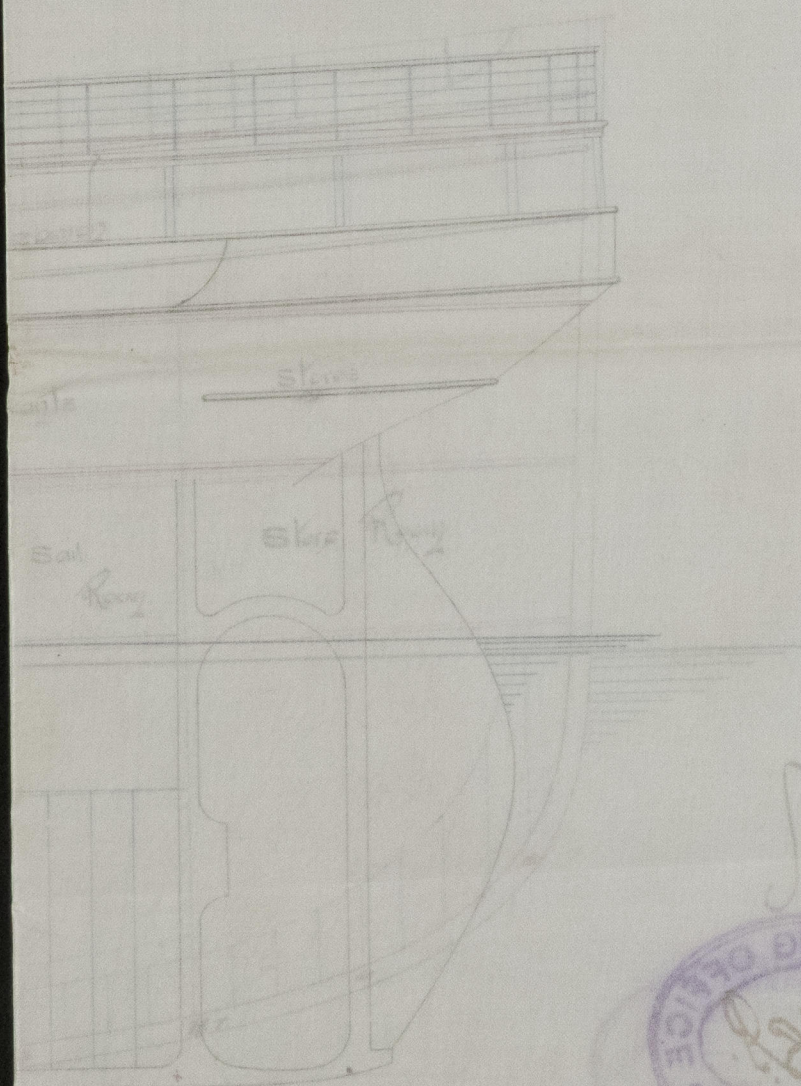

J. Shearke
6/10/91



© 2021

Lloyd's Register
Foundation

GLS225-0040