

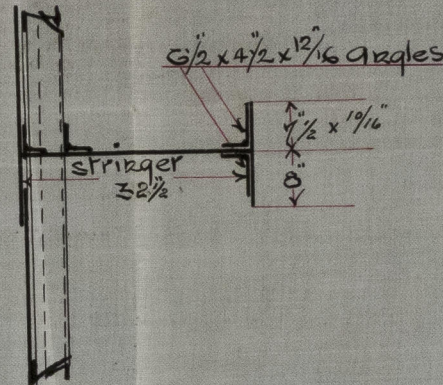


Section of L.D. Stringer in way of Boiler showing compensation
"Warwick Castle" supplied on account of reduction
 in breadth of stringer.

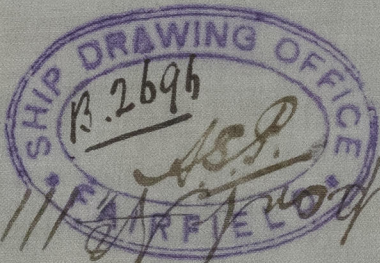

Section of L.D. Stringer
before alterations

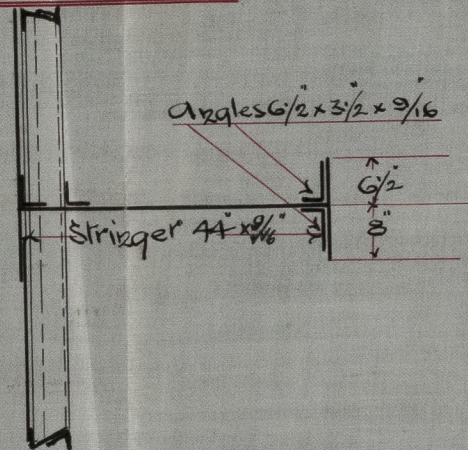

*J.S. Warwick Castle
 Glasgow Report No. 1116/4-*



© 2021

Lloyd's Register
 Foundation

GLS226 0029