

Lloyd's Register of British and Foreign Shipping.

(Report on Vessel No. 11144 Port Glasgow
"Ruahine"—)No. 3098SHIP FORGINGS OR CASTINGS.

The words FORGINGS or CASTINGS, IRON or STEEL, should be struck out as may be required.

I have to report that the undermentioned ~~Iron or Steel Forgings or Castings~~, manufactured by

The Kinnystown Forge Co. of Kumbarton,
for the Vessel No. 458, being built by Messrs. William Kenny & Bros.
of Kumbarton, have been inspected by me as set forth below, and found
to be, so far as can be seen, Sound,

Mark on Forgings.

Lloyd's

No. 3098
FC


Frank Cook.

Glasgow.

6/10/91

	STERN FRAME.	RUDDER FRAME.	STEM.
Material* - - - -	/	Scrap Steel	/
How made - - - -		Forged.	
Dimensions - - - -		10 1/2 in	
Progress on Inspection -		Forging & Smithing	
Dates when Inspected		24.9.12/6/91.10.30/7/91.11 17.26.31/8/91.	

SKETCHES OF FRAMES SHEWING POSITION AND DESCRIPTION OF WELDS OF FORGINGS, OR PARTICULARS OF TESTS APPLIED TO CASTINGS.

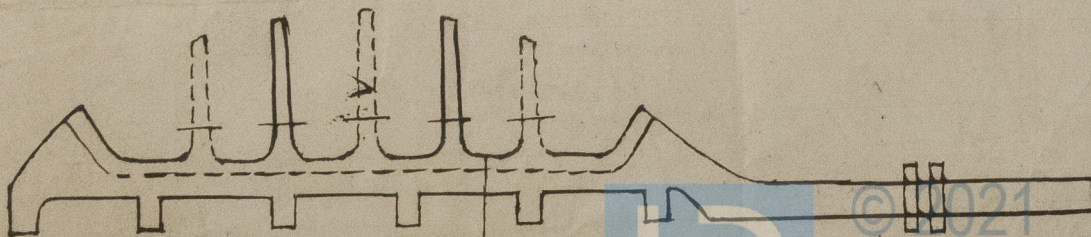

Scarf Welds.

* If of Iron, state whether scrap or puddled Iron.