




12.3.91

 

PLAN SHOWING COMPENSATION FOR
OPENINGS IN DECK
S.S. 450 x 50' x 34'-6" MOULDED.
Nº 458
SCALE 1/4" INCH = ONE FOOT

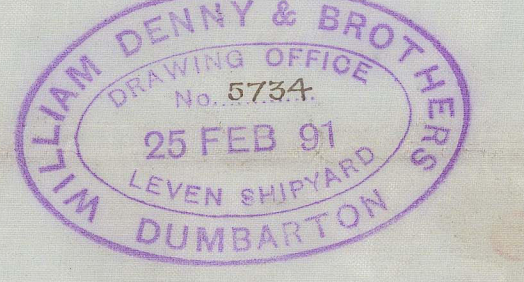


*Hand used in discussion in
with Mr. Connors in London
J.R. 3/3/91*

 

GL5226-0049

S.S. "Ruahine" Glasgow Report No. 11144/-

GLS226-0049

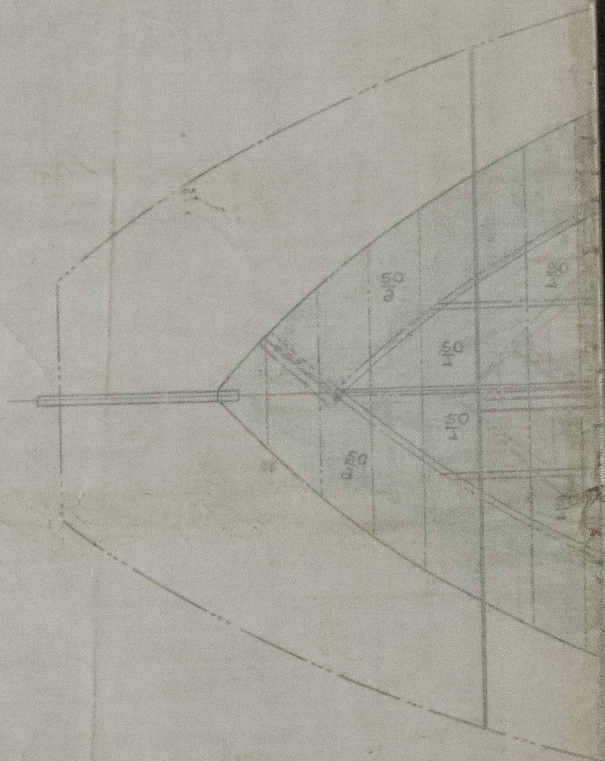

© 2021

Lloyd's Register
Foundation